
PLAT OF SURVEY

OF THE WEST LINES AS SHOWN OF

A part of the Northwest 1/4 and Southwest 1/4 of Section 7 and Northwest 1/4 of Section 18, Town 4 North, Range 15 East, Town of Whitewater, Walworth County, Wisconsin, to-wit: Beginning on the East line of the Rudolph Goessling property as described in Volume 459 Deeds, page 505 at the Southeast comer of Lot 1, Certified Survey Map No. 1099 recorded in Volume 5 of Certified Surveys, pages 107 and 108; thence South 86° 53' 00" West, along the South line of said Lot 1 and its extension, 434.58 feet; thence South 00° 09' 34" East, 464.66 feet; thence South 81° 45' 52" West, 539.31 feet; thence Southerly, parallel to said Rudolph Goessling's East line 4296 feet, more or less to the South line of said Southwest 1/4 of Section 7; thence Easterly along said South line, 541 feet, more or less, to the Northwest comer of that part of Rudolph Goessling's land that lies in said Northwest 1/4 of Section 18; thence Southerly, along said Rudolph Goessling's West line, 463 feet, more or less, to the North line of the Chicago, Milwaukee & St. Paul Railroad; thence Northeasterly, along said North line, 488 feet, more or less to said Rudolph Goessling's East line; thence Northerly, along said East line, 5064.55 feet, more or less, to the point of beginning. EXCEPTING THEREFROM all land as described in an Award of Damages recorded as Document No. 0542772. FURTHER EXCEPTING THEREFROM all of Certified Survey Map No. 3971 recorded in Volume 24 of Certified Survey Maps, Page 227, as Document No. 682433. FURTHER EXCEPTING THEREFROM all of Certified Survey Map No. 4209 recorded in Volume 27 of Certified Survey Maps, Page 1, as Document No. 752038.

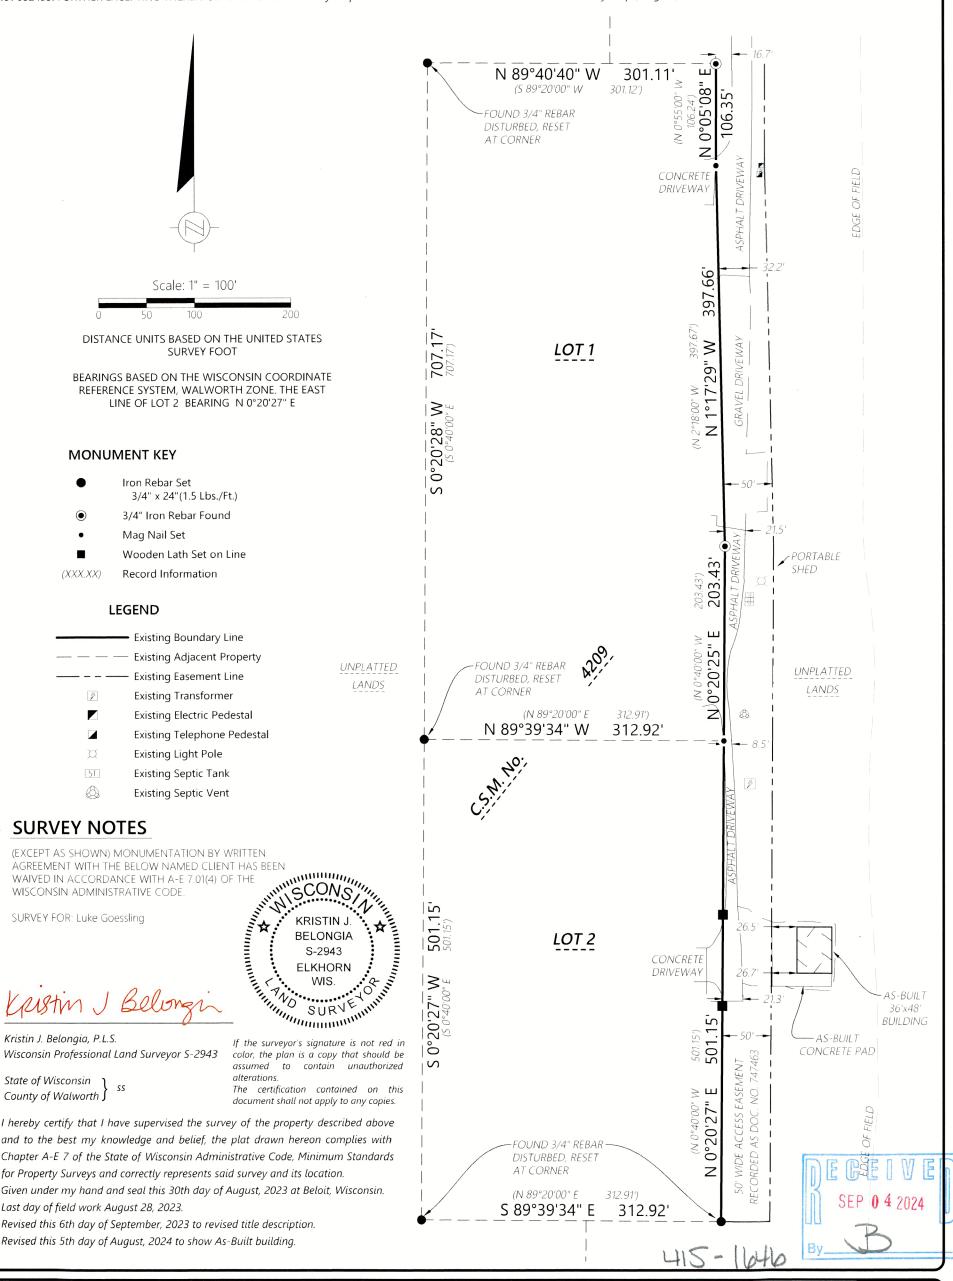

ORDER NO: 34774

FIELD CREW: JAV DRAWN BY: JAV SHEET 1 OF 1 FOR THE EXCLUSIVE USE OF: Luke Goessling W9697 W. Walworth Ave Whitewater, WI 53190

PLAT OF SURVEY

DA4209.2

Batterman

engineers surveyors planners 2857 Bartells Drive 1040 N Wisconsin Street Beloit, Wisconsin 53511 Elkhorn, Wisconsin 53121 608.365.4464 262.379.2250

