


PLAT OF SURVEY
OF LOT 1 OF CERTIFIED SURVEY MAP No. 1902,
BEING PART OF THE SW 1/4 OF THE NW 1/4 OF
SECTION 11, TOWNSHIP 4 NORTH, RANGE 15 EAST,
OF THE 4TH P.M., TOWN OF WHITEWATER,
WALWORTH COUNTY, WISCONSIN.

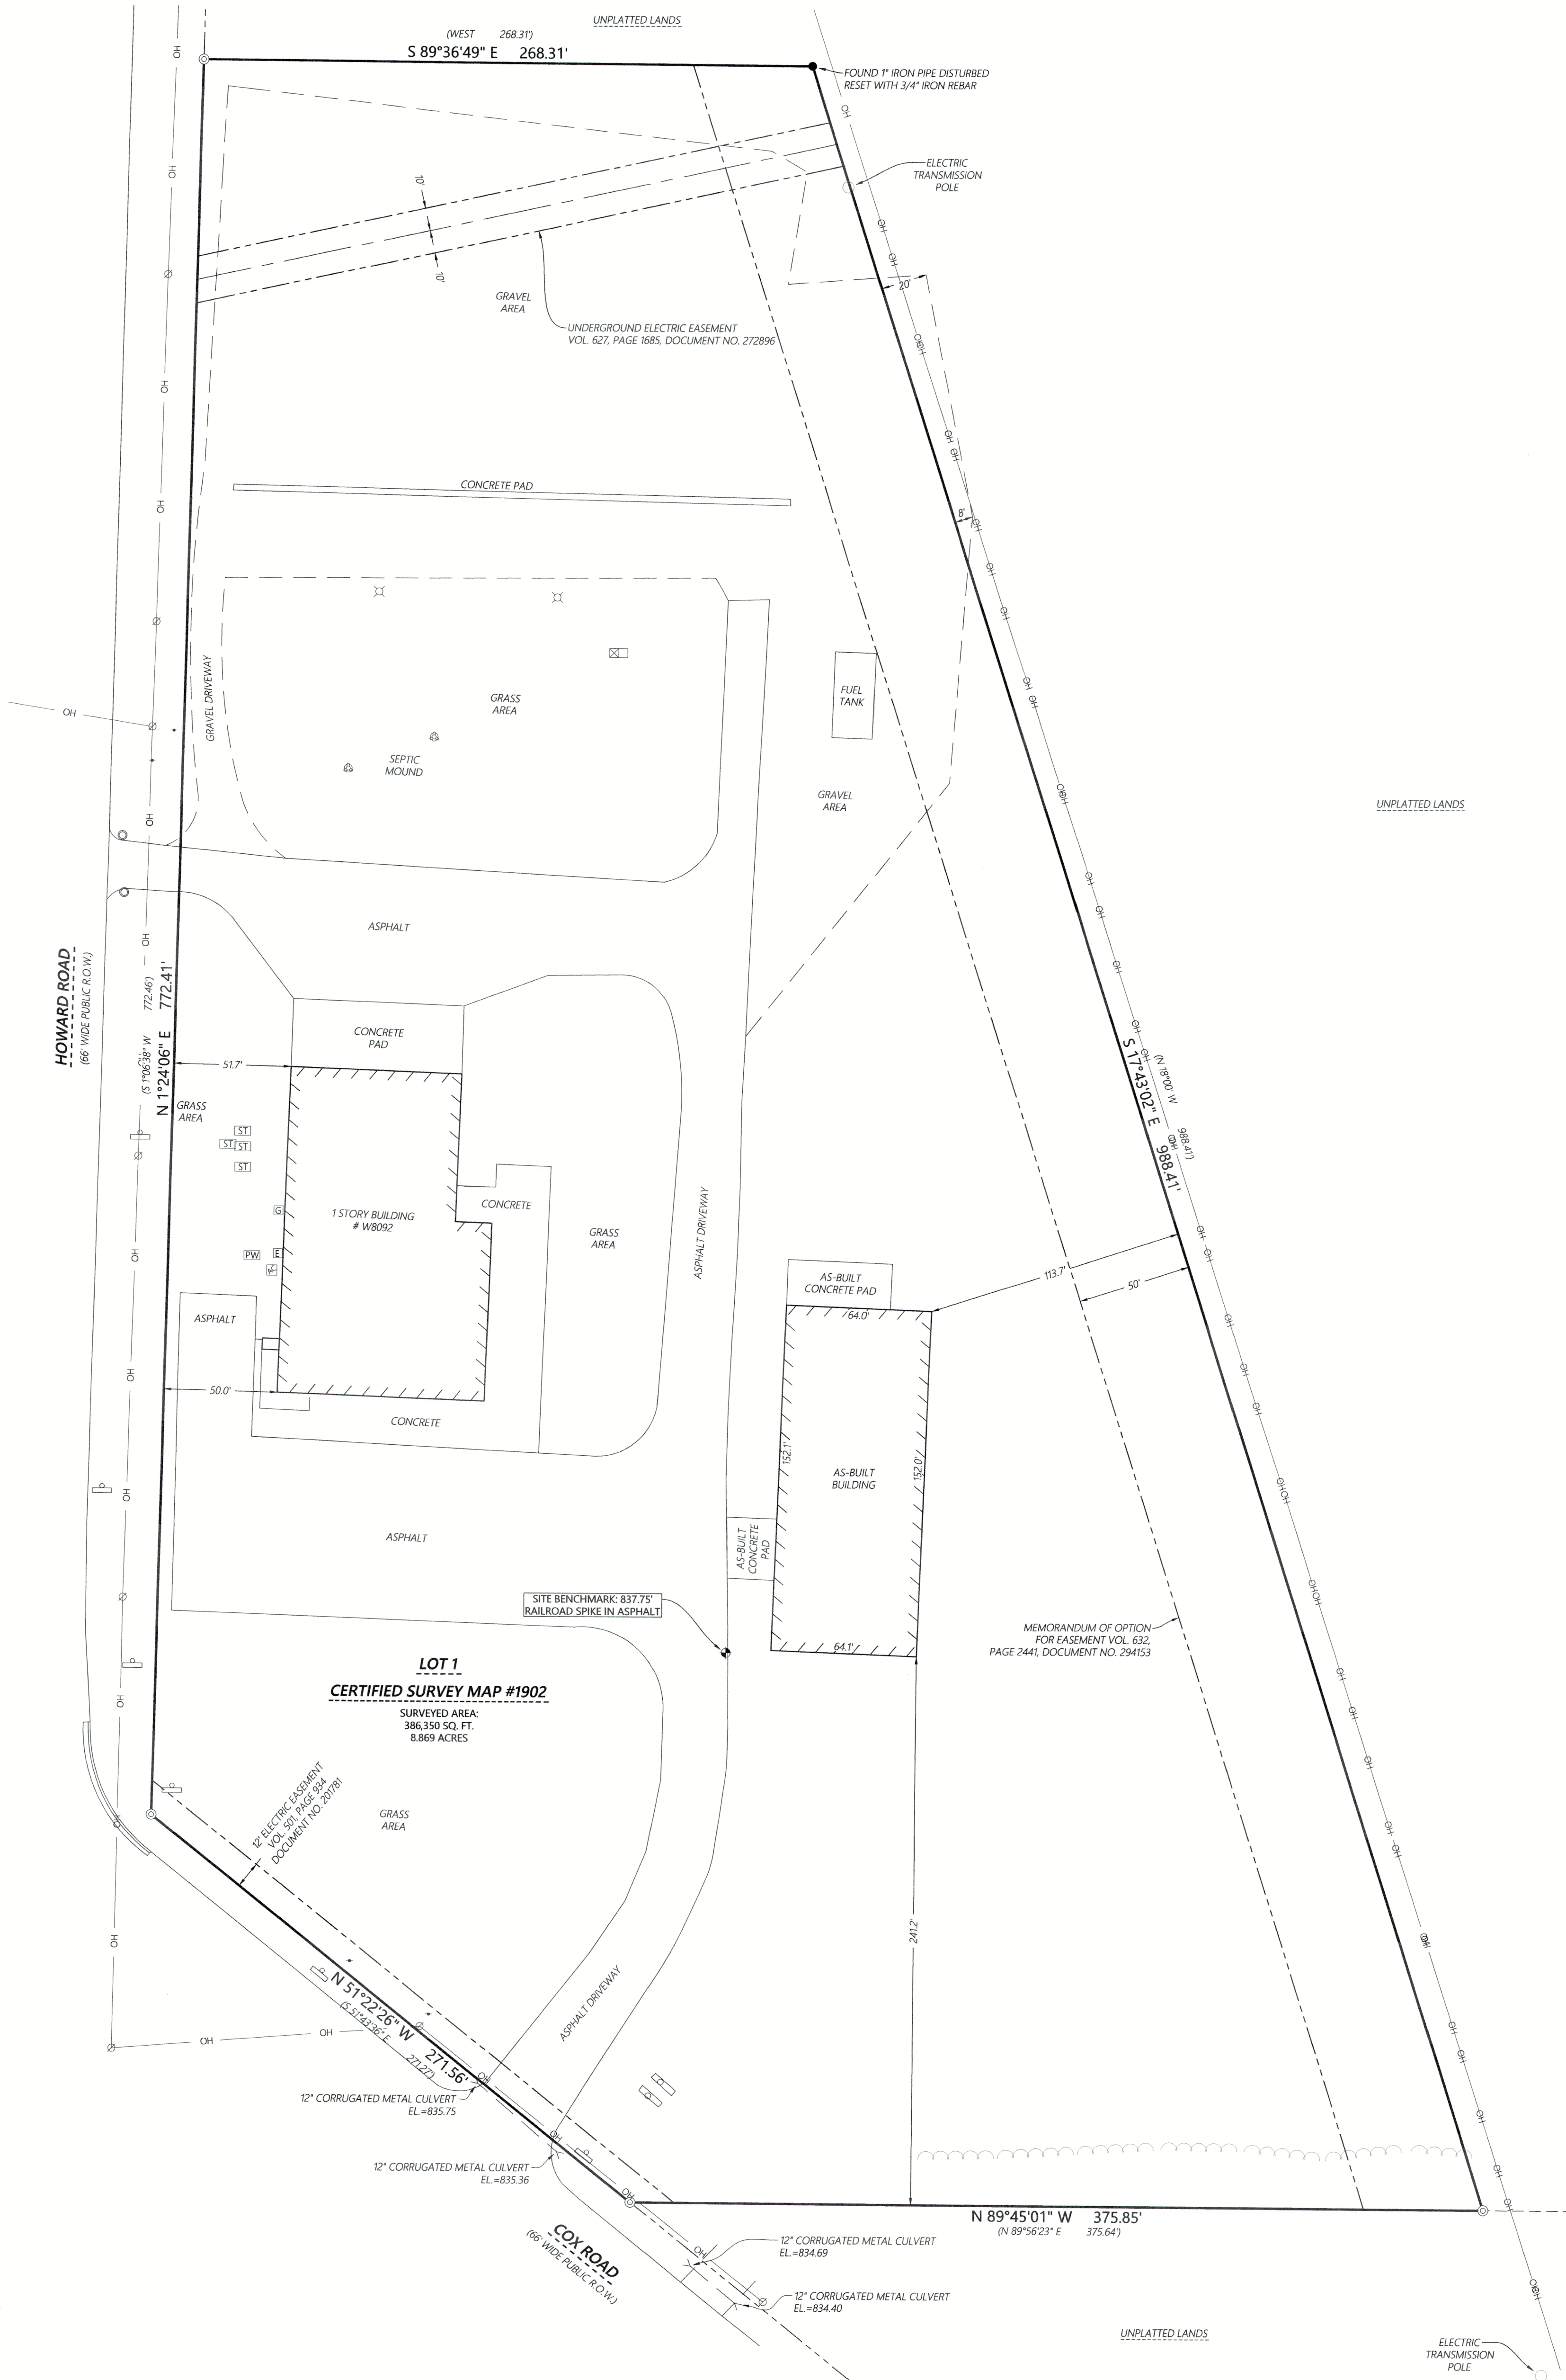

Kristin J. Belongia, P.L.S.
Wisconsin Professional Land Surveyor S-2943

State of Wisconsin } ss
County of Walworth }

I hereby certify that I have supervised the survey of the property described above and to the best of my knowledge and belief, the plat drawn hereon complies with Chapter A-E 7 of the State of Wisconsin Administrative Code, Minimum Standards for Property Surveys and correctly represents said survey and its location.
Given under my hand and seal this 27th day of September, 2023 at Beloit, Wisconsin.
Last day of field work: August 22, 2023
Revised to show As-Built Building August 5th, 2024

If the surveyor's signature is not red in color, the plat is a copy that should be assumed to contain unauthorized alterations. The certification contained on this document shall not apply to any copies.

MONUMENT KEY

- Iron Rebar Set
3/4" x 24" (1.5 Lbs./Ft.)
- Iron Pipe Found
- Benchmark
- Record Information

LEGEND


- Existing Boundary Line
- Existing Right-of-Way
- Existing Adjacent Property
- Existing Easement Line
- Existing Overhead Power
- Existing Electric Meter
- Existing Gas Meter
- Existing Telephone Pedestal
- Existing Utility Cabinet
- Existing Light Pole
- Existing Utility Pole
- Existing Guy Wire
- Existing Well
- Existing Septic Tank
- Existing Septic Vent
- Existing Air Conditioner
- Existing Sign



Scale: 1" = 40'

DISTANCE UNITS BASED ON THE UNITED STATES SURVEY FOOT
BEARINGS BASED ON THE WISCONSIN COORDINATE REFERENCE SYSTEM, WALWORTH ZONE. THE EAST RIGHT-OF-WAY LINE OF HOWARD ROAD BEARING N 1°24'06" E

VERTICAL DATUM BASED ON NAVD-88 (2012)
GEOID 18 WISCONSIN
STARTING BENCHMARK: NGS MONUMENT
PID: DF9995
PUBLISHED ELEVATION: 844.16

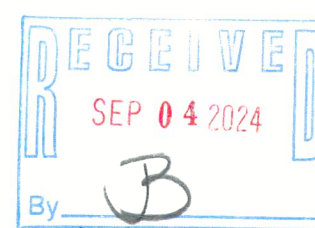

ORDER NO: 34753

FIELD CREW: BMR
DRAWN BY: BMR
SHEET 1 OF 1

FOR THE EXCLUSIVE USE OF:

Robin Seamars
W8092 Cox Road
Whitewater, WI 53190

PLAT OF SURVEY
FOR
ROBIN'S TRUCKING
WHITEWATER, WISCONSIN

DA-1922-1

Batterman
engineers surveyors planners

2857 Bartells Drive
Beloit, Wisconsin 53511
608.365.4464

1040 N Wisconsin Street
Elkhorn, Wisconsin 53121
262.379.2250
www.rhbatterman.com

