LAND-MARK SURVEYING

Mark L. Miritz


Wisconsin Professional Land Surveyor S-2582

N9330 Knuteson Drive Whitewater, WI 53190 Phone:(262)949-1239 MARKMIRITZ@ LAND-MARKSURVEYING.COM

PLAT OF SURVEY

LOT 8, LOT 9 AND LOT 10, BLOCK 2, GRAND VIEW SUBDIVISION, LOCATED IN THE SOUTHEAST 1/4 OF SECTION 34, TOWN 4 NORTH, RANGE 15 EAST, WHITEWATER TOWNSHIP, WALWORTH COUNTY, WISCONSIN.

OWNER: PURA VIDA PROPERTIES LLC N7413 GRAND VIEW DRIVE WHITEWATER, WI 53190

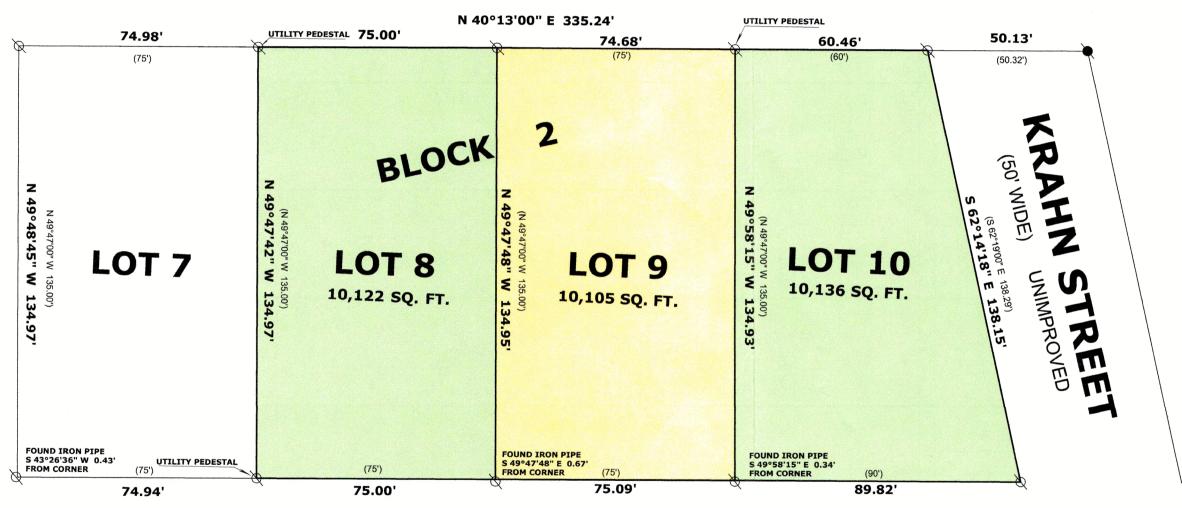

S 40°12'30" W 314.85' (S 40°13'00" W)

VERN STREET A.K.A. GRAND VIEW DRIVE

(66' WIDE)



LEGEND

F

FOUND IRON PIPE

€

FOUND IRON ROD

(xx)

RECORDED AS DIMENSION

SCALE: 1 INCH = 30 FEET

"I hereby certify that the above described property has been surveyed by me or under my direction and that the above map is a true representation thereof and shows the size and location of the property, its exterior boundaries, the location of all visible structures and dimensions of all principal buildings thereon, boundary fences, apparent easements, roadways and visible encroachments, if any."
"This survey is made for the use of the present owners of the present owners of the present owners."

"This survey is made for the use of the present owners or the property, and also those who purchase, mortgage, or guarantee the title thereto within one year from date

MARK L. MIRITZ
WISCONSIN PROFESSIONAL
LAND SURVEYOR S-2582

DATE: OCT. 26, 2024 JOB NO. 24.1001

DGD 16, 17, 18

415-1670