

PLAT OF SURVEY

DESCRIPTION


Lot 19, Block 1, MORaine HEIGHTS, in Section 35, T1N, R15E, Town of Whitewater, Walworth County, Wisconsin.

CERTIFICATION

I hereby certify that the property described above has been surveyed under my responsible direction and supervision and that this map is a correct representation of the lot lines and dimensions and the principle lines of the permanent structures thereon.

Date 10-12-77

Prepared for: Mr. Rob Huber
Route 2
Fort Atkinson, WI

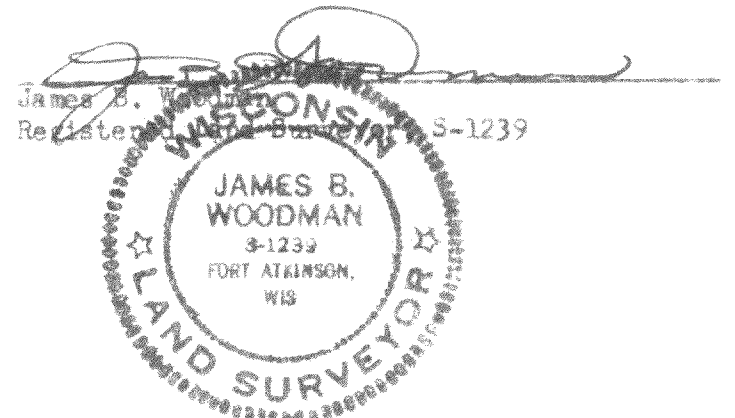

DMA-19

STRAND, WOODMAN & ASSOC.

Land Surveyors - Engineers
89 North Main Street
Fort Atkinson, Wisconsin 53538

DRN	RAB	Date	10-10-77	JN 773-167
DRN	JNO	Date	10-11-77	
CHK	JRW	Date	10-11-77	SCALE 1" = 10'

415-186