


MORTGAGE INSPECTION

SCALE - 1" = 50'

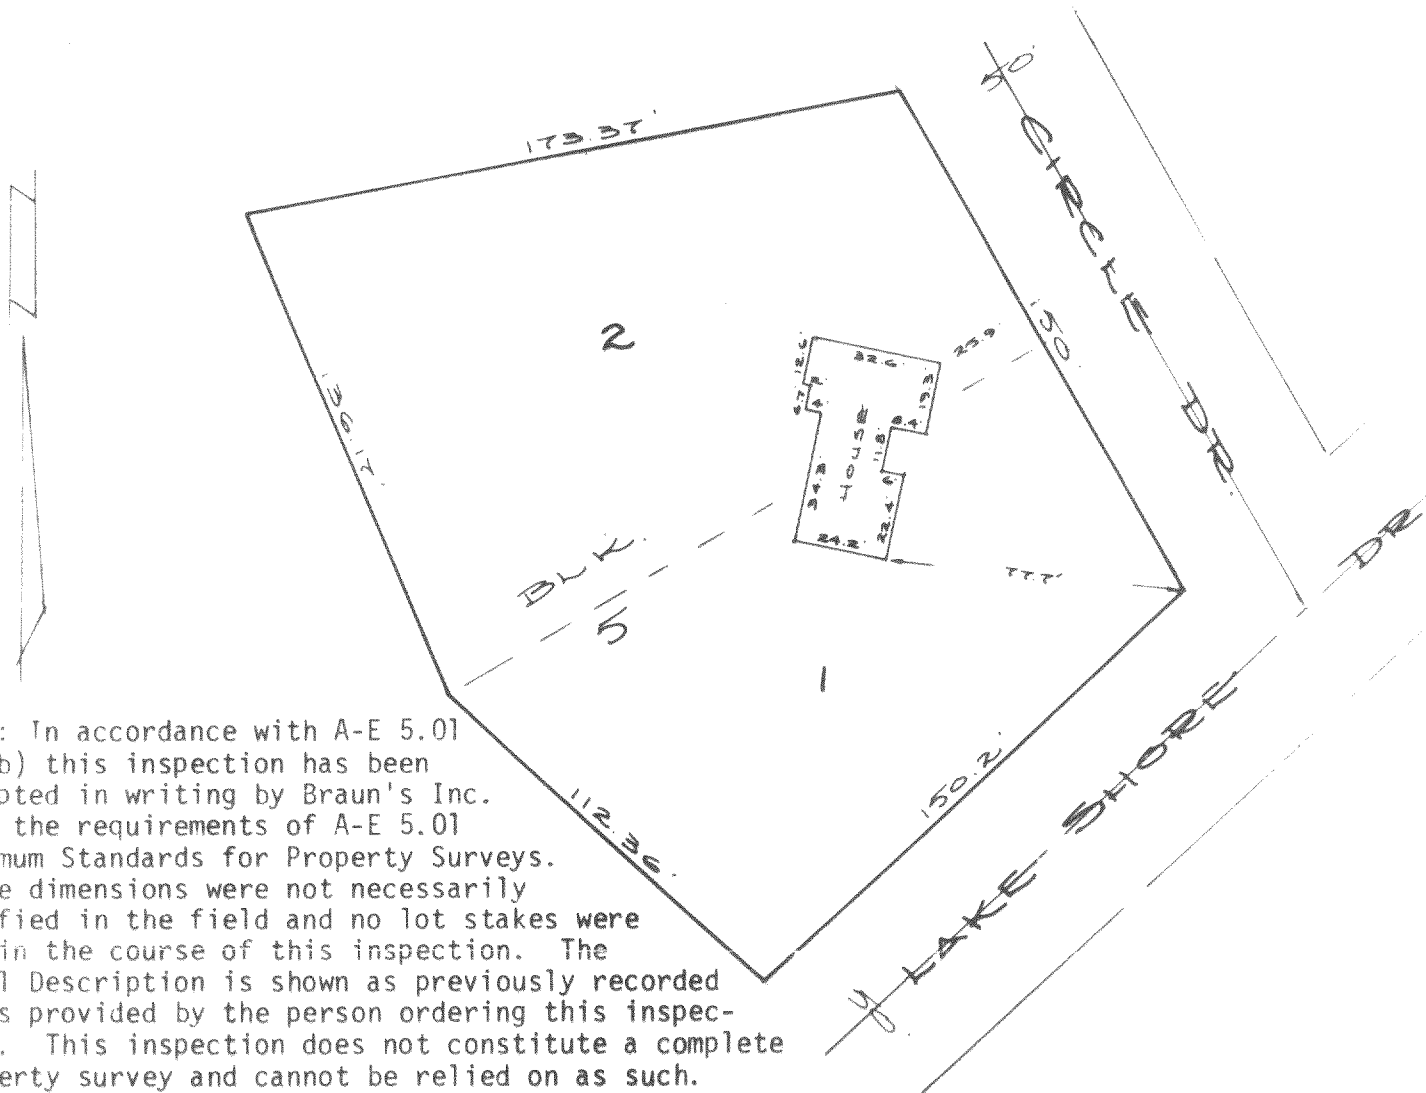

NOTE: In accordance with A-E 5.01 (1)(b) this inspection has been exempted in writing by Braun's Inc. from the requirements of A-E 5.01 Minimum Standards for Property Surveys. These dimensions were not necessarily verified in the field and no lot stakes were set in the course of this inspection. The Legal Description is shown as previously recorded or as provided by the person ordering this inspection. This inspection does not constitute a complete property survey and cannot be relied on as such.

DESCRIPTION

Lots 1 and 2, Block 5, MORaine PARK in Section 34, T4N, R15E, Town of Whitewater, Walworth County, Wisconsin.

CERTIFICATION


I certify that the property described above has been inspected under my responsible direction and supervision and that the above map is an accurate representation of the size and location of the property and the location and dimensions of all visible structural improvements, if any.

This inspection is made for the exclusive use of the present owners of the property and also those who purchase, mortgage or guarantee the title thereto and is certified for one year from date hereto.

Date 2-22-87

James B. Woodman  
Registered Land Surveyor, S-1239

Prepared for: Brauns Inc. of Jefferson  
405 South Main Street  
Jefferson, WI 53549

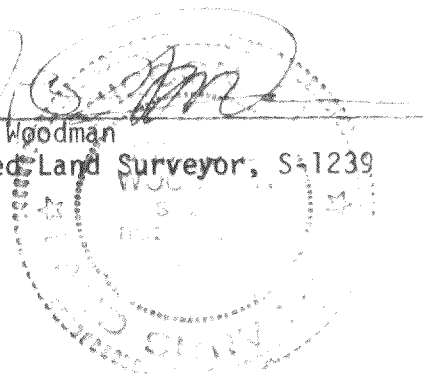

DMP-42,43

Sheet 1 of 1

JN 87S-9