## **ABERNATHY and ASSOCIATES**

Kenneth B. Abernathy Jr.

Wisconsin Registered Land Surveyor


Rt. 3, Box 273

Elkhorn, Wisconsin 53121 Phone: (414) 723-4260 (office)

(414) 723-4813 (residence)

## PLAT OF SURVEY

LOT IO OF BAY VIEW ESTATES, LOCATED IN GOVERNMENT LOTS 182, IN THE SE 1/4 OF SECTION 26, T4N, R15E, COUNTY OF WALWORTH, STATE OF WISCONSIN.

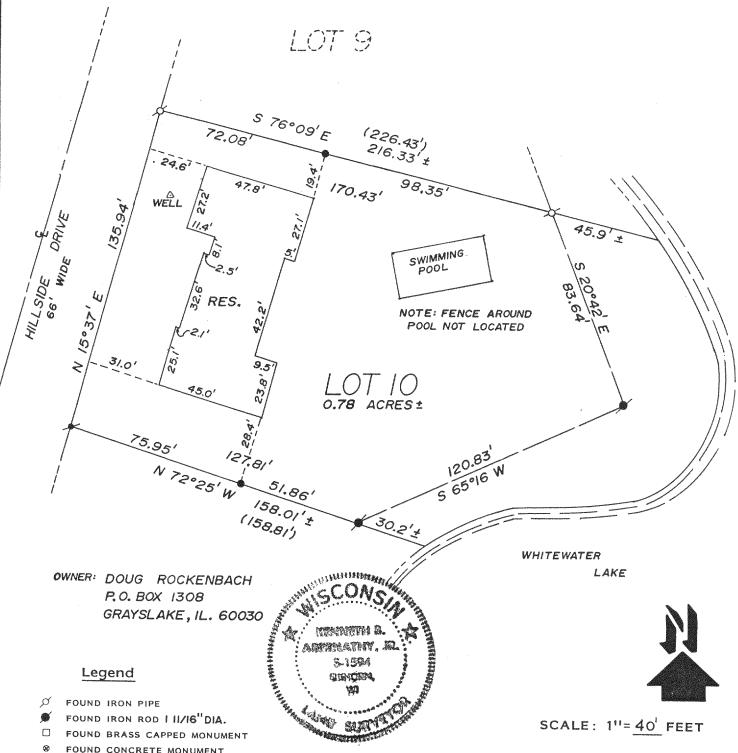

FOUND CONCRETE MONUMENT

CHISEL CUT IN CONCRETE


SET IRON ROD, 24" LONG, WEIGHING 1.5 LBS./LINEAL FT., 3/4" DIA.

SET IRON ROD, 30" LONG, WEIGHING 4.5 LBS./LINEAL FT., 1-11/16" DIA.

(xx) RECORDED AS DIMENSION

EXISTING FENCE

FOUND IRON ROD 1/2" DIA.

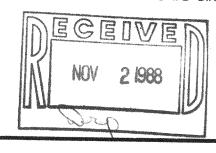

"I hereby certify that I have surveyed the above described property and that the above map is a true representation thereof and shows the size and location of the property, its exterior boundaries, the location of all visible structures and dimensions of all principal buildings thereon, boundary fences, apparent easements, roadways and visible encroachments, if any."

"This survey is made for the use of the present owners of the property, and also those who purchase, mortgage, or guarantee the title thereto within one year from date hereof."

KENNETH B. ABERNATHY, JR.

WISCONSIN REGISTERED LAND SURVEYOR, S-1594

Date: 8/17/88 \_ Job No. 88-406 415-299