



Route 4 Box 508B
Elkhorn WI 53121
Phone-414-723-6265

DEERWOOD DRIVE

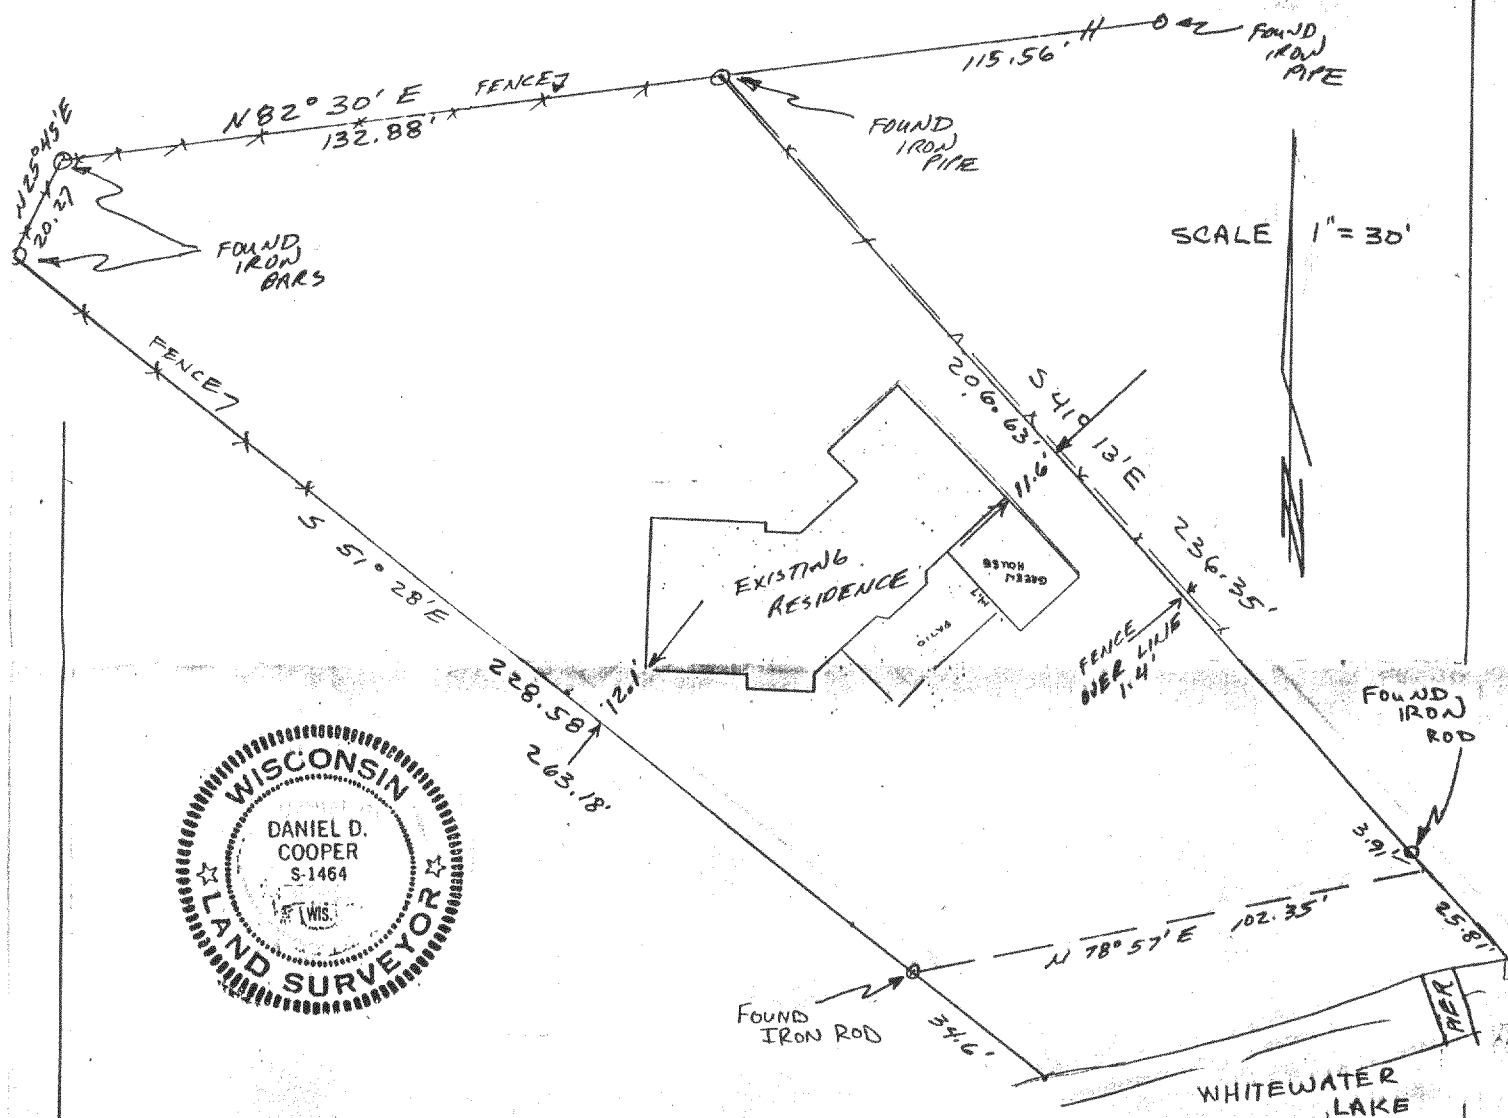

Daniel D. Cooper, RLS NO: S-1464

DRAWING NO-3652-6-26

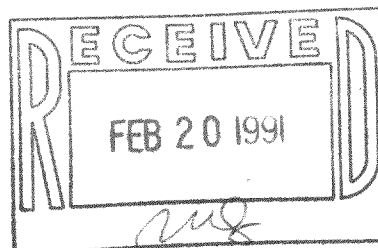

Reduced

TAX KEY # DIVE 00006

415-317