## Plat Survey o f


Lot 6, Block 2 of Gutzmer's Subdivision, located in the Southwest 1/4 of Section 25, Town 4 North, Range 15 East, Town of Whitewater, Walworth County, Wisconsin.

Surveyed for: Tincher Realty

514 West Main Street

Whitewater, Wisconsin. 53190

Bearings referenced to the Subdivision Plat.

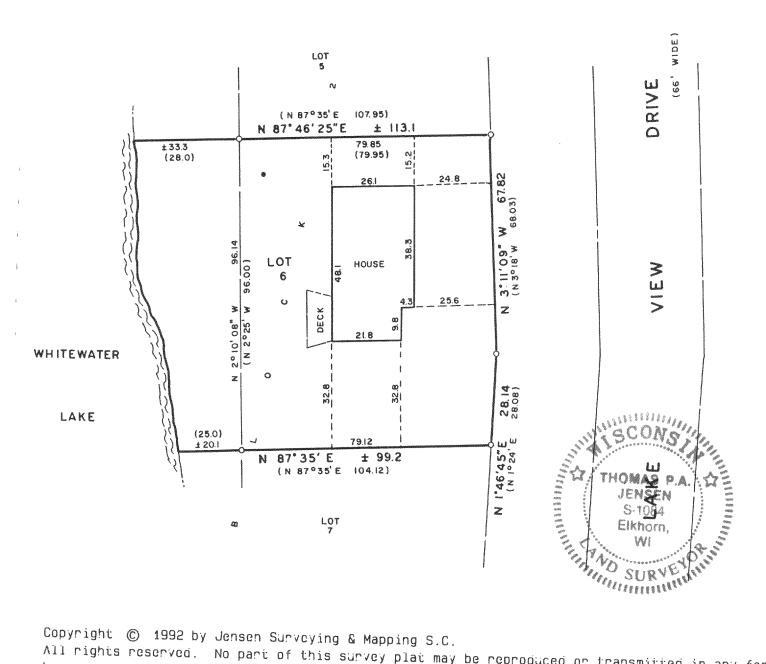

Copyright © 1992 by Jensen Surveying & Mapping S.C. All rights reserved. No part of this survey plat may be reproduced or transmitted in any form by any means - graphic, electronic, or mechanical, including photocopying, tracing, or information storage and retrieval systems - without permission in writing from Thomas P.A. Jensen.

I. Thomas P.A. Jensen, Wisconsin Registered Land Surveyor, do hereby certify that this survey was performed by me, or under my direction, in full compliance with the owner's/agent's instructions and Chapter A-E 7 of the Wisconsin Administrative Code ' Minimum Standards For Property Surveys ', and that this map is an accurate representation thereof to the best of my knowledge and belief.

Note: This survey plat is not certified unless signed and sealed in red ink.

Legend

≀>~ Recorded as dimension

o ~ Found iron pipe

• ~Septic vent

Thomas P.A. Jénsen R.L.S. 1084

Jensen Surveying & Mapping S.C.

HEB | 0 1993

45 South Wisconsin Street P.O. Box 322 Elkhorn, Wisconsin. 53121.

(414) 723-3434

Mapping date: February 11, 1992 Revisions:

415-367

Scale: 1 = 30'30 60 Sheet 1 of 1 Sheets

Job reference number: 1992.024

DGS-15