


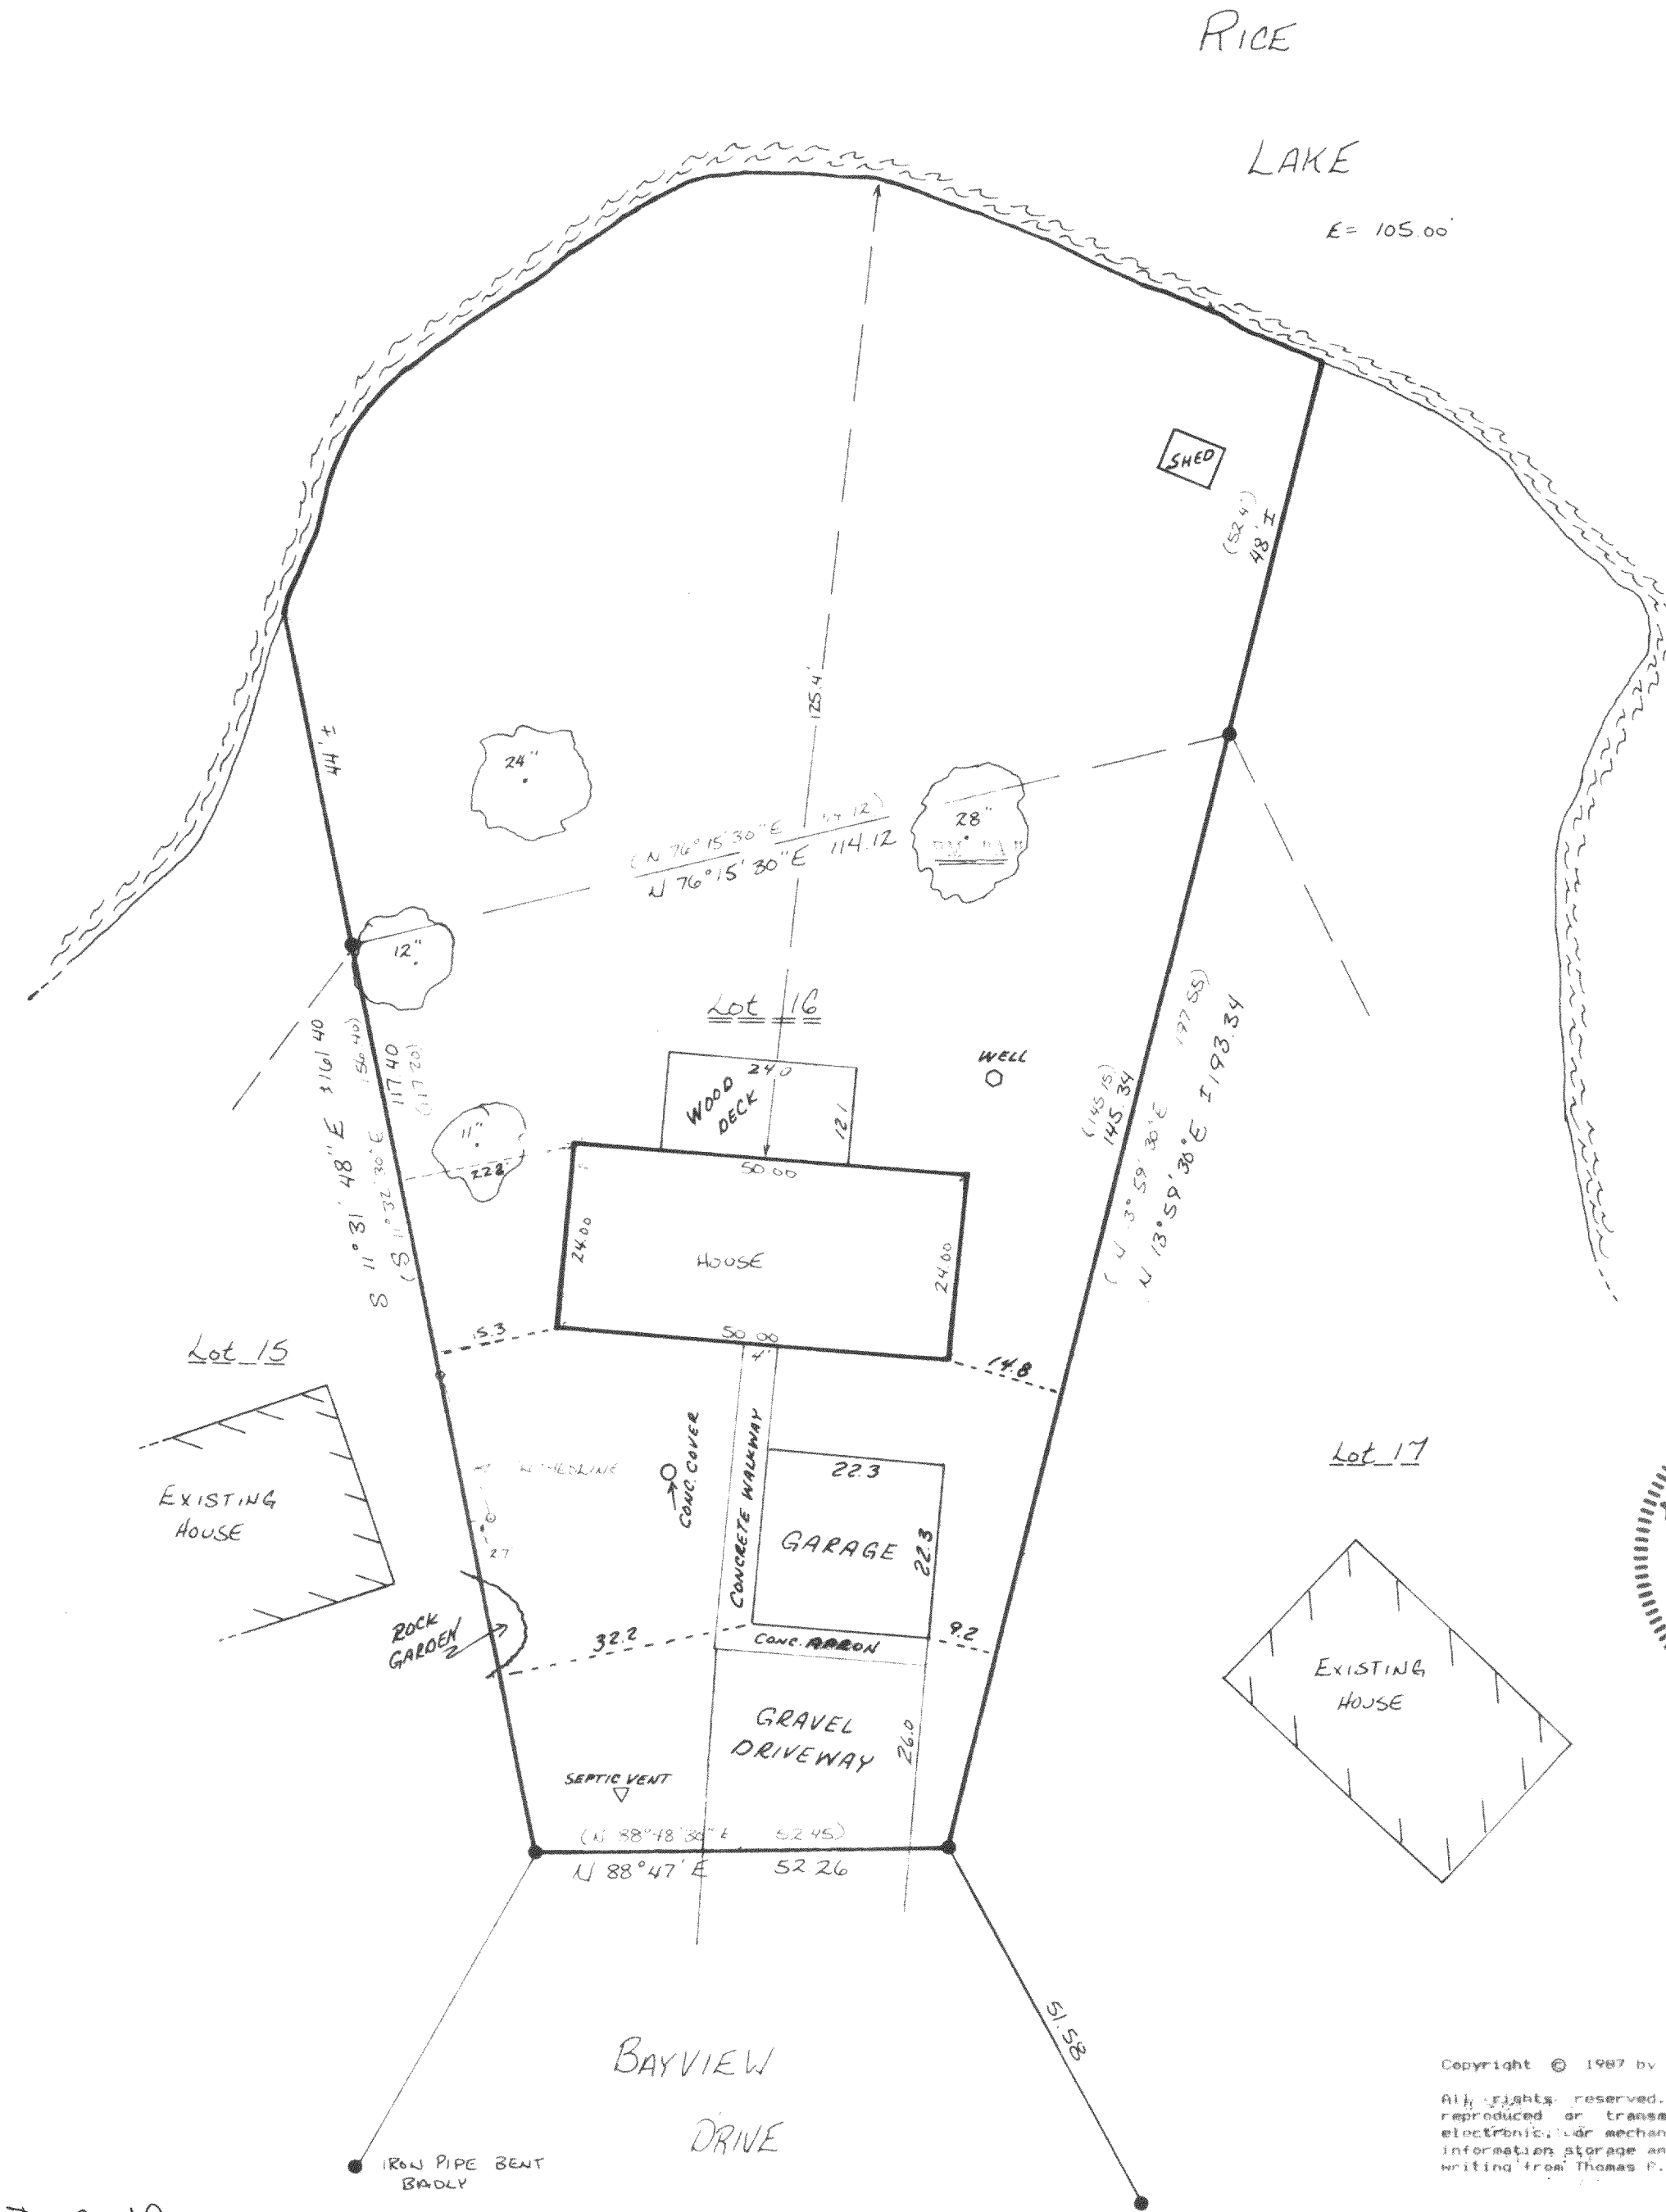

PLAT OF SURVEY
 Lot 16, Block 2, Subdivision, located in the Southeast 1/4 of Section 27, the Northwest 1/4 of Section 26, and the Northeast 1/4 of Section 24, Town 4 North, Range 15 East, Town of Whitefish, Walworth County, Wisconsin.

Surveyed for: Daniel, Inc.
 4024 Glen Elora Dr.
 Greendale, WI 53120

Surveyed by: Jensen Surveying & Mapping S.C.
 4500 Wisconsin St., P.O. Box 332
 Elkhorn, Wisconsin 53121

Drawing Date: April 3, 1993.

Survey staked and elevations taken: April 3, 1993.

REVISED: 8-19-93

FOR CENTURY 21 REALTY

Elevations at proposed house corners.

- ① - 111.1
- ② - 111.1
- ③ - 111.1
- ④ - 111.2

SCALE: 1"=20'

LEGEND

- - Found iron pipe
- ▲ - Set spike
- - Set wood stake, --- 5' Offset
- () - Recorded as dimension.

Elevations referenced to the water level of Rice Lake on April 3, 1993. Assumed as 115.00.

Benchmark "A" - Railroad spike set in the East face of a 24" tree.
 Elevation - 111.00

Bearings referenced to the Subdivision Plat.

Project: P-1

I, Thomas P.A. Jensen, Wisconsin Registered Land Surveyor, do hereby certify that this survey was performed by me, or under my direction, in full compliance with the owner's/agent's instructions and Chapter A-E 5 of the Wisconsin Administrative Code "Minimum Standards For Property Surveys"; and that this map is an accurate representation thereof to the best of my knowledge and belief.

Thomas P.A. Jensen
 Thomas P.A. Jensen R.L.S-1084
 Jensen Surveying & Mapping S.C.

Copyright © 1987 by Jensen Surveying & Mapping S.C.

All rights reserved. No part of this survey plat may be reproduced or transmitted in any form by any means - graphic, electronic, or mechanical, including photocopying, tracing, or information storage and retrieval systems - without permission in writing from Thomas P.A. Jensen, Jensen Surveying & Mapping S.C.

1987.020 X
 1993.089

415-411

DLS-19