
ABERNATHY and ASSOCIATES Kenneth B. Abernathy Jr.

Wisconsin Registered Land Surveyor S-1594

Rt. 3, Box 273 Elkhorn, Wisconsin 53121 Phone: (414) 723-4260 (office) (414) 723-4813 (residence)

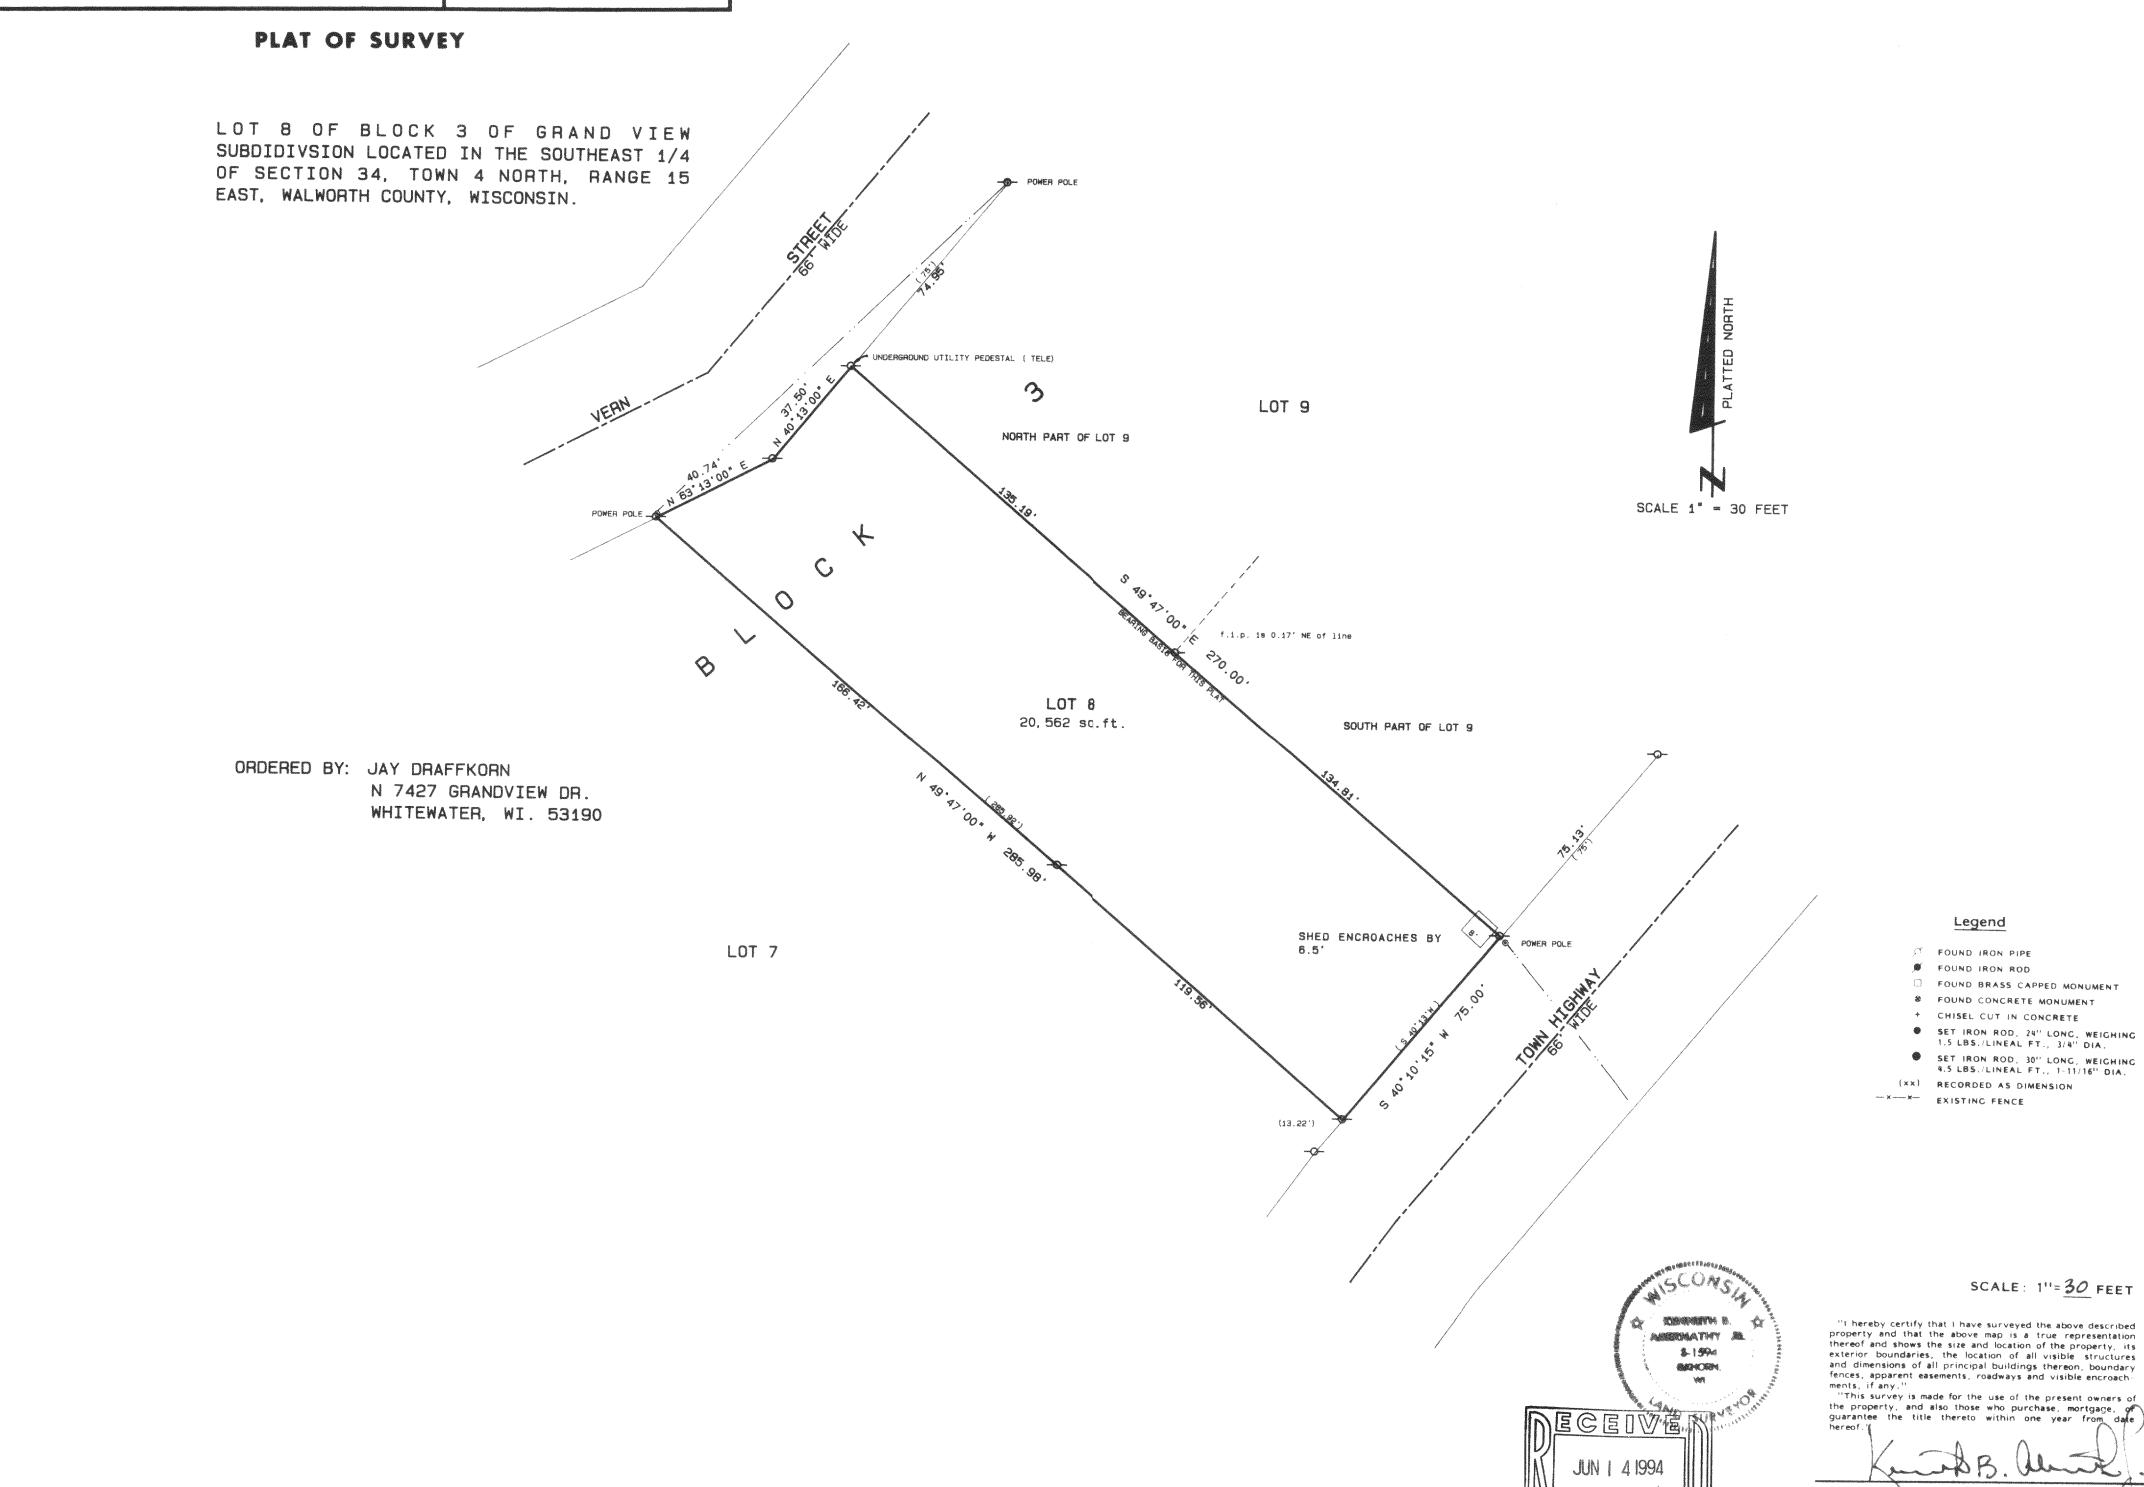

S-1594

Job No. 94.416

KENNETH B. ABERNATHY, JR.

Date: 4 15 94

WISCONSIN REGISTERED LAND SURVEYOR,