
FARRIS, HANSEN & ASSOCIATES, INC. ENGINEERING, ARCHITECTURE, SURVEYING

7 RIDGEWAY COURT - P. O. BOX 437, ELKHORN, WISCONSIN 53121 PHONE: (414) 723-2098 FAX: (414) 723-5886

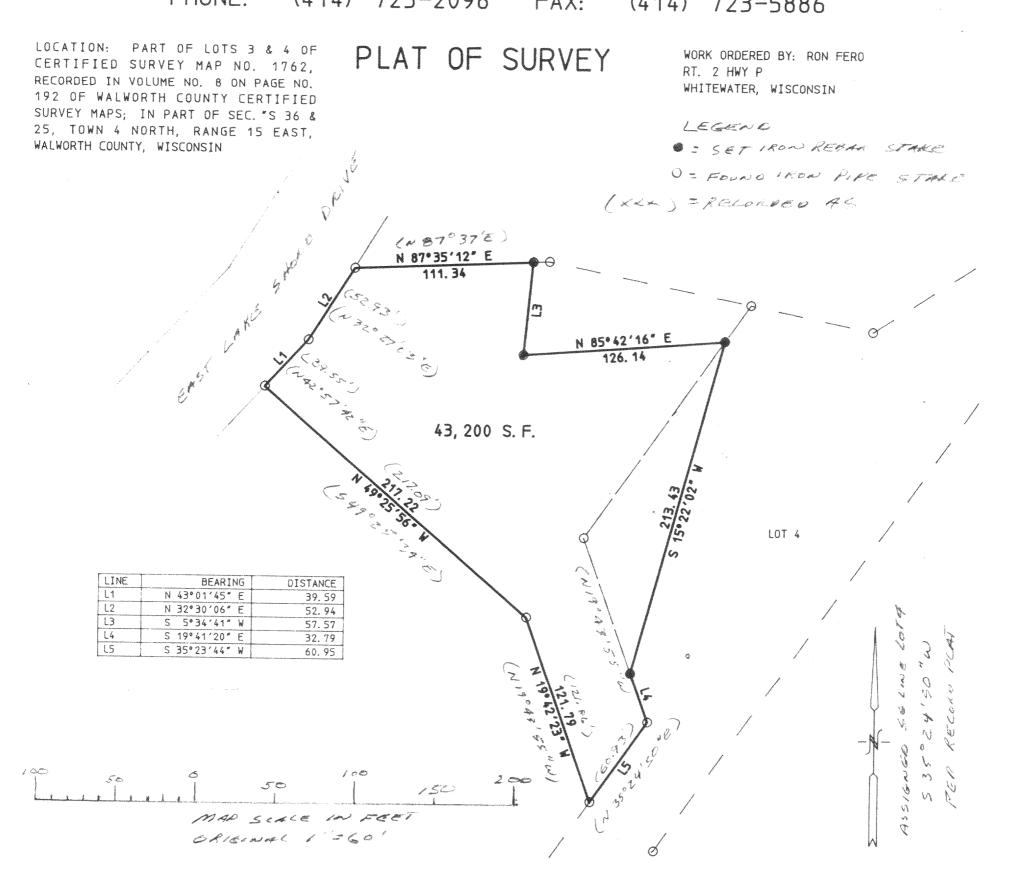

LEGAL DESCRIPTION REVISED LOT 3

A PARCEL OF LAND LOCATED IN PART OF LOTS 3 AND 4 OF CERTIFIED SURVEY MAP NO. 1762, RECORDED IN VOLUME NO. 8 ON PAGE 192 OF WALWORTH COUNTY CERTIFIED SURVEY MAPS SAID PARCEL BEING DESCRIBED AS:

BEGINNING AT AN IRON PIPE STAKE MARKING THE MOST SOUTHERLY CORNER OF SAID LOT 3; THENCE N 19DEG 42MIN 23SEC W, 121.79 FEET TO AN IRON PIPE STAKE; THENCE N 45DEG 25MIN 56SEC W, 217.22 FEET TO AN IRON PIPE STAKE MARKING THE EASTERLY LINE OF EAST LAKESHORE DRIVE; THENCE ALONG SAID DRIVE, N 43DEG 01MIN 45SEC E, 39.59 FEET TO AN IRON PIPE STAKE; THENCE CONTINUE ALONG SAID DRIVE, N 32DEG 30MIN 06SEC E, 52.94 FEET TO AN IRON PIPE STAKE; THENCE N 87DEG 35MIN 12SEC E, 111.34 FEET ALONG THE SOUTH LINE OF LOT 8 OF MORNINGSIDE HEIGHTS; THENCE S 05DEG 34MIN 41SEC W, 57.57 FEET; THENCE N 85DEG 42MIN 16SEC E, 126.14 FEET; THENCE S 15DEG 22MIN 02SEC W, 213.43 FEET; THENCE S 19DEG 42MIN 31SEC E, 32.79 FEET TO AN IRON PIPE STAKE; THENCE S 35DEG 23MIN 44SEC W, 60.95 FEET TO THE POINT OF BEGINNING. CONTAINING 43, 204 SQUARE FEET OF LAND (0.99 ACRES) MORE OR LESS.

NOTE: COPIES OF THIS MAP TO WHICH THE FOLLOWING CERTIFICATE WILL APPLY ARE BLUE LINE PRINTS SHOWING SURVEYOR'S ORIGINAL SEAL AND SIGNATURE IN BLACK INK. COPIES BY ANY OTHER MEANS MAY HAVE ALTERATIONS WHICH DO NOT REPRESENT THE SURVEYOR'S WORK PRODUCT.


I HEREBY CERTIFY THAT THE ABOVE DESCRIBED PROPERTY HAS BEEN SURVEYED UNDER MY DIRECTION AND THAT THE ABOVE MAP IS A TRUE REPRESENTATION THEREOF AND SHOWS THE SIZE AND LOCATION OF THE PROPERTY AND ITS EXTERIOR BOUNDARIES. THIS SURVEY IS MADE FOR THE USE OF THE PRESENT OWNERS OF THE PROPERTY, AND ALSO THOSE WHO PURCHASE, MORTGAGE, OR GUARANTEE THE TITLE THERETO WITHIN ONE YEAR FROM THE DATE HEREOF.

DATED: 5/10/1994

The Hollow



PROJ 4045 DATED 05-10-1994

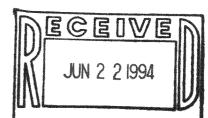

45-442

FARRIS, HANSEN & ASSOCIATES, INC.

PHONE: (414) 723-2098 FAX: (414) 723-5886

ENGINEERING, ARCHITECTURE, SURVEYING
7 RIDGEWAY COURT - P. O. BOX 437, ELKHORN, WISCONSIN 53121

PLAT OF SURVEY WORK ORDERED BY: RON FERO LOCATION: PART OF LOTS 3 & 4 OF RT. 2 HWY P CERTIFIED SURVEY MAP NO. 1762. WHITEWATER, WISCONSIN RECORDED IN VOLUME NO. 8 ON PAGE NO. 192 OF WALWORTH COUNTY CERTIFIED SURVEY MAPS; IN PART OF SEC. "S 36 & LEGENO 25, TOWN 4 NORTH, RANGE 15 EAST, . SET IRON REBAR STAKE WALWORTH COUNTY, WISCONSIN O = FOUND IRON PIPE STAKE /xxx = RELORVED AS (~87°37'E) N 87°35'12" E N 85° 42'16" E 126.14 LOT 4 BM TOPIP CL. = 100 BEARING DISTANCE N 43°01'45" E 39.59 N 32°30'06" E 52.94 L2 S 5°34'41" W L3 57.57 S 19°41'20" E 32.79 L4 S 35°23'44" W 60. 95

LEGAL DESCRIPTION REVISED LOT 3

ORIGINAL 1'560

A PARCEL OF LAND LOCATED IN PART OF LOTS 3 AND 4 OF CERTIFIED SURVEY MAP NO. 1762, RECORDED IN VOLUME NO. 8 ON PAGE 192 OF WALWORTH COUNTY CERTIFIED SURVEY MAPS SAID PARCEL BEING DESCRIBED AS:

BEGINNING AT AN IRON PIPE STAKE MARKING THE MOST SOUTHERLY CORNER OF SAID LOT 3; THENCE N 19DEG 42MIN 23SEC W, 121.79 FEET TO AN IRON PIPE STAKE; THENCE N 45DEG 25MIN 56SEC W, 217.22 FEET TO AN IRON PIPE STAKE MARKING THE EASTERLY LINE OF EAST LAKESHORE DRIVE; THENCE ALONG SAID DRIVE, N 43DEG 01MIN 45SEC E, 39.59 FEET TO AN IRON PIPE STAKE; THENCE CONTINUE ALONG SAID DRIVE, N 32DEG 30MIN 06SEC E, 52.94 FEET TO AN IRON PIPE STAKE; THENCE N 87DEG 35MIN 12SEC E, 111.34 FEET ALONG THE SOUTH LINE OF LOT 8 OF MORNINGSIDE HEIGHTS; THENCE S 05DEG 34MIN 41SEC W, 57.57 FEET; THENCE N 85DEG 42MIN 16SEC E, 126.14 FEET; THENCE S 15DEG 22MIN 02SEC W, 213.43 FEET; THENCE S 19DEG 42MIN 31SEC E, 32.79 FEET TO AN IRON PIPE STAKE; THENCE S 35DEG 23MIN 44SEC W, 60.95 FEET TO THE POINT OF BEGINNING. CONTAINING 43, 204 SQUARE FEET OF LAND (0.99 ACRES) MORE OR LESS.

NOTE: COPIES OF THIS MAP TO WHICH THE FOLLOWING CERTIFICATE WILL APPLY ARE BLUE LINE PRINTS SHOWING SURVEYOR'S ORIGINAL SEAL AND SIGNATURE IN BLACK INK. COPIES BY ANY OTHER MEANS MAY HAVE ALTERATIONS WHICH DO NOT REPRESENT THE SURVEYOR'S WORK PRODUCT.

I HEREBY CERTIFY THAT THE ABOVE DESCRIBED PROPERTY HAS BEEN SURVEYED UNDER MY DIRECTION AND THAT THE ABOVE MAP IS A TRUE REPRESENTATION THEREOF AND SHOWS THE SIZE AND LOCATION OF THE PROPERTY AND ITS EXTERIOR BOUNDARIES. THIS SURVEY IS MADE FOR THE USE OF THE PRESENT OWNERS OF THE PROPERTY, AND ALSO THOSE WHO PURCHASE, MORTGAGE, OR GUARANTEE THE TITLE THERETO WITHIN ONE YEAR FROM THE DATE HEREOF.

PREVISED 06/06/94 TO SHOW LOCATIONS
OF PROPOSED RESIDENCE

DECEIVE Jun 2 2 1994 PROJ 4045 DATED 05-10-1994