

ABELL
SURVEYING & MAPPING
DELAVAN, WISCONSIN 53115
414-728-6737

ORDERED BY: JANE MALAPANES
228 S. PRAIRIE AVENUE
ARLINGTON HEIGHTS, IL 60005

N



SCALE 1"=30'

LEGEND

- - IRON PIPE FOUND
- - IRON ROD FOUND
- △ - UTILITY POLE
- - GUY WIRE
- - OVERHEAD UTILITY LINE
- - UTILITY PED.
- * - WIRE CABLE FENCE
- CS - CONCRETE STOOP
- BE - BASEMENT ENTRY
- () - RECORDED AS

LOT 9

NOTE: BEARINGS ARE REFERENCED TO THE
RECORDED SUBDIVISION PLAT.

LOT 10

LOT 11

PLAT OF SURVEY OF

LOT 10, BLOCK 2, LUDTKE SUBDIVISION,
LOCATED IN T4N, R15E, WALWORTH
COUNTY, WISCONSIN.

I HEREBY CERTIFY THAT I HAVE SURVEYED THE ABOVE DESCRIBED PROPERTY AND THAT THE
ABOVE MAP IS A TRUE REPRESENTATION THEREOF AND SHOWS THE SIZE AND LOCATION OF
THE PROPERTY, ITS EXTERIOR BOUNDARIES, THE LOCATION OF ALL VISIBLE STRUCTURES
AND DIMENSIONS OF ALL PRINCIPAL BUILDINGS THEREON, BOUNDARY FENCES, APPARENT
EASEMENTS, ROADWAYS AND VISIBLE ENCROACHMENTS, IF ANY, TO THE BEST OF MY
KNOWLEDGE AND BELIEF.


THIS SURVEY IS MADE FOR THE USE OF THE PRESENT OWNERS OF THE PROPERTY, AND ALSO
THOSE WHO PURCHASE, MORTGAGE, OR GUARANTEE THE TITLE THERETO WITHIN ONE (1) YEAR
FROM DATE HEREON.

David F. Abell

DAVID F. ABELL
WISCONSIN REGISTERED LAND SURVEYOR, S-1596

October 24, 1994

DATE JOB NUMBER - 94185
NOTE: THIS IS NOT A CERTIFIED COPY UNLESS SEALED.

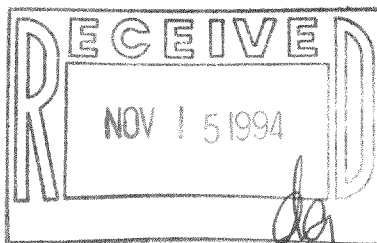

WHITEWATER

LAKE

ALDEN
STREET