

ABELL  
SURVEYING & MAPPING  
DELAVER, WISCONSIN 53115  
414-728-6737



SCALE 1"=30'

LEGEND


- - IRON PIPE FOUND
- - IRON ROD FOUND
- △ - UTILITY POLE
- ( ) - RECORDED AS

NOTE: BEARINGS ARE REFERENCED TO THE  
RECORDED SUBDIVISION PLAT.

ORDERED BY: BRIAN THOMPSON  
5047 KNOLLWOOD  
JANESVILLE, WI 53545

PLAT OF

LOT 31, BLOCK 2, MORaine HEIGHTS, AND THE  
LOCATION OF THE HOUSES AND DISTANCE TO THE  
SHORELINE ON LOTS 30 AND 32, ALL LOCATED IN  
T4N, R1E, WALWORTH COUNTY, WISCONSIN.

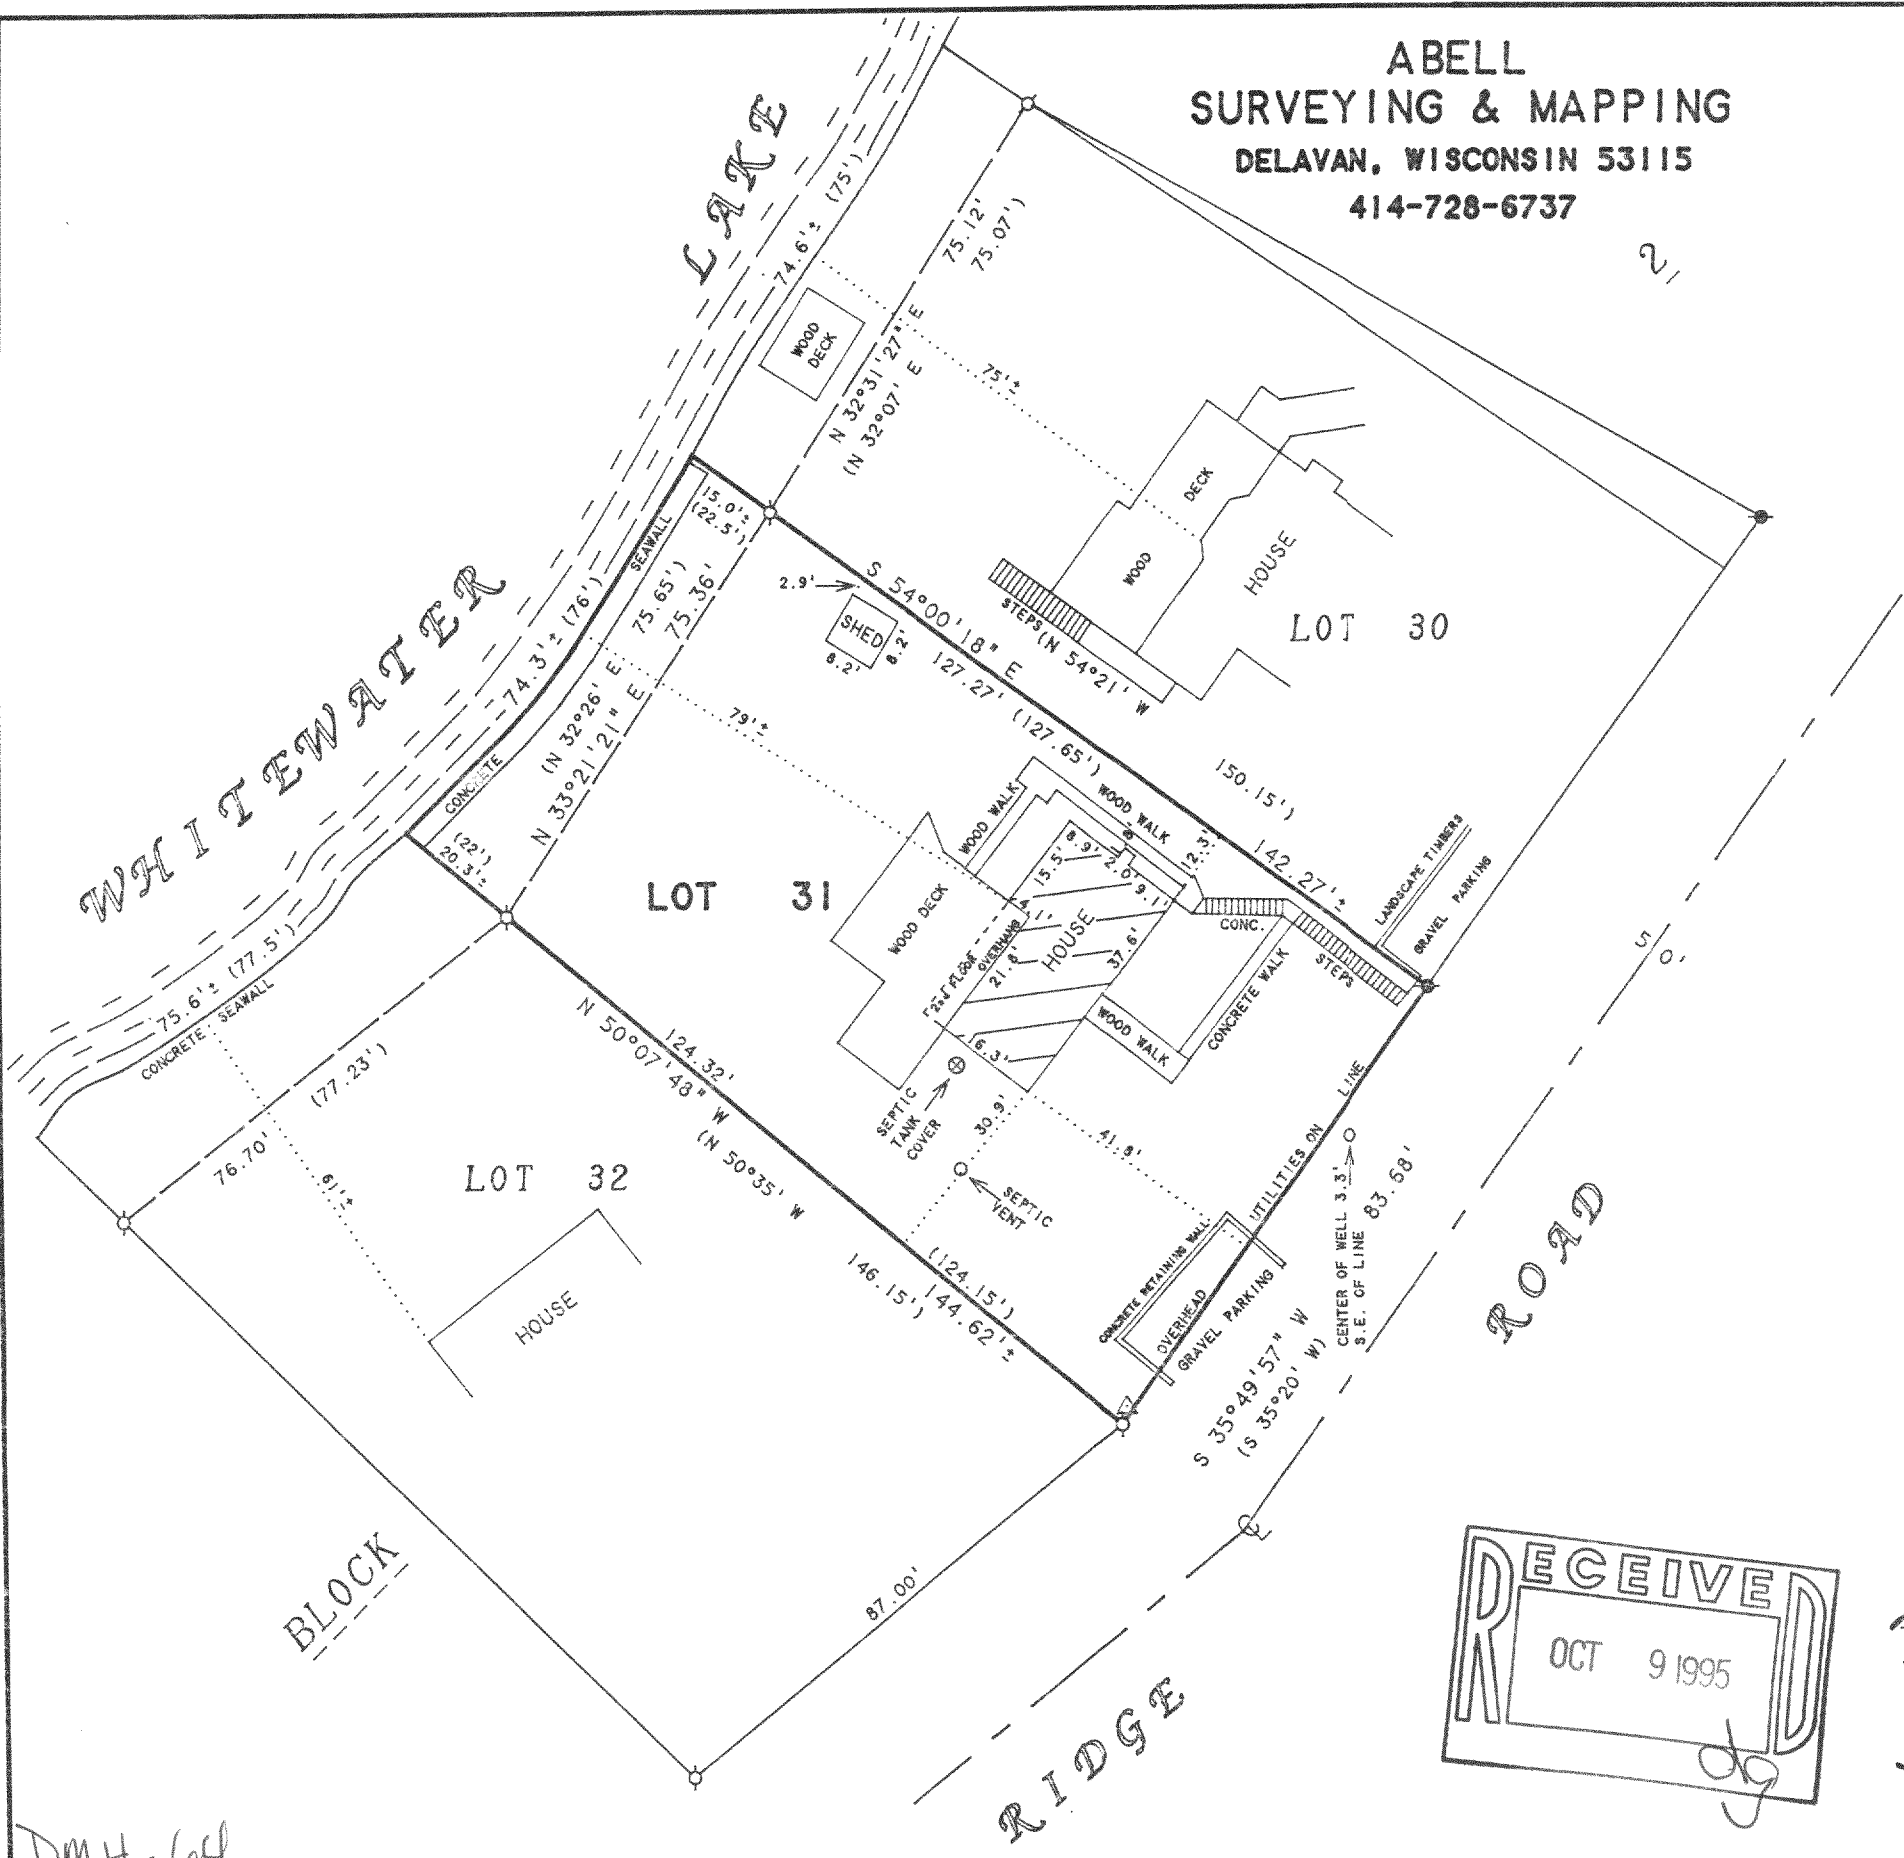

*David F. Abell*

DAVID F. ABELL  
WISCONSIN REGISTERED LAND SURVEYOR, S-1596

*July 19, 1995*

DATE: \_\_\_\_\_ JOB NUMBER - 93039  
NOTE: THIS IS NOT A CERTIFIED COPY UNLESS SEALED.

DMH-64  
415-493