

ABELL SURVEYING & MAPPING DELAVAN, WISCONSIN 53115 414-728-6737

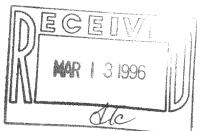

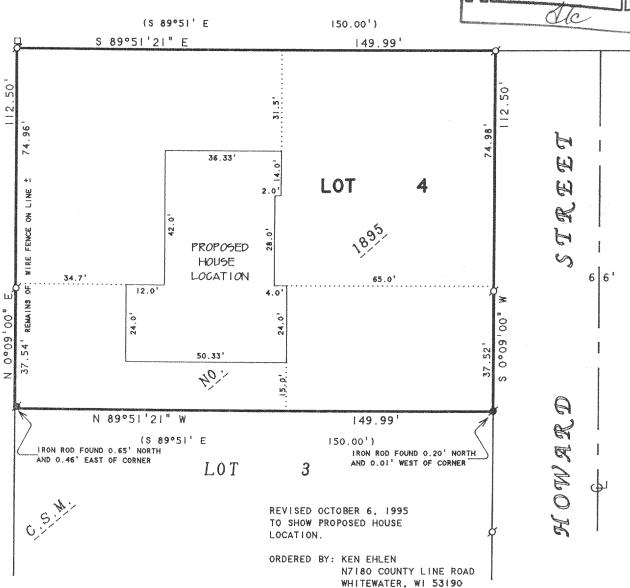

ORDERED BY: VERN LUDTKE

N7480 GRANDVIEW DRIVE WHITEWATER, WI 53190

NOTE: BEARINGS ARE REFERENCED TO CERTIFIED SURVEY MAP NO. 1895.

PLAT OF SURVEY OF

LOT 4. CERTIFIED SURVEY MAP NO. 1895, LOCATED IN SOUTHEAST 1/4 OF SECTION 34, T4N, RISE. WALWORTH COUNTY, WISCONSIN.





SCALE | "=30" LEGEND

Ø -IRON PIPE FOUND -IRON ROD FOUND

)-RECORDED AS

I HEREBY CERTIFY THAT I HAVE SURVEYED THE ABOVE DESCRIBED PROPERTY AND THAT THE ABOVE MAP IS A TRUE REPRESENTATION THEREOF AND SHOWS THE SIZE AND LOCATION OF THE PROPERTY. ITS EXTERIOR BOUNDARIES. THE LOCATION OF ALL VISIBLE STRUCTURES AND DIMENSIONS OF ALL PRINCIPAL BUILDINGS THEREON, BOUNDARY FENCES. APPARENT EASEMENTS. ROADWAYS AND VISIBLE ENCROACHMENTS, IF ANY. TO THE BEST OF MY KNOWLEDGE AND BELIEF:


THIS SURVEY IS MADE FOR THE USE OF THE PRESENT OWNERS OF THE PROPERTY. AND ALSO THOSE THO PURCHASE, MORTGAGE, OR GUARANTEE THE TITLE THERETO WITHIN ONE (1) YEAR FROM DATE HEREON.


DAVID F. ABELL WISCONSIN REGISTERED LAND SURVEYOR, S-1596

July 12, 1995

DATE JOB NUMBER - NOTE: THIS IS NOT A CERTIFIED COPY UNLESS SEALED.

ABELL SURVEYING & MAPPING DELAVAN, WISCONSIN 53115 414-728-6737

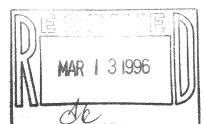

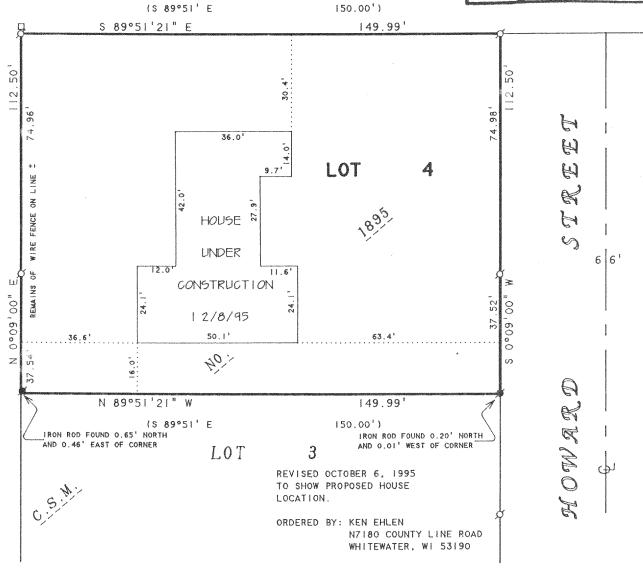

ORDERED BY: VERN LUDTKE
N7480 GRANDVIEW DRIVE
WHITEWATER, WI 53190

REVISED DECEMBER 8, 1995 TO SHOW HOUSE UNDER CONSTRUCTION.

ORDERED BY: M & I BANK - JANESVILLE

NOTE: BEARINGS ARE REFERENCED TO CERTIFIED SURVEY MAP NO. 1895.

PLAT OF SURVEY OF

N

LOT 4, CERTIFIED SURVEY MAP NO. 1895, LOCATED IN SOUTHEAST 1/4 OF SECTION 34, T4N, RISE, WALWORTH COUNTY, WISCONSIN.



I HEREBY CERTIFY THAT I HAVE SURVEYED THE ABOVE DESCRIBED PROPERTY AND THAT THE ABOVE MAP IS A TRUE REPRESENTATION THEREOF AND SHOWS THE SIZE AND LOCATION OF THE PROPERTY. ITS EXTERIOR BOUNDARIES. THE LOCATION OF ALL VISIBLE STRUCTURES AND DIMENSIONS OF ALL PRINCIPAL BUILDINGS THEREON. BOUNDARY FENCES, APPARENT EASEMENTS. ROADWAYS AND VISIBLE ENCROACHMENTS. IF ANY. TO THE BEST OF MY KNOWLEDGE AND BELIEF:

scale | "=30 | LEGEND THIS SURVEY IS MADE FOR THE USE OF THE PRESENT OWNERS OF THE PROPERTY, AND ALSO THOSE WHO PURCHASE, MORTGAGE, OR GUARANTEE THE TITLE THERETO WITHIN ONE (I) YEAR FROM DATE HEREON.

Ø -IRON PIPE FOUND

DAVID F. ABELL WISCONSIN REGISTERED LAND SURVEYOR, S-1596

July 12, 1995

DATE JOB NUMBER - 95110
NOTE: THIS IS NOT A CERTIFIED COPY UNLESS SEALED.

124-1845-4