

**ABELL
SURVEYING & MAPPING**
DELAVAN, WISCONSIN 53115
414-728-6737




SCALE 1"=30'

LEGEND


- - IRON PIPE FOUND
- - IRON BAR FOUND
- - IRON ROD SET
- - WOOD STAKE AS PLACED BY OWNER
- △ - UTILITY POLE
- - OVERHEAD UTILITY LINES
- * - WOOD FENCE
- () - RECORDED AS

NOTE: BEARINGS ARE REFERENCED TO THE RECORDED SUBDIVISION PLAT.

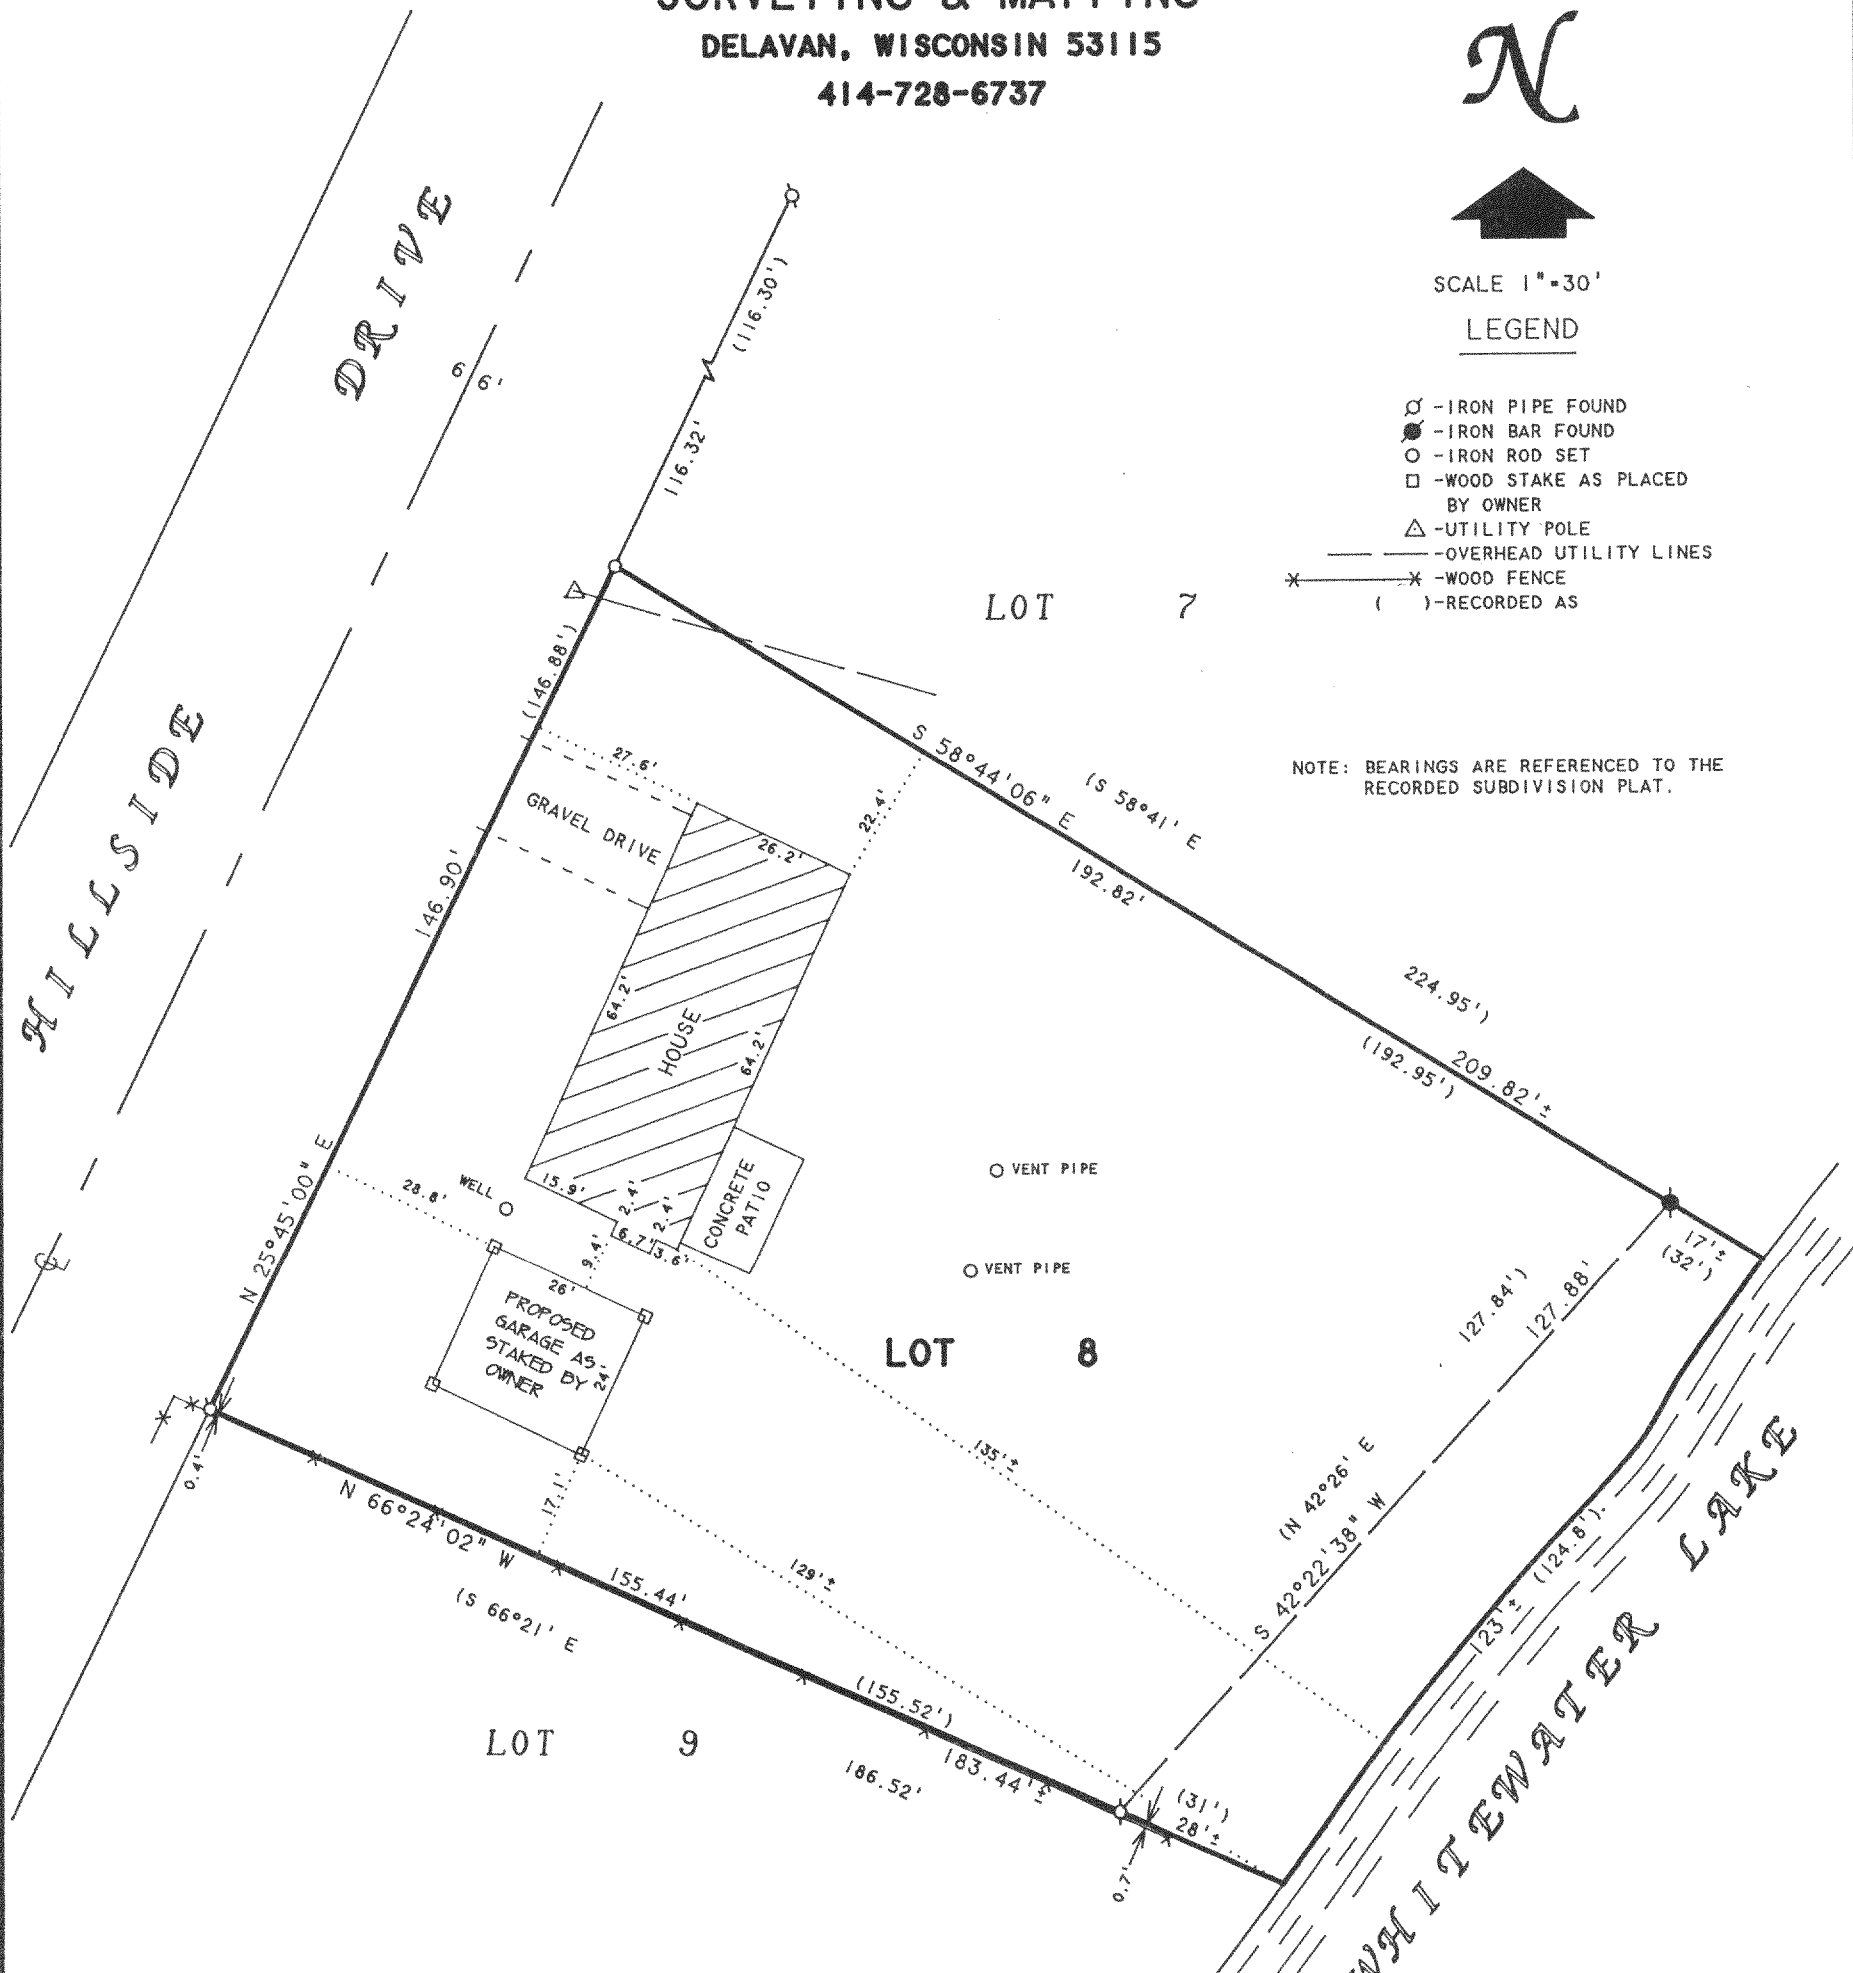

PLAT OF SURVEY OF

LOT 8, BAY VIEW ESTATES, LOCATED IN T4N, R1E, WALWORTH COUNTY, WISCONSIN.

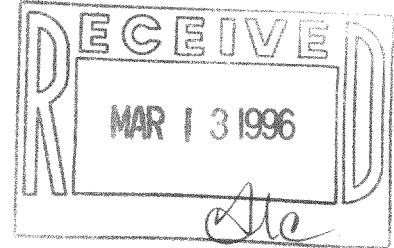

ORDERED BY: ALEX MUNOZ
LORI CONSTRUCTION
210 W. IRVING PARK
BENSenville, IL 60106

I HEREBY CERTIFY THAT I HAVE SURVEYED THE ABOVE DESCRIBED PROPERTY AND THAT THE ABOVE MAP IS A TRUE REPRESENTATION THEREOF AND SHOWS THE SIZE AND LOCATION OF THE PROPERTY, ITS EXTERIOR BOUNDARIES, THE LOCATION OF ALL VISIBLE STRUCTURES AND DIMENSIONS OF ALL PRINCIPAL BUILDINGS THEREON, BOUNDARY FENCES, APPARENT EASEMENTS, ROADWAYS AND VISIBLE ENCROACHMENTS, IF ANY, TO THE BEST OF MY KNOWLEDGE AND BELIEF.

THIS SURVEY IS MADE FOR THE USE OF THE PRESENT OWNERS OF THE PROPERTY, AND ALSO THOSE WHO PURCHASE, MORTGAGE, OR GUARANTEE THE TITLE THERETO WITHIN ONE (1) YEAR FROM DATE HEREON.

David F. Abell

DAVID F. ABELL
WISCONSIN REGISTERED LAND SURVEYOR, S-1596

November 8, 1995

DATE: _____ JOB NUMBER - 95199
NOTE: THIS IS NOT A CERTIFIED COPY UNLESS SEALED.

DBK-8

415-2336