

NORTHEAST CORNER OF
SECTION 18-4-15


PLAT OF SURVEY

CERTIFIED SURVEY MAP NO. 1055, being a part of the
Southwest 1/4 of Section 18, Town 4 North, Range 15
East, Town of Whitewater, Walworth County, Wisconsin.

Survey address: 8660 Converse Road

Surveyed for: Greg Greenwood


CONVERSE
N03°06'12"W
610.10'
(610.00')
ROAD

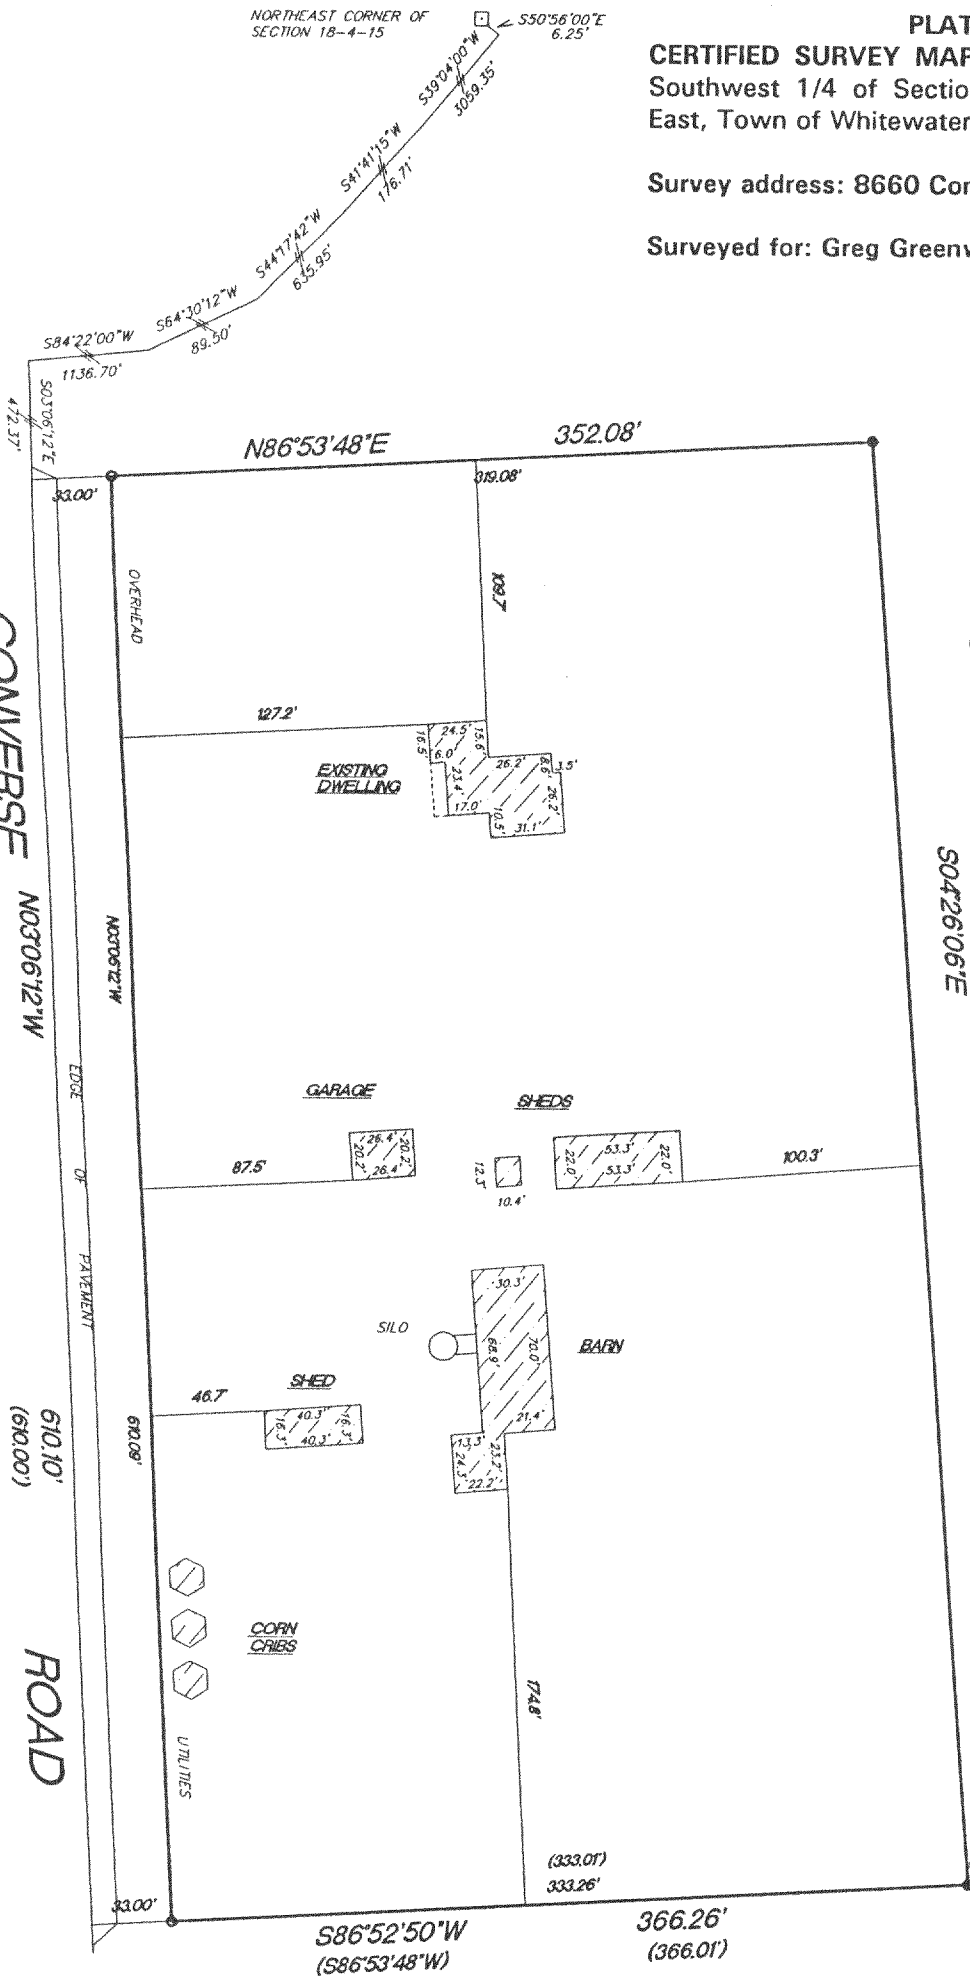

- o FOUND 1" IRON PIPE
- SET 1" IRON PIPE
- () RECORDED AS DIMENSIONS

SCALE 1"=80'

LOT DOES NOT CLOSE
AS PLATTED

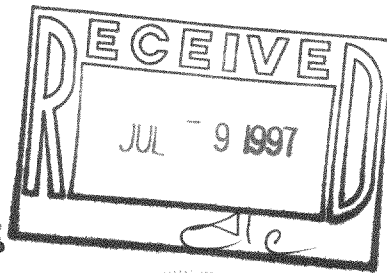

"I hereby certify that I have surveyed the above described property and that the above map is a true representation thereof and shows the size and location of the property, its exterior boundaries, the location of all visible structures and dimension of all principal buildings thereon, boundary fences, apparent easements, roadways and encroachments if any."

"This survey is made for the use of the present owners of the property, and also those who purchase, mortgage or guarantee the title thereto within one year from date hereof."



W362 S10227 Lewin Lane
Eagle, Wisconsin 53119
Terrance E. Pisarek R.L.S.

(414) 594-3484
fax (414) 594-5904

THIS IS NOT AN ORIGINAL SURVEY UNLESS THE SEAL IS RED.

6/12/97
DATE

TEP/JPK
FIELD WORK BY

TEP
DRAWN BY

9710
JOB NUMBER

DA-1055-1

415-591