



1140 SEQUOIA STREET • DELAVAN, WISCONSIN 53115
414-728-6737

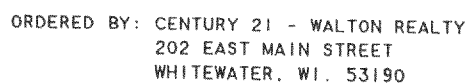

LOT 8, BLOCK 1, MORaine PARK SUBDIVISION, LOCATED
IN T4N, R15E, WALWORTH COUNTY, WISCONSIN.

NOTE: BEARINGS ARE REFERENCED TO THE
RECORDED SUBDIVISION PLAT.

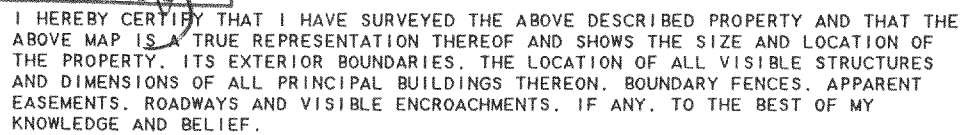

THIS SURVEY IS MADE FOR THE USE OF THE PRESENT OWNERS OF THE PROPERTY, AND ALSO THOSE WHO PURCHASE. MORTGAGE, OR GUARANTEE THE TITLE THERETO WITHIN ONE (1) YEAR FROM DATE HEREON.

DAVID F. ABELL
WISCONSIN REGISTERED LAND SURVEYOR, S-1596

DATE _____ JOB NUMBER - 97209
NOTE: THIS IS NOT A CERTIFIED COPY UNLESS SEALED.

SCALE 1" = 20'

LEGEND

- Ø - IRON PIPE FOUND
 □ - UTILITY PEDS.
 ⊗ - CONCRETE COVER
 UNDER WOOD DECK
 () - RECORDED AS

DMP-8

415-628