

ABERNATHY and ASSOCIATES

Kenneth B. Abernathy Jr. Wisconsin Registered Land Surveyor S-1594 W4056 Bray Road Elkhorn, Wisconsin 53121 Phone: (414) 723-4260 (office) (414) 723-7209 (fax)

PLAT OF SURVEY

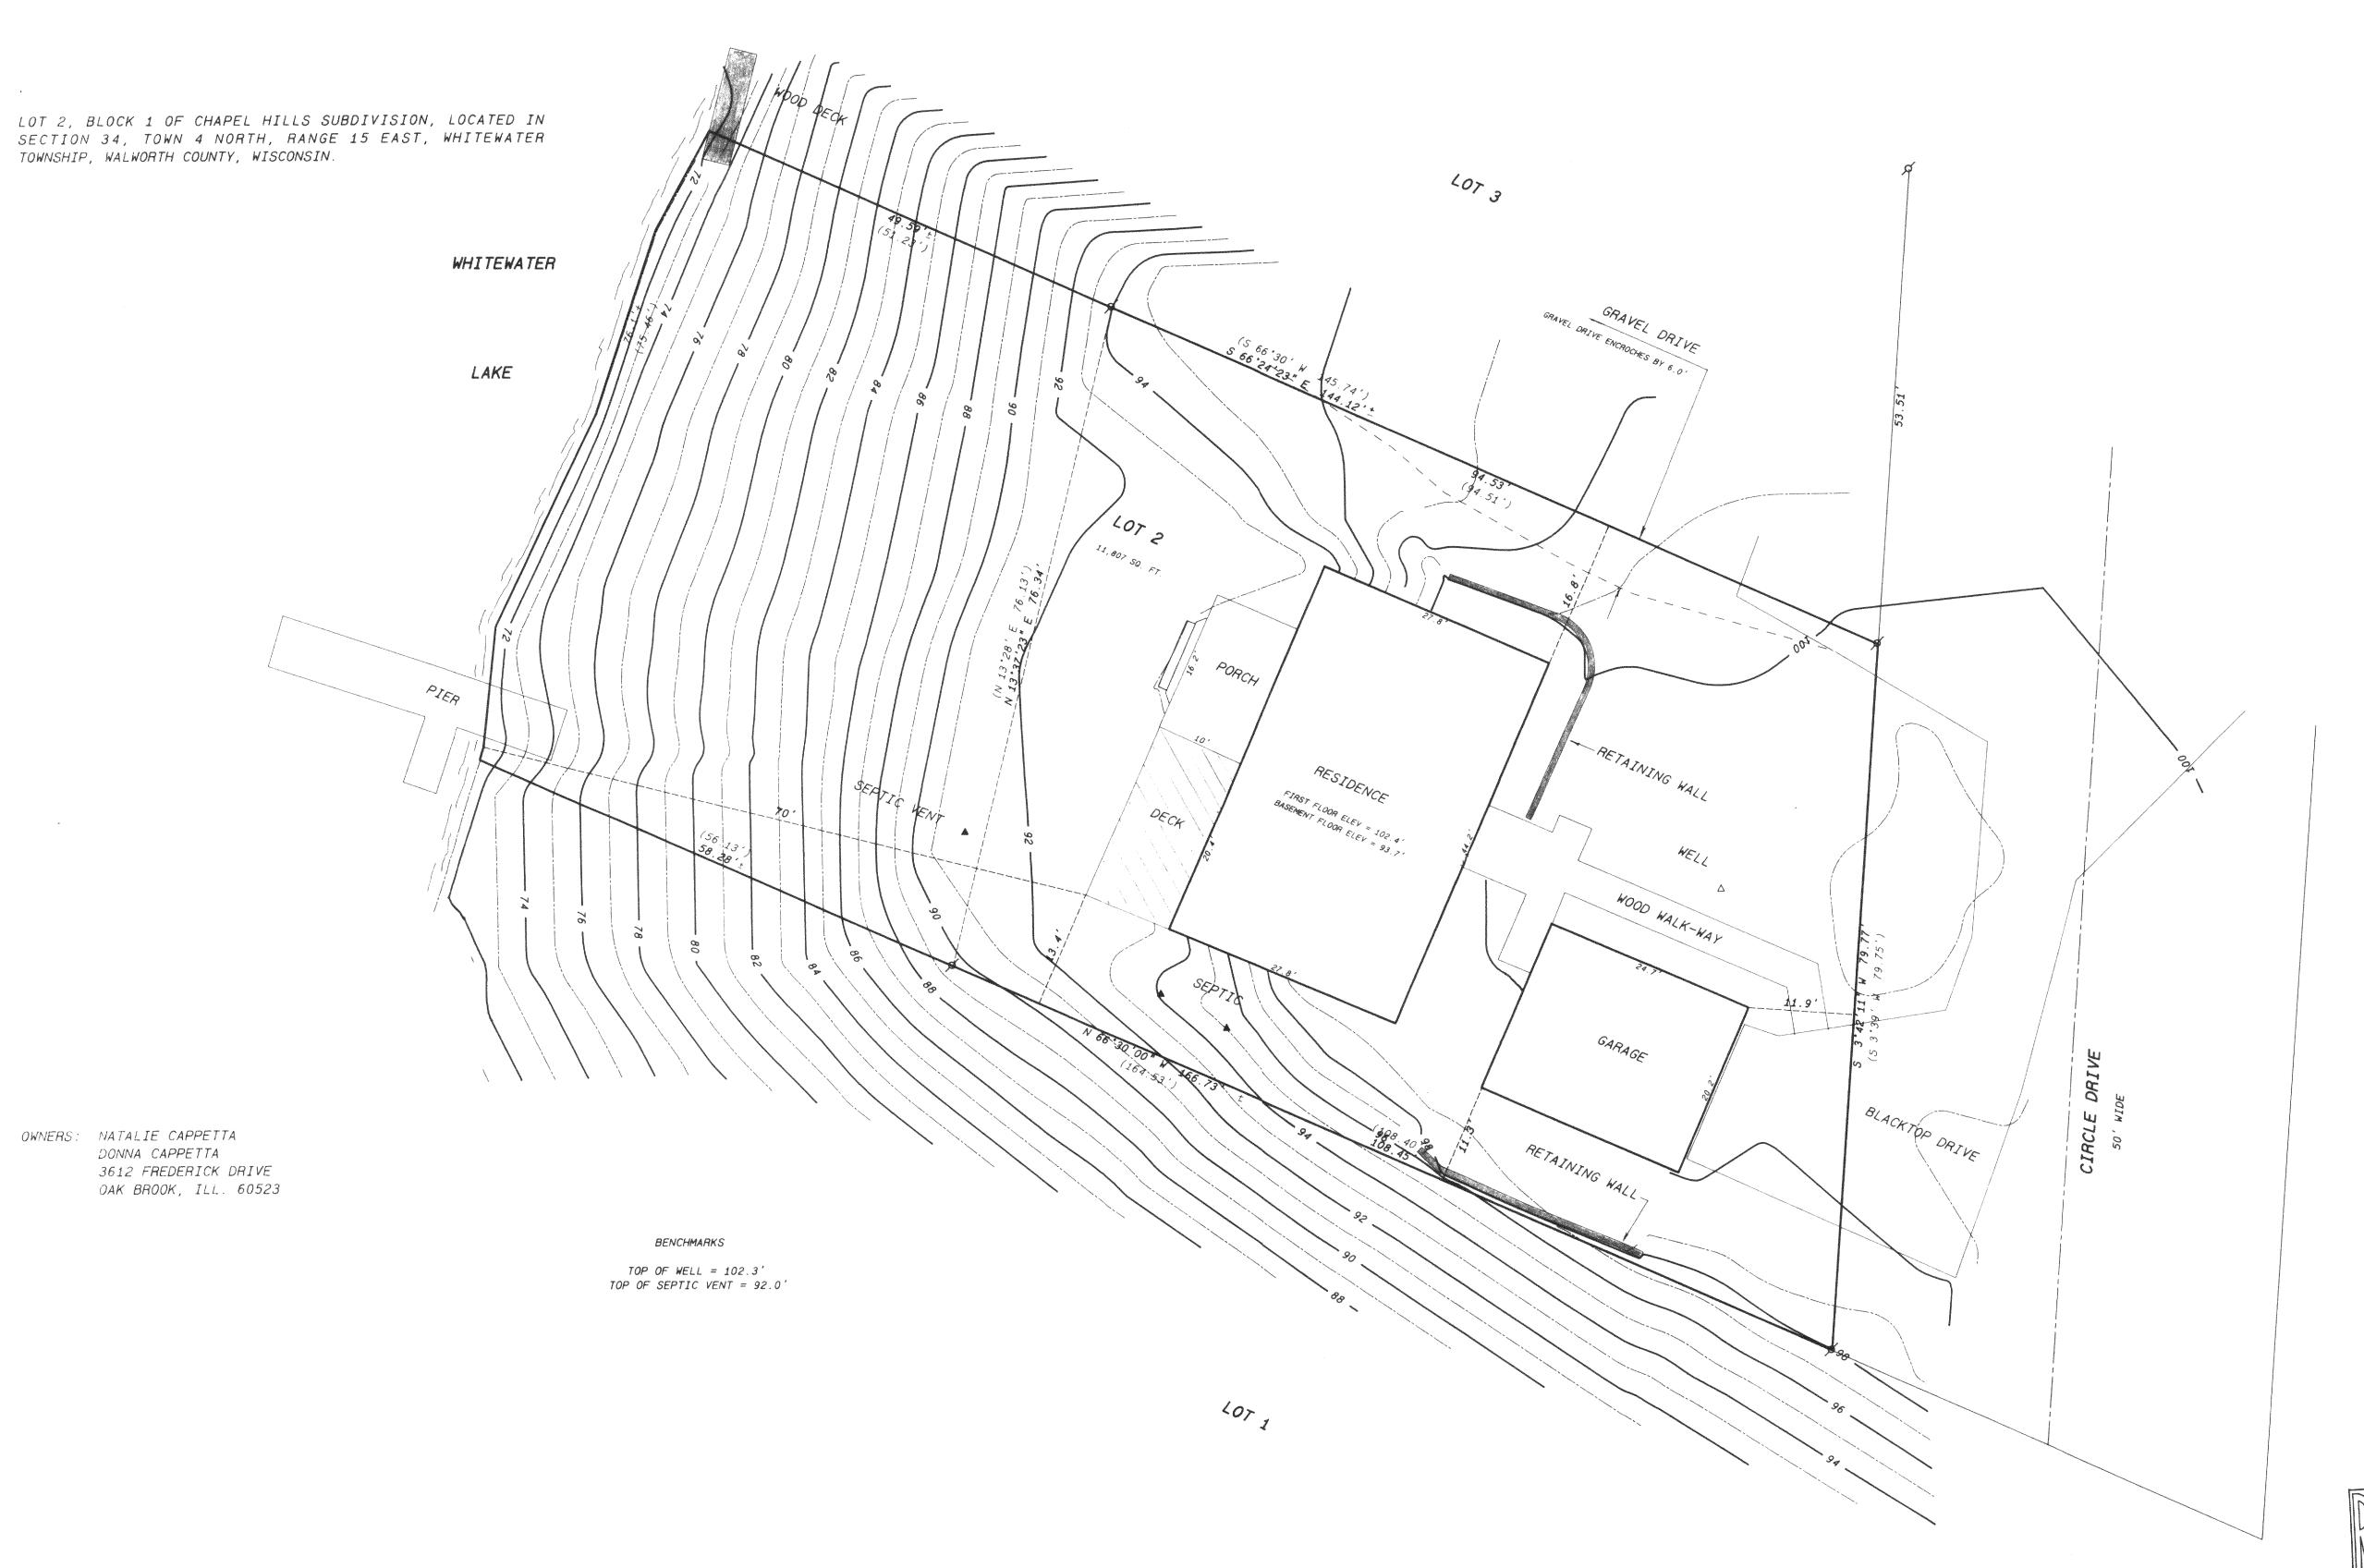

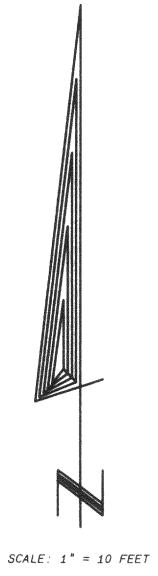

Legend

A FOUND IRON PIPE FOUND IRON ROD O FOUND BRASS CAPPED MONUMENT

FOUND CONCRETE MONUMENT

+ CHISEL CUT IN CONCRETE


SET IRON ROD, 24" LONG, WEIGHING 1.5 LBS, LINEAU FT., 3/4" DIA.

SET IRON ROD, 30" LONG, WEIGHING 4.5 LBS, LINEAL FT., 1-11/16" DIA, (xx) RECORDED AS DIMENSION

-x--x- EXISTING FENCE



SCALE: 1"= 10 FEET

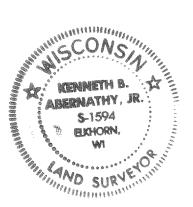

I hereby certify that the above described property has been surveyed by me or under my direction and that the above map is a true representation thereof and shows the size and location of the property its exterior boundaries, the location of all visible structures and dimensions of all principal buildings thereon, boundary fences, apparent easements, roadways and visible encroachments, if any."

This survey is made for the use of the present owners of the property, and also those who purchase, mortgage, or guarantee the liftle thereto within one year from date hereof.

KENNETH B. ABERNATHY, JR.

WISCONSIN REGISTERED LAND SURVEYOR,

Date: OCT. 1, 1998 Job No. 98.905