


ABELL  
SURVEYING & MAPPING

1140 SEQUOIA STREET • DELAVAN, WISCONSIN 53115  
414-728-6737

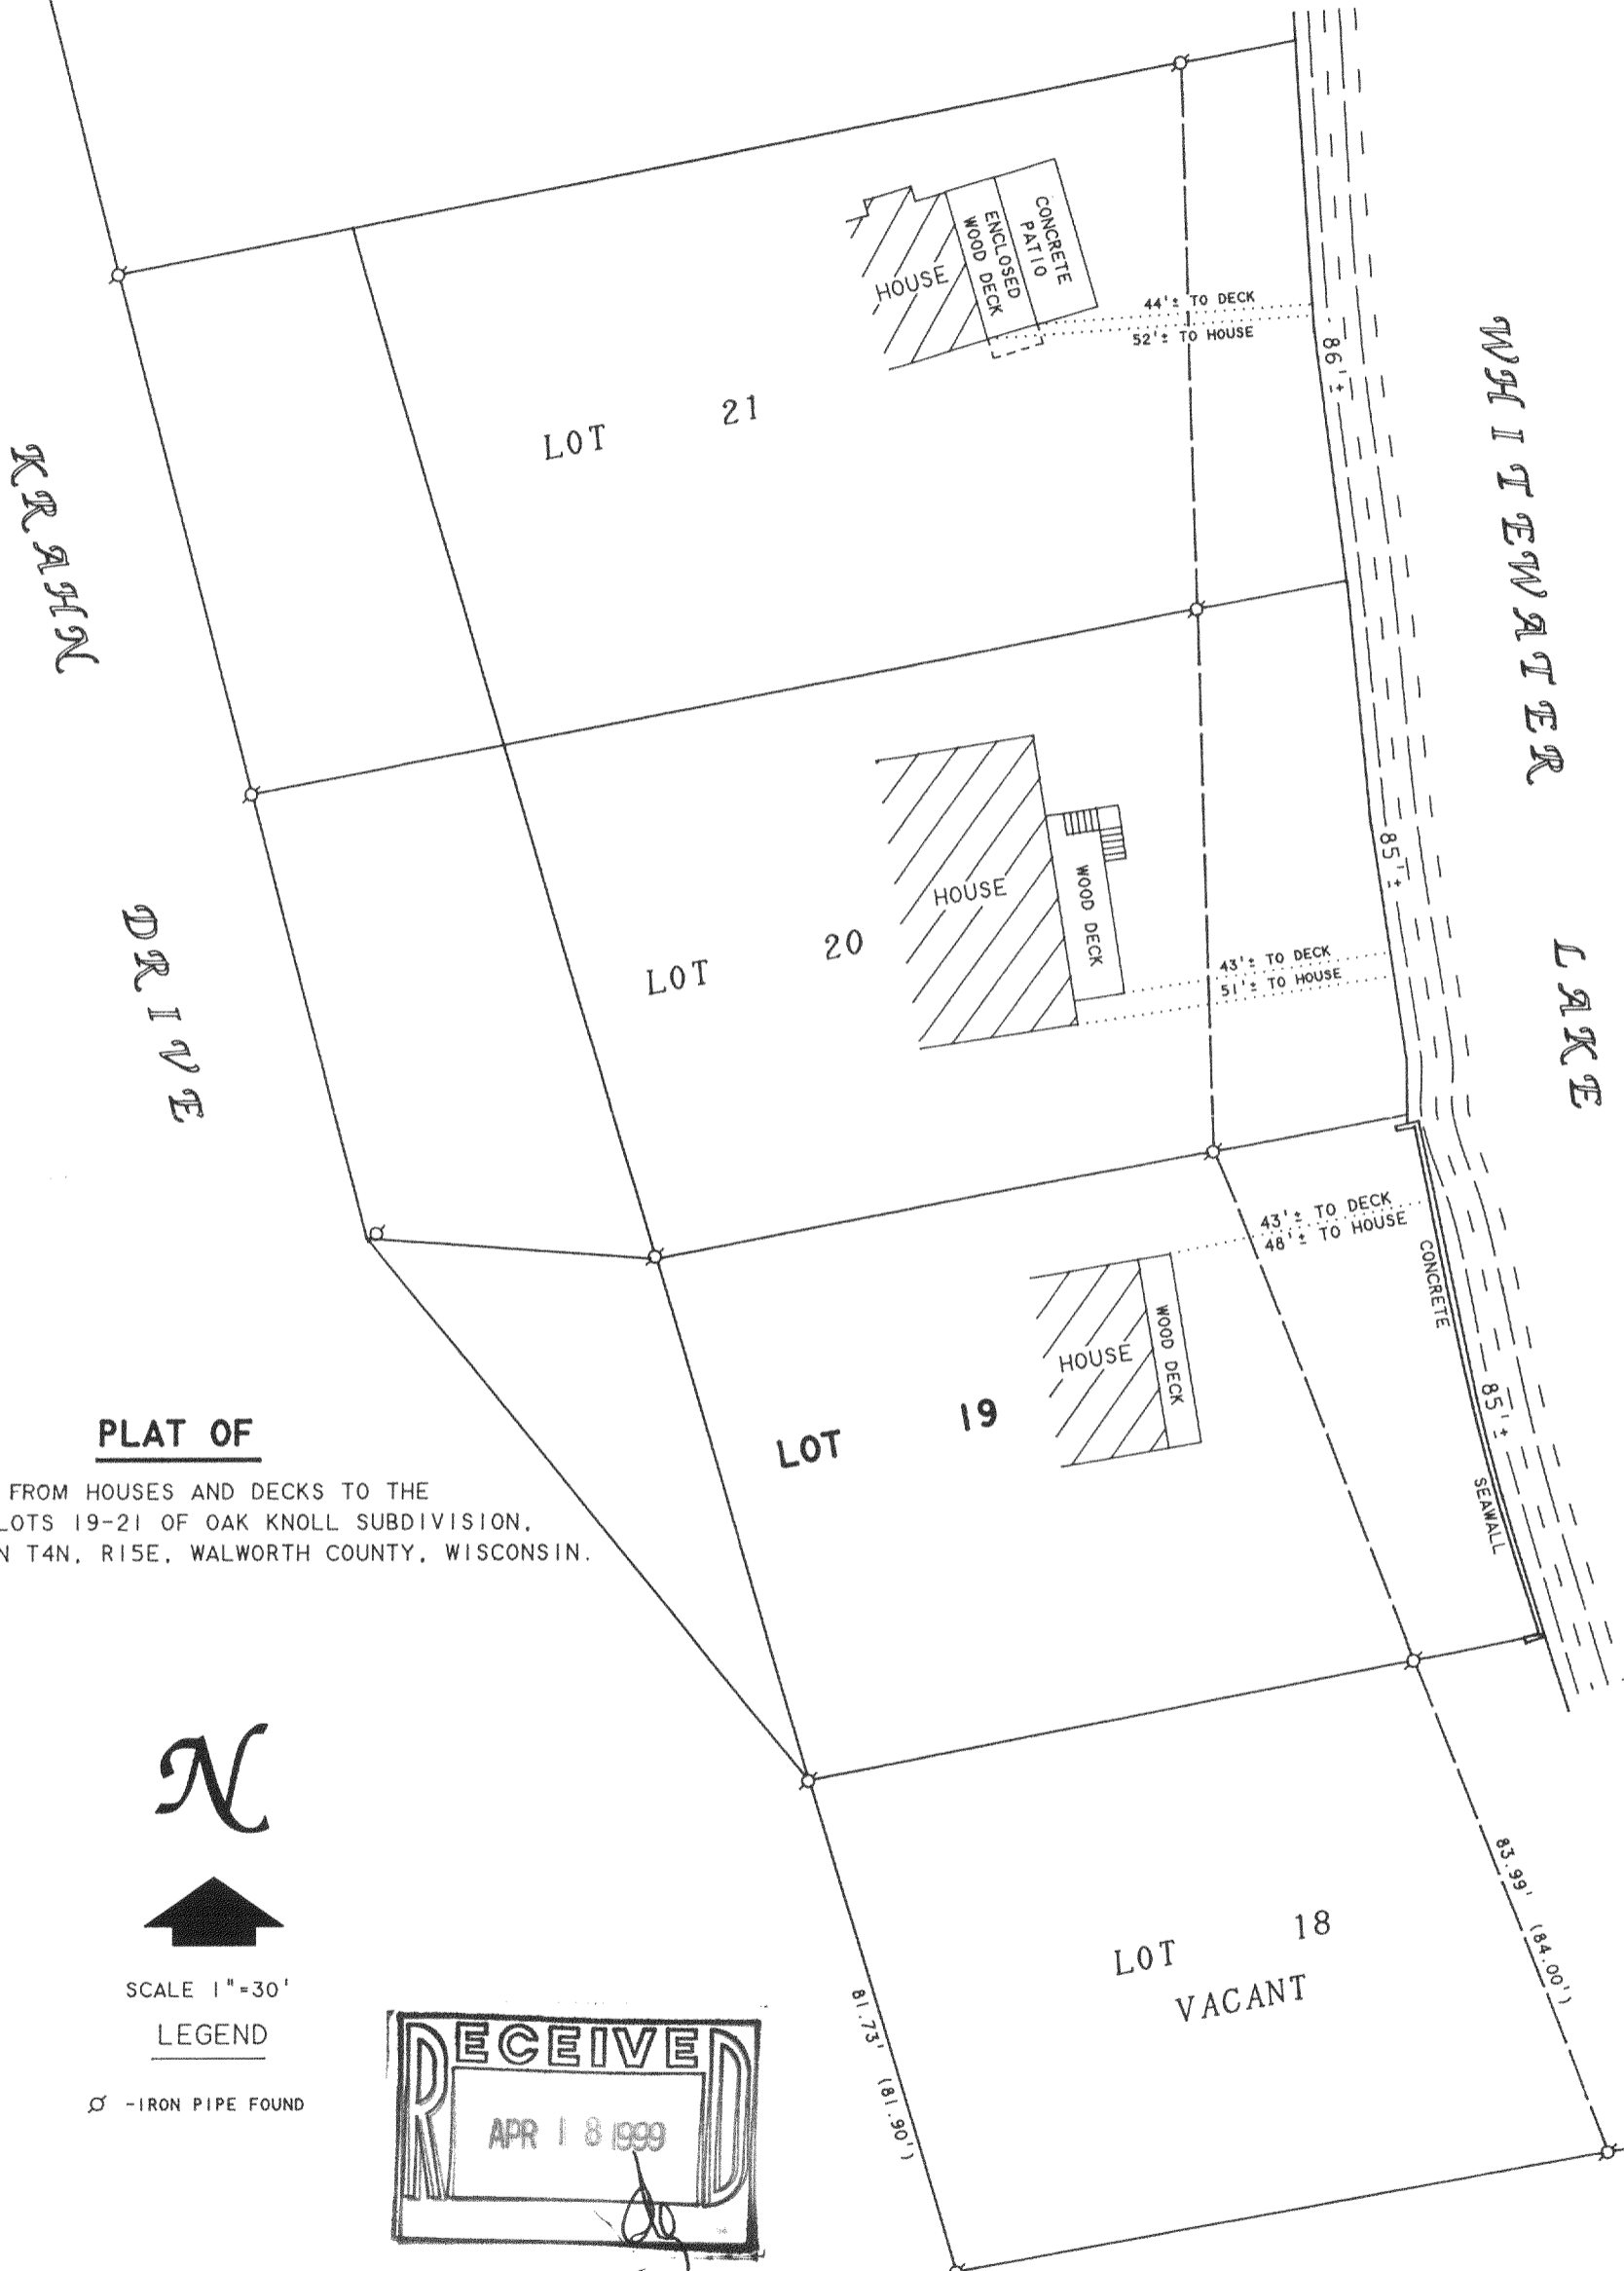

**PLAT OF**


DISTANCES FROM HOUSES AND DECKS TO THE SHORE ON LOTS 19-21 OF OAK KNOLL SUBDIVISION, LOCATED IN T4N, R15E, WALWORTH COUNTY, WISCONSIN.



SCALE 1"=30'

**LEGEND**

○ - IRON PIPE FOUND

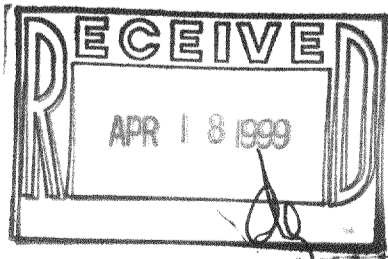

ORDERED BY: ROBERT KUCHAN  
551 SUNNYSIDE  
ELMHURST, IL 60126

*David F. Abell*

DAVID F. ABELL  
WISCONSIN REGISTERED LAND SURVEYOR, S-1596

*December 17, 1998*

DATE: \_\_\_\_\_ JOB NUMBER - 98074  
NOTE: THIS IS NOT A CERTIFIED COPY UNLESS SEALED.

Dok-2  
Dok-3  
Dok-4

415-688