

1140 SEQUOIA STREET • DELAVAN, WISCONSIN 53115
414-728-6737

1140 SEQUOIA STREET • DELAVAN, WISCONSIN 53115
414-728-6737

К Р Я Н

DRIVE

LOT 21

LOT 20

LOT 19

LOT 18
VACANT

PLAT OF


DISTANCES FROM HOUSES AND DECKS TO THE
SHORE ON LOTS 19-21 OF OAK KNOLL SUBDIVISION,
LOCATED IN T4N, R15E, WALWORTH COUNTY, WISCONSIN.



SCALE 1"=30'

LEGEND

Ø - IRON PIPE FOUND

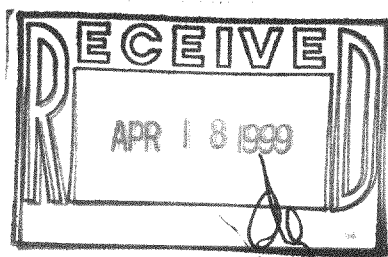

ORDERED BY: ROBERT KUCHAN
551 SUNNYSIDE
ELMHURST, IL 60126

Daniel F. Bell

DAVID F. ABELL
WISCONSIN REGISTERED LAND SURVEYOR, S-1596

December 17, 1998

DATE _____ JOB NUMBER - 98074
NOTE: THIS IS NOT A CERTIFIED COPY UNLESS SEALED.

DOK-2
DOK-3
DOK-4

415-688