
PLAT OF SURVEY

LOT 21 AND THE NORTHEASTERLY 1/2 OF LOT 22, BLOCK 1, INDIAN TRAIL SUBDIVISION, located in the Northwest 1/4 of the Southwest 1/4 of Section 26, and the Northeast 1/4 of the Southeast 1/4 and the Southeast 1/4 of the Southeast 1/4 of Section 27, Town 4 North, Range 15 East, Walworth County, Wisconsin.

Surveyed for : Dan and Amy Stritzel

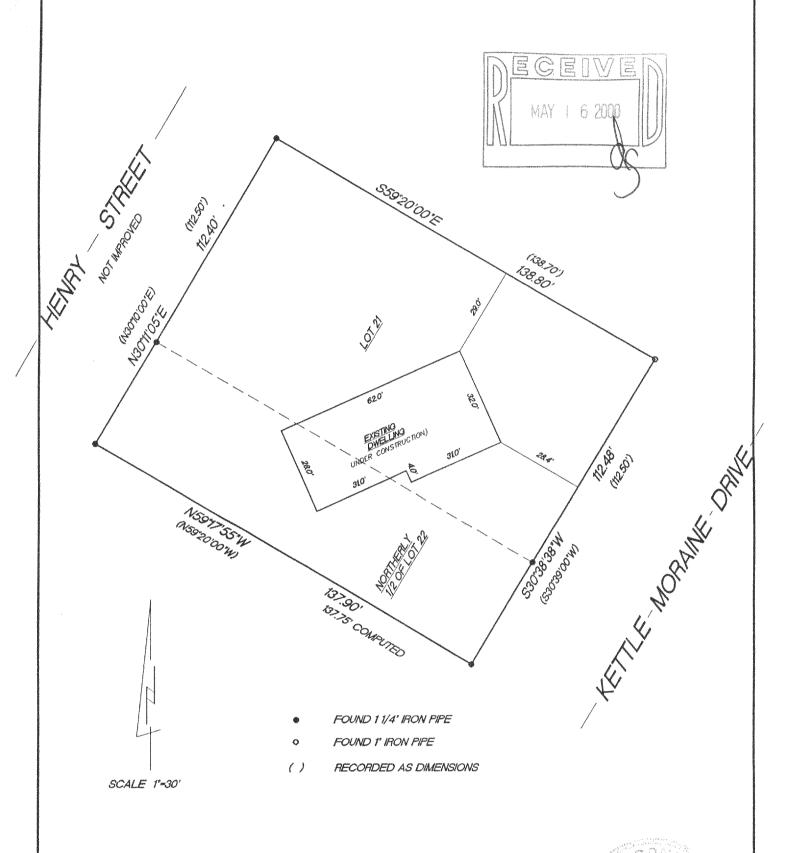

"I hereby certify that I have surveyed the above described property and that the above map is a true representation thereof and shows the size and location of the property, its exterior boundaries, the location of all visible structures and dimension of all principal buildings thereon, boundary fences, apparent easements, roadways and encroachments if any."

"This survey is made for the use of the present owners of the property, and also those who purchase, mortgage or guarantee the title thereto within one year from date hereof."

REV. 5/15/00

 2/25/00
 TEP/DW

 DATE
 FIELD WORK BY

KETTLE MORAINE SURVEYING W356 S9050 Godfrey Lane Eagle Wisconsin 53119 P.O. Box 357 (262) 594-3484

Terrance E. Pisarek R.L.S.

THIS IS NOT AN ORIGINAL SURVEY UNLESS THE SEAL IS RED.

TEP 00044

DRAWN BY JOB NUMBER

DITS-21

415-753