


**ABELL  
SURVEYING & MAPPING  
DELAVAN, WISCONSIN 53115  
262-728-6737**

ORDERED BY: TOWN & COUNTRY REALTY  
135 W. MAIN STREET  
WHITEWATER, WI 53190

REVISED: NOVEMBER 9, 1995  
TO SHOW NEW LOCATION OF  
HOT TUB AND VENT PIPE.  
GONE JAN. 3, 2001

ORDERED BY: DARRELL L. BUTCHER SR., OWNER

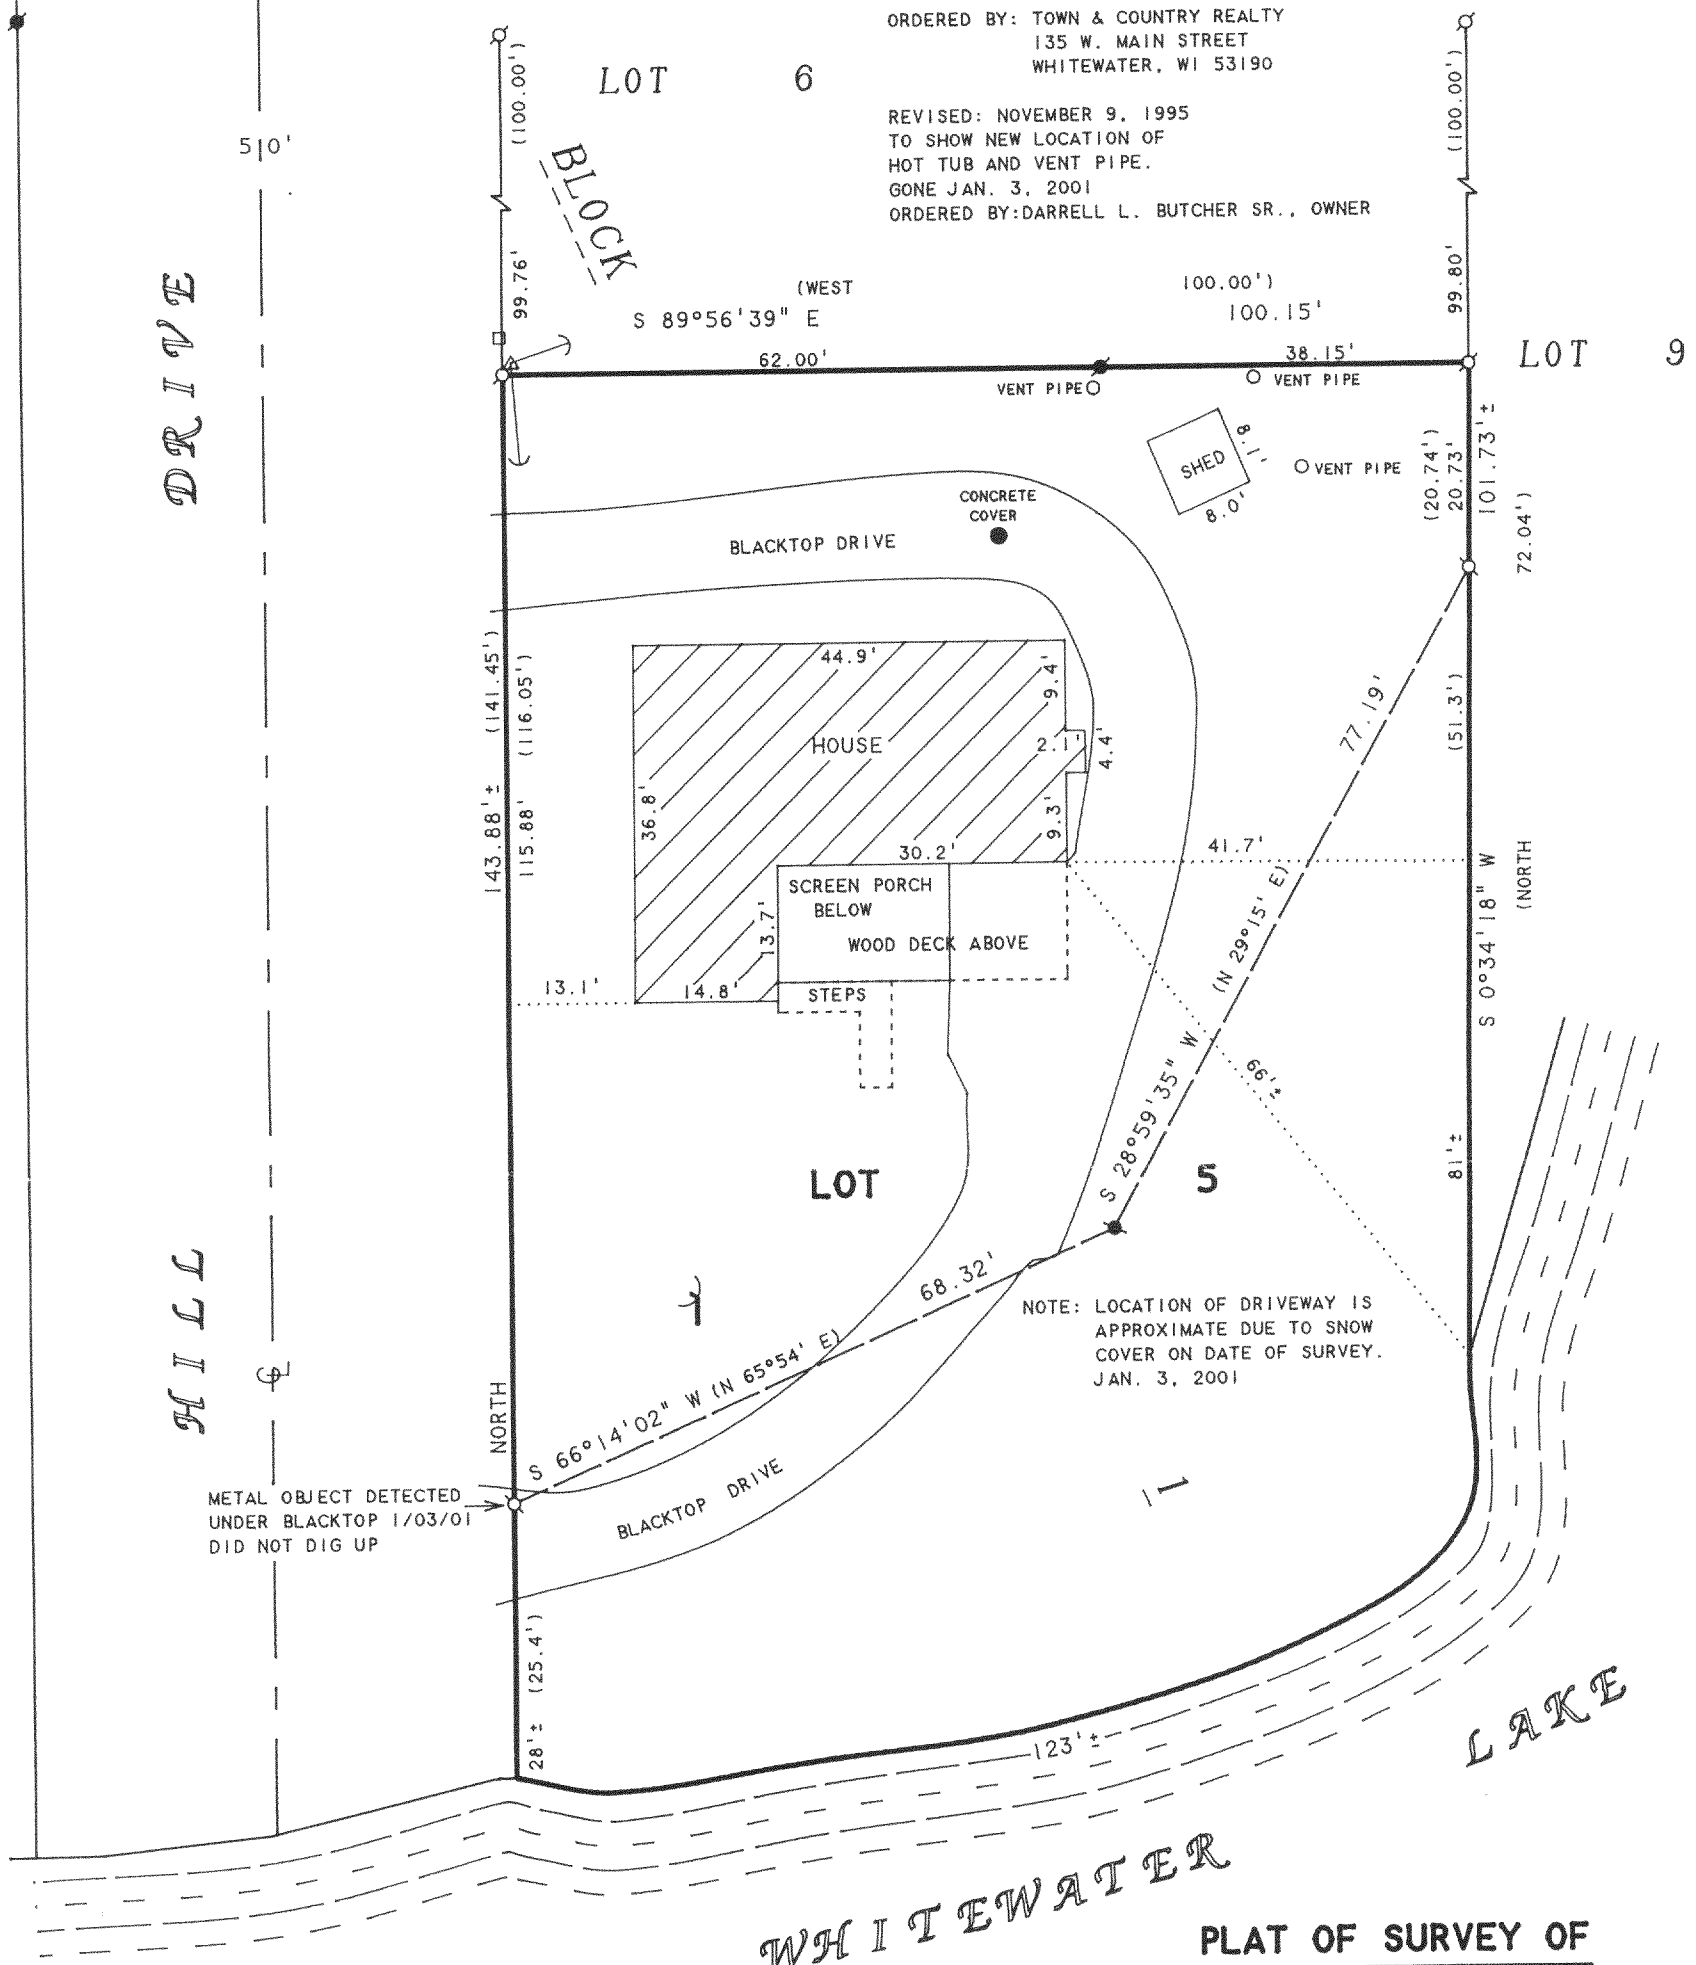

REVISED AND RECERTIFIED JAN. 3, 2001  
ORDERED BY: ATTY. WILLIAM FITZPATRICK  
341 E. LINCOLN AVE.  
BARRINGTON, IL 60010

I HEREBY CERTIFY THAT I HAVE SURVEYED THE ABOVE DESCRIBED PROPERTY AND THAT THE ABOVE MAP IS A TRUE REPRESENTATION THEREOF AND SHOWS THE SIZE AND LOCATION OF THE PROPERTY, ITS EXTERIOR BOUNDARIES, THE LOCATION OF ALL VISIBLE STRUCTURES AND DIMENSIONS OF ALL PRINCIPAL BUILDINGS THEREON, BOUNDARY FENCES, APPARENT EASEMENTS, ROADWAYS AND VISIBLE ENCROACHMENTS, IF ANY, TO THE BEST OF MY KNOWLEDGE AND BELIEF.

THIS SURVEY IS MADE FOR THE USE OF THE PRESENT OWNERS OF THE PROPERTY, AND ALSO THOSE WHO PURCHASE, MORTGAGE, OR GUARANTEE THE TITLE THERETO WITHIN ONE (1) YEAR FROM DATE HEREON.

*David F. Abell*


DAVID F. ABELL  
WISCONSIN REGISTERED LAND SURVEYOR, S-1596

October 26, 1995

DATE JOB NUMBER - 95186B  
NOTE: THIS IS NOT A CERTIFIED COPY UNLESS SEALED.

Revised & Recertified 1/03/01

Revised - 11/9/95

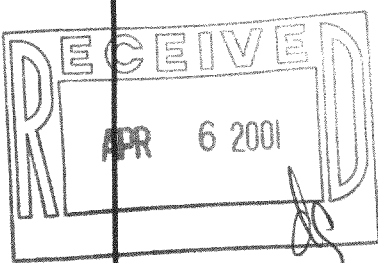

N



SCALE 1"=20'

LEGEND

- - IRON PIPE FOUND
- - IRON ROD FOUND
- △ - UTILITY POLE
- - GUY WIRE
- - UTILITY PED.
- ⊙ - T.V. SATELLITE ANTENNA
- ( ) - RECORDED AS

DGS-5

415-795