
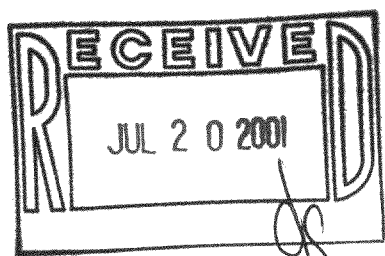


PLAT OF SURVEY

LOT 1 BLOCK 2 AND LOT 8 BLOCK 4, CHAPEL HILLS SUBDIVISION
LOCATED IN SE 1/4 OF THE SE 1/4 OF SECTION 34, T. 4 N. R.
15 E. AND IN THE NE 1/4 OF THE NE 1/4 AND IN THE E 1/2 OF THE
SE 1/4 OF THE NE 1/4 OF SECTION 3, T. 3 N. R. 15 E., WALWORTH
COUNTY, WISCONSIN.


SURVEYED FOR: WILLIAM LEONE

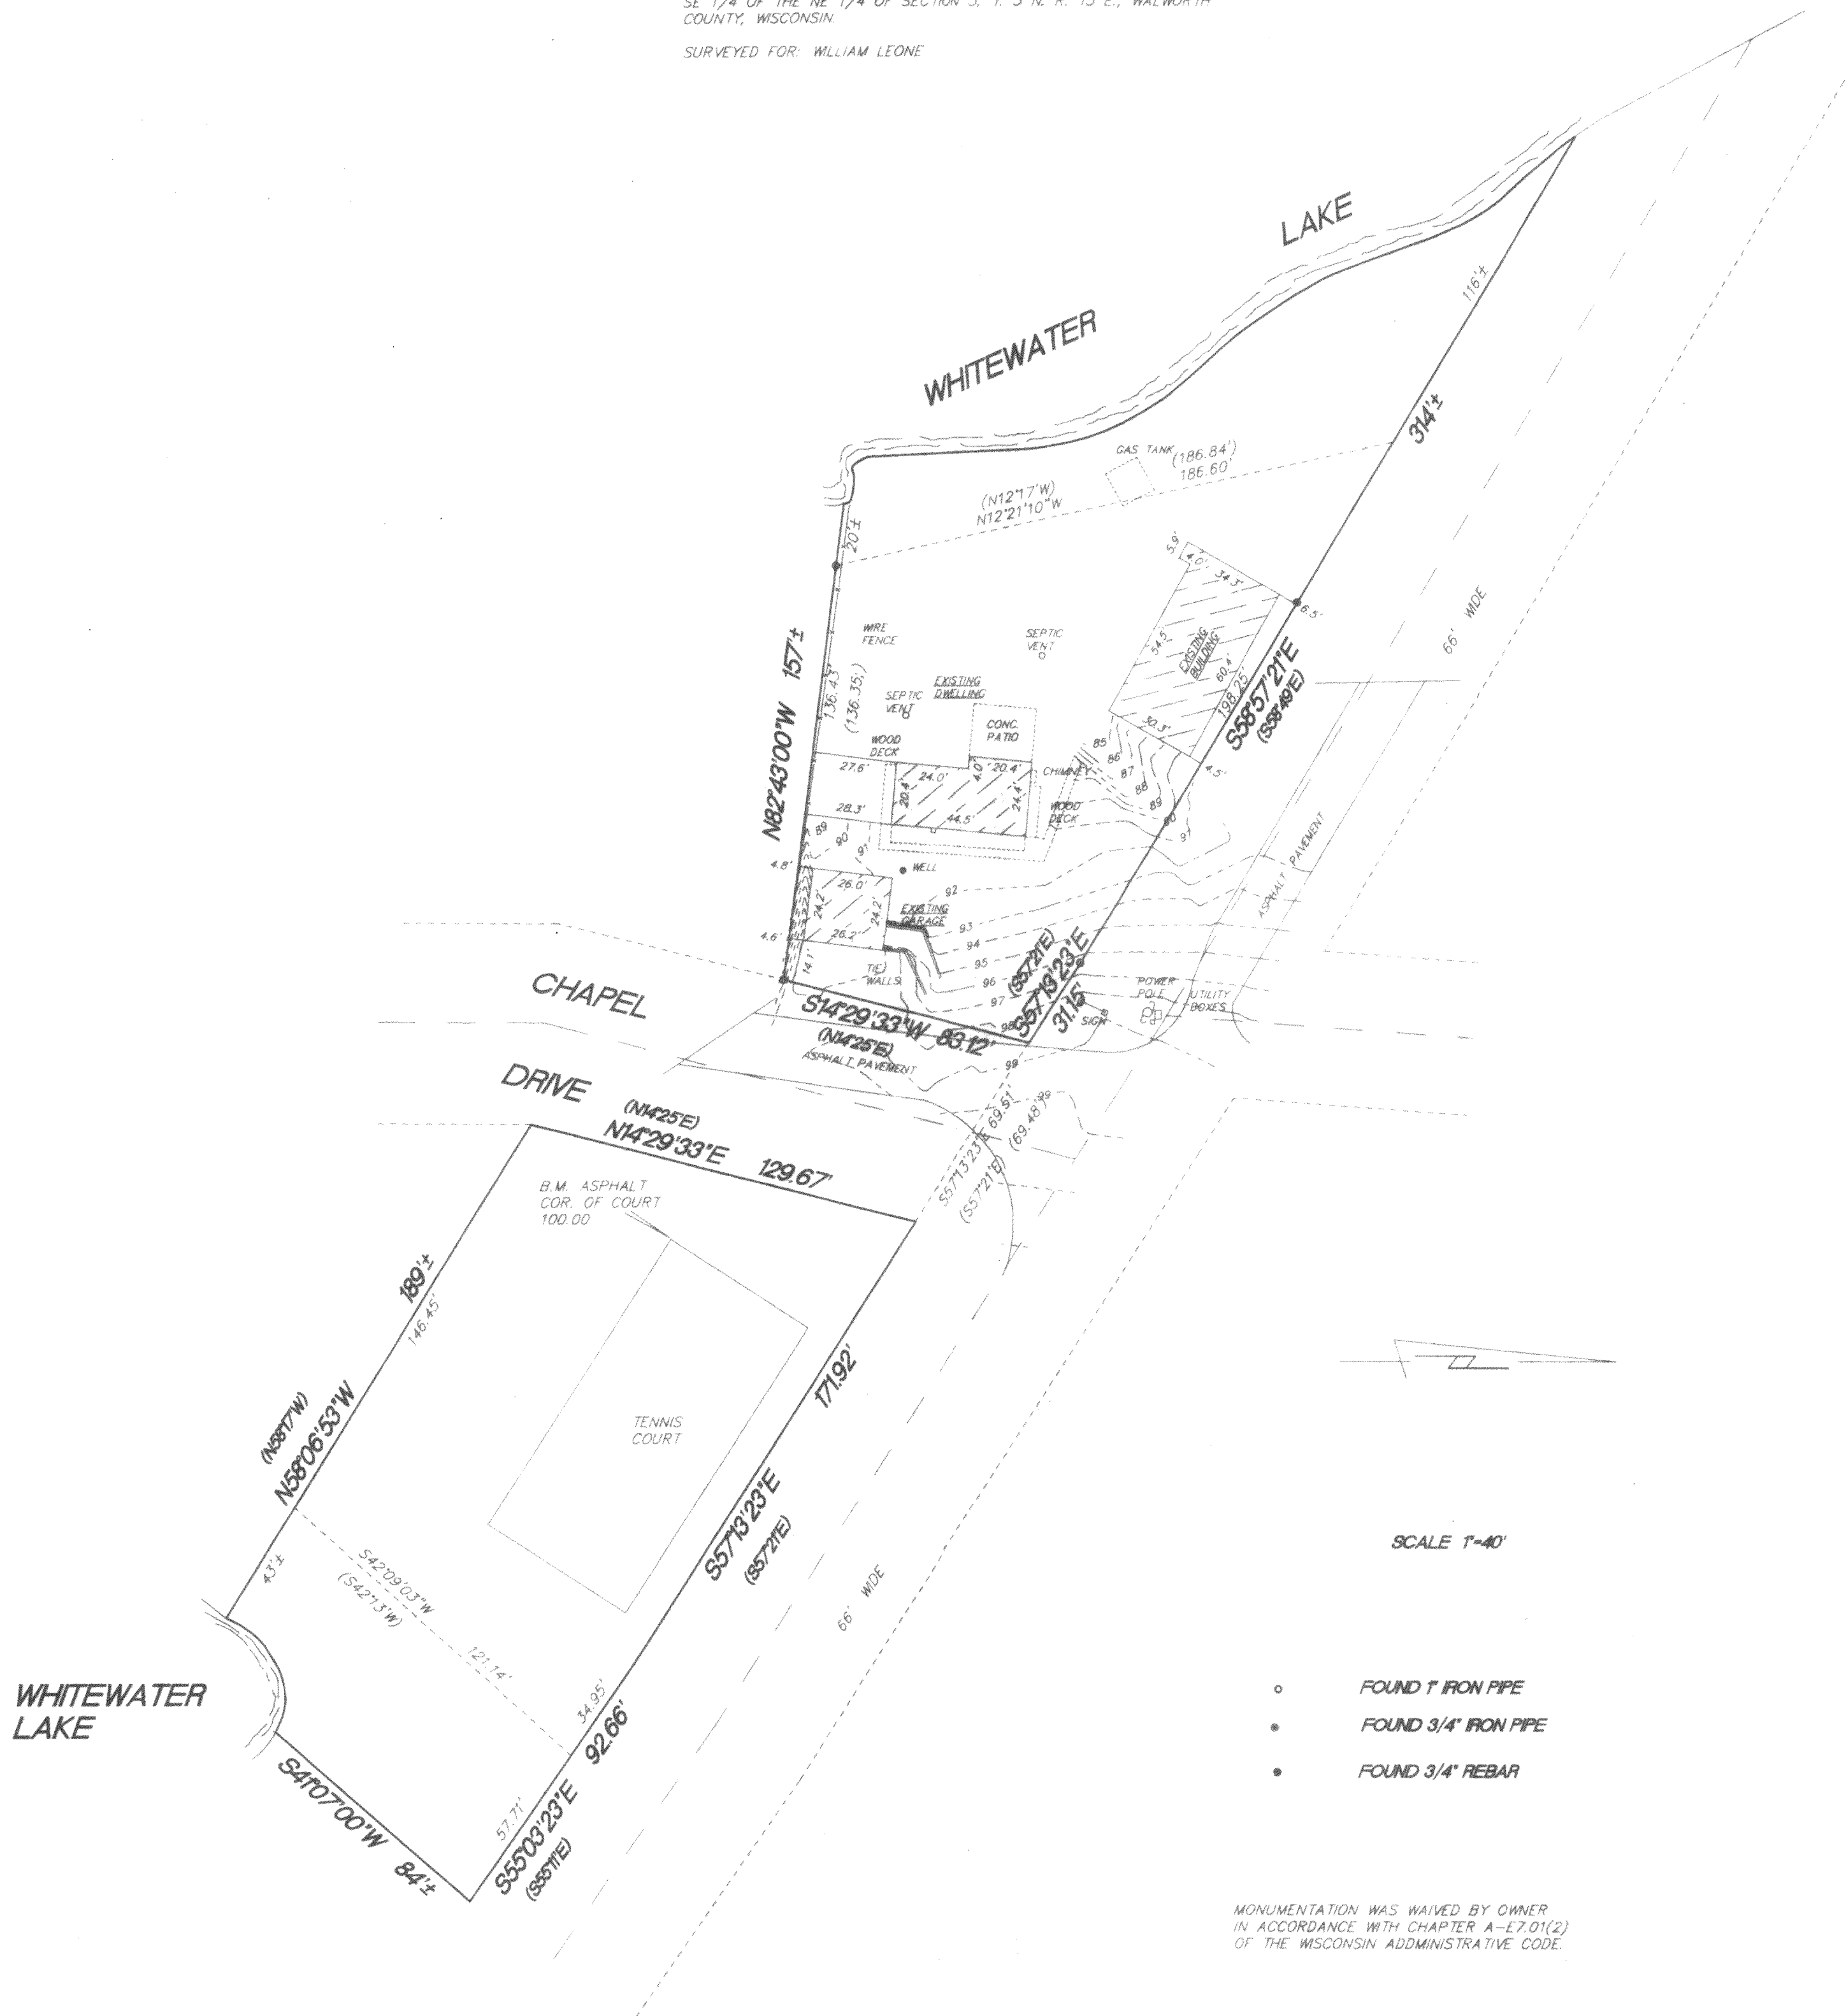

I hereby certify that I have surveyed the above property
and that the above map is a true representation thereof
and shows the size and location of the property
exterior boundaries, the location of all visible structures
and dimensions of all principal buildings thereon, boundary
fences, apparent easements, roadways and encroachments if
any.

"This survey is made for the use of the present owners of
the property, and also those who purchase, mortgage or
guarantee the title thereto within one year from date hereof."

KETTLE MORANE SURVEYING
P.O. Box 357
Eagle WI 53119
(262)594-3484

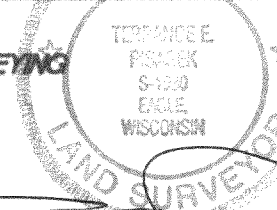

THIS IS NOT AN ORIGINAL SURVEY UNLESS THE SEAL IS RED.

6/20/01
DATE

TEP/DW
FIELD WORK BY

TEP
DRAWN BY

01100
JOB NUMBER

DCH-13 415-833
DCH-20