


135  
227  
351

LEGEND

O - IRON PIPE FOUND  
SCALE 1" = 30'



WHITEWATER  
LAKE

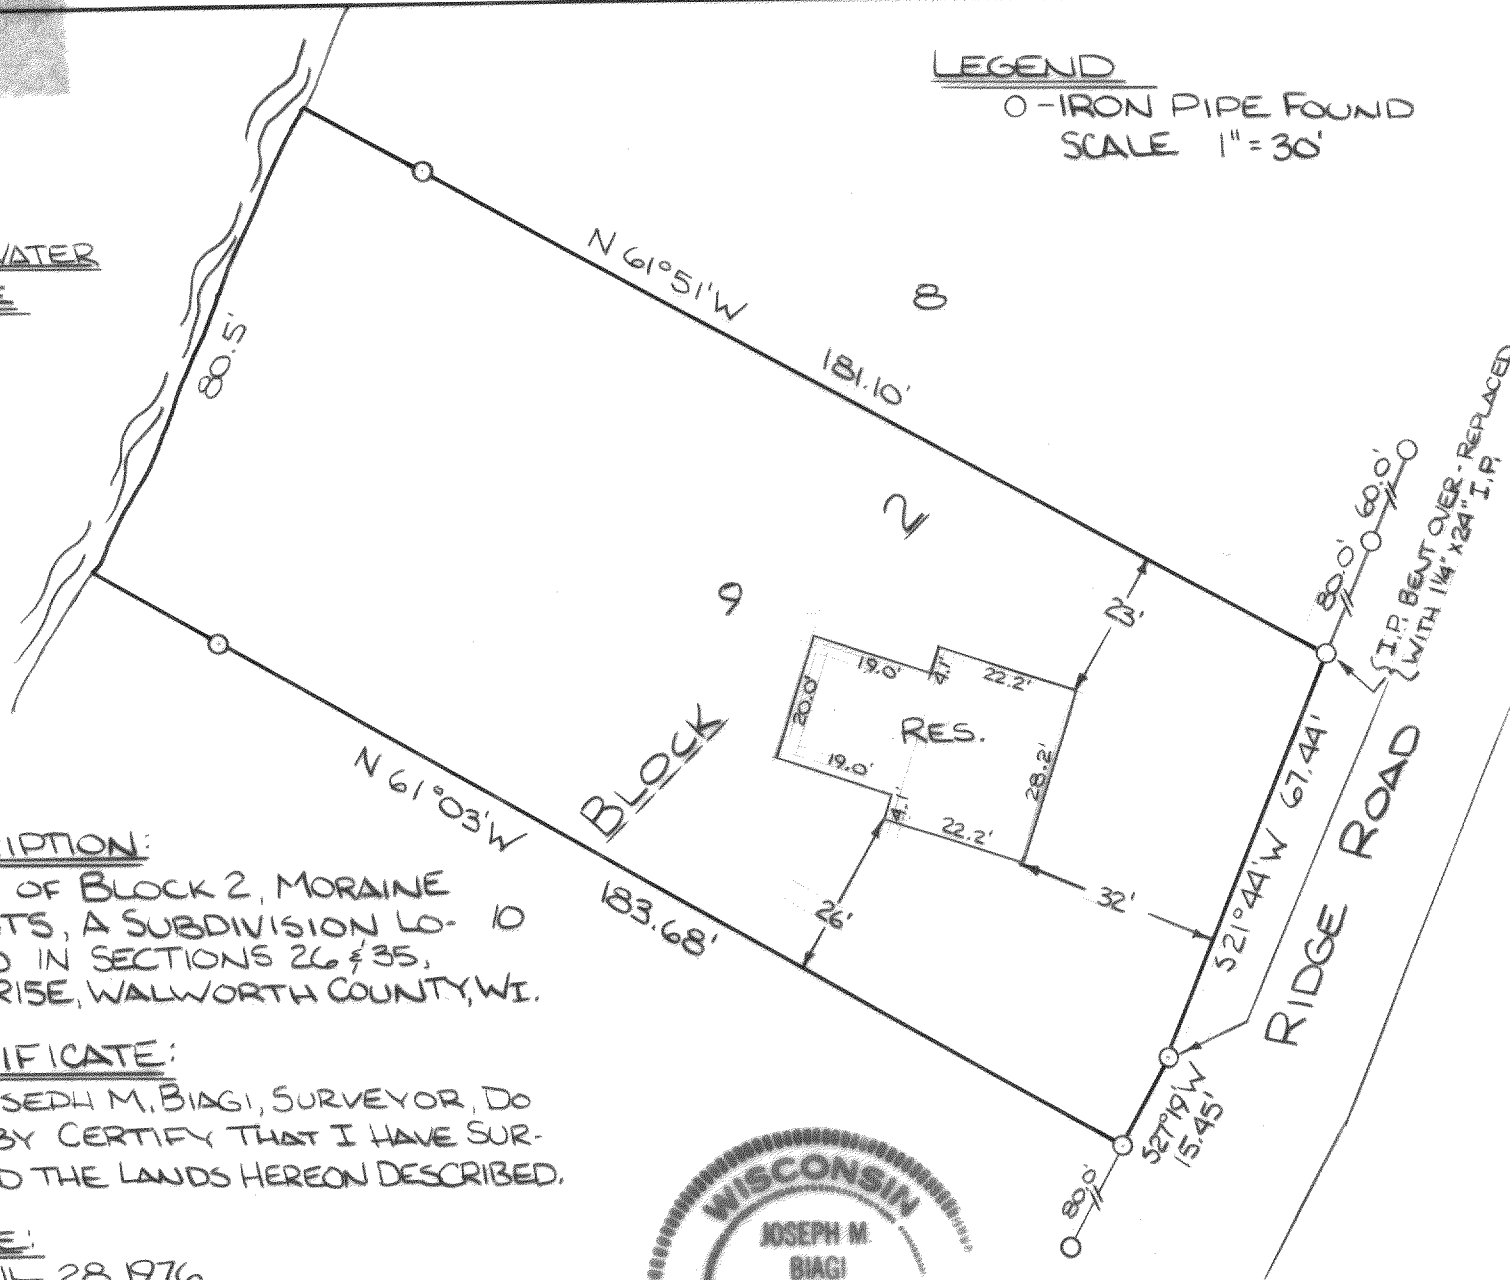

DESCRIPTION:

LOT 9 OF BLOCK 2, MORaine  
HEIGHTS, A SUBDIVISION LO- 10  
CATED IN SECTIONS 26 & 35,  
T4N, R1E, WALWORTH COUNTY, WI.


CERTIFICATE:

I, JOSEPH M. BIAGI, SURVEYOR, DO  
HEREBY CERTIFY THAT I HAVE SUR-  
VEYED THE LANDS HEREON DESCRIBED.

DATE:

APRIL 28, 1976

*Joseph M. Biagi*  
JOSEPH M. BIAGI S-12

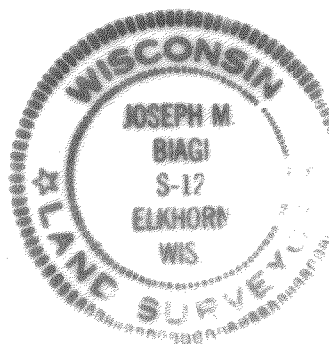

NOTE:

SEE ATTACHED TITLE CO. CERTIF-  
ICATE.


SURVEYORS CERTIFICATE

LOT 9, BLOCK 2, MORaine HEIGHTS SUB.

I, Joseph M. Biagi, have surveyed the above described property and the above map is a true representation thereof and shows the size and location of the property, its exterior boundaries, the location and dimensions of all structures thereon, fences, apparent easements and roadways and visible encroachments, if any.

This survey is made for the exclusive use of the present owners of the property, and also those who purchase, mortgage, or guarantee the title thereto within one (1) yeat from date hereof; and as to them I warrant the accuracy of said survey and map.

Dated at Elkhorn Wis, this 28<sup>th</sup> day of April,  
1976.

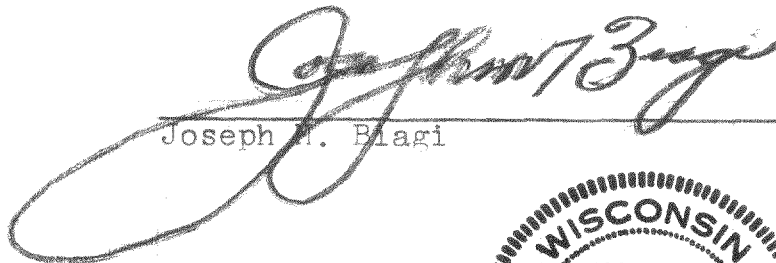  
\_\_\_\_\_  
Joseph M. Biagi S #12



415-93