
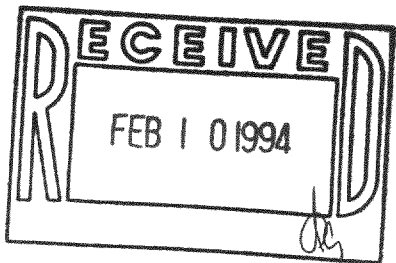


Plat of Survey

Survey For: WOLTER BROS. BUILDERS
Location: Farm Village Lane

MIKE MARTIN


Description: LOT 3 FARM VILLAGE, located in the Southeast 1/4 of the Southwest 1/4 and the Southwest 1/4 of the Southeast 1/4 and the Southeast 1/4 of the Southeast 1/4 of Section 25, Town 4 North, Range 16 East, Town of La Grange, County of Walworth, State of Wisconsin.

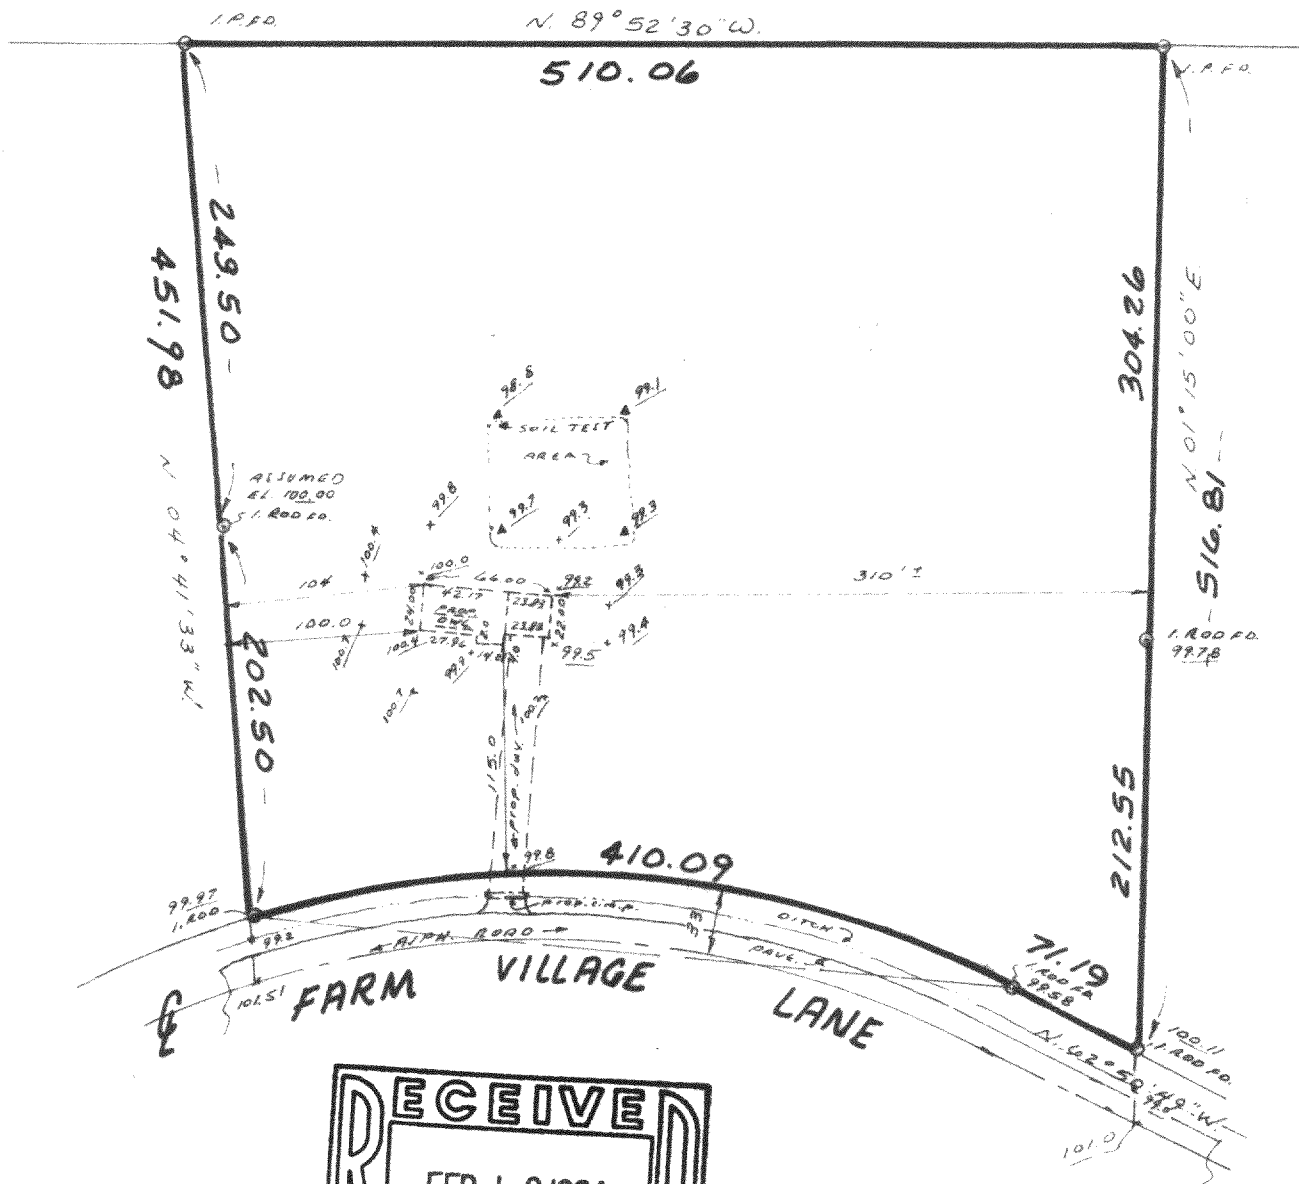


CURVE DATA

RAD. = 530.40
CHD. = 399.75
BRG. = N. 64° 59' 49" W.

NOTE:
PROP DWELLING STAKED
10' LARGER!
PROP. FIN. YARD GRADE =
EL. 102.00

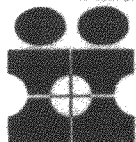

**INTERLINE SURVEY
SERVICES, INC.**
11221 W. FOREST HOME AVE
HALES CORNERS, WISCONSIN 53130
PHONE 425-2060

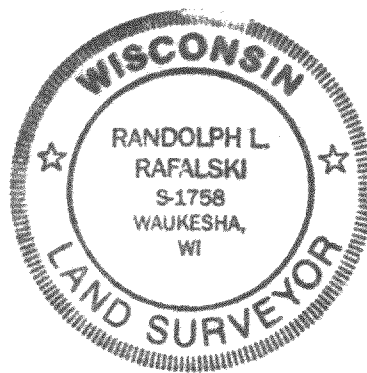

State of Wisconsin) ss
Milwaukee County

SURVEY CERTIFICATE

Scale: 1" = 100'

We, Interline Survey Services, Inc., certify that we have surveyed the above described property and the above map is a true representation thereof, and shows the size and location of the property, its exterior boundaries, the location and dimensions of all visible structures thereon, fences, apparent easements and roadways and visible encroachments, if any.

This survey is made for the exclusive use of the present owners of the Property, and also those who purchase, mortgage, or guarantee the title thereto, within one (1) year from date hereof.

Randolph L. Rafalski
Wisconsin Registered Land Surveyor

Date: 9/20/93
Job No.: 22332



"RECERTIFICATION"

Plat of Survey

Survey For: WOLTER BROS. BUILDERS
Location: Farm Village Lane

MIKE MARTIN

Description: LOT 3 FARM VILLAGE, located in the Southeast 1/4 of the Southwest 1/4 and the Southwest 1/4 of the Southeast 1/4 and the Southeast 1/4 of the Southeast 1/4 of Section 25, Town 4 North, Range 16 East, Town of La Grange, County of Walworth, State of Wisconsin.

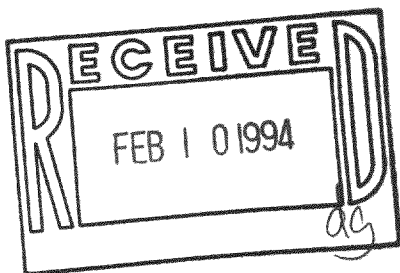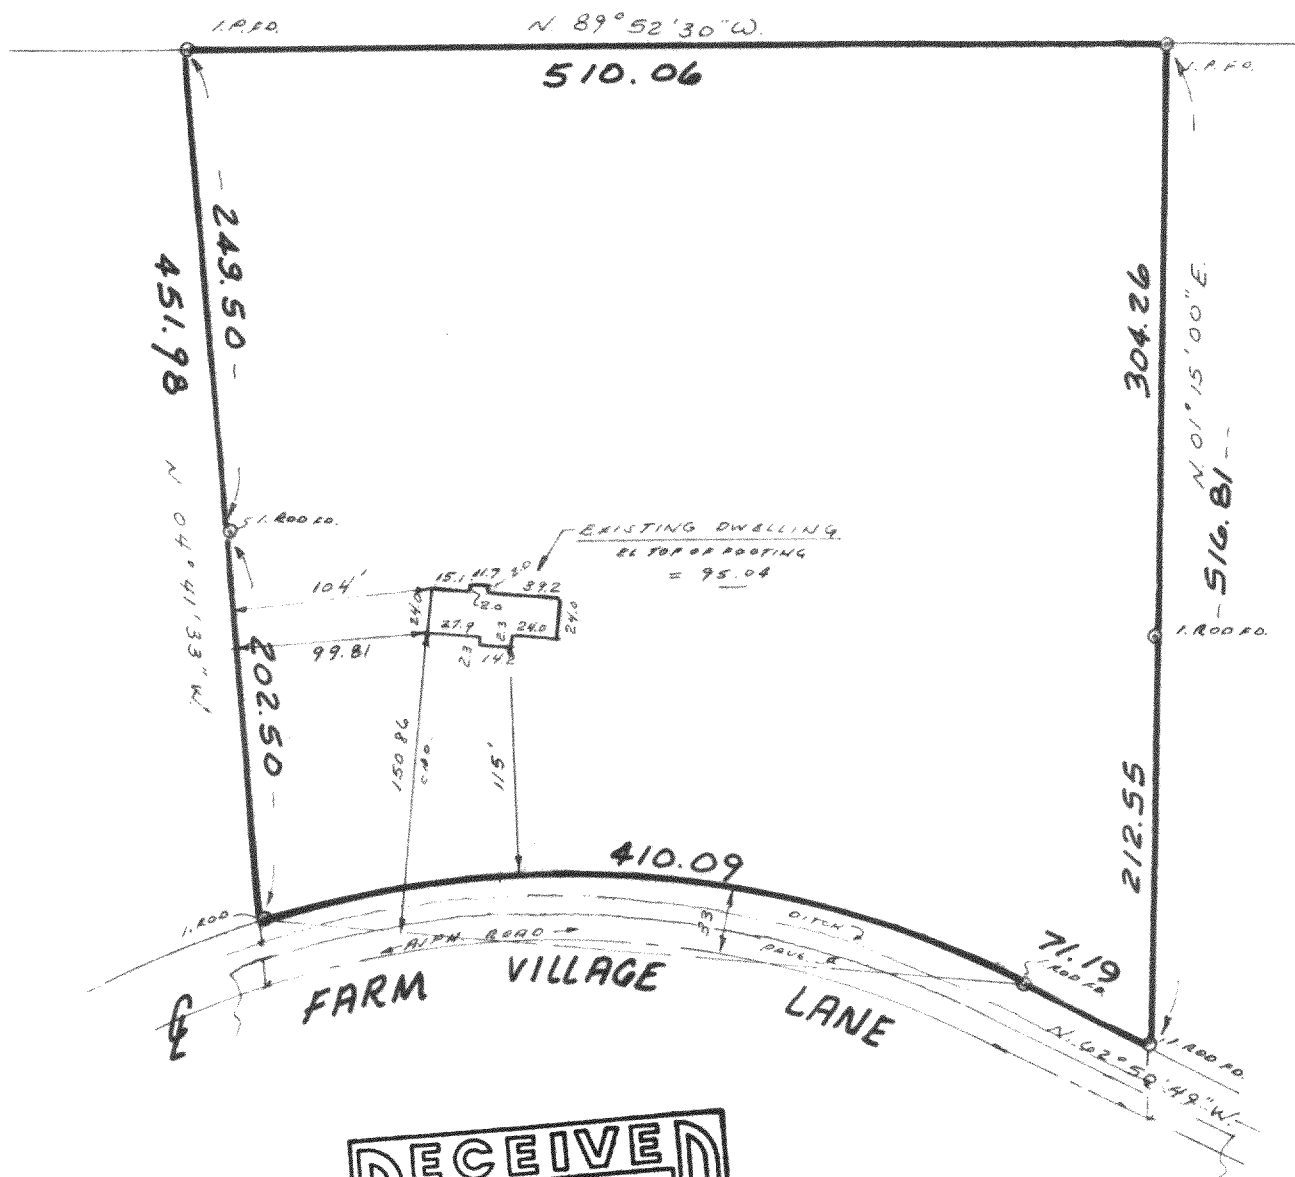


CURVE DATA

RAD. = 530.40


CHD. = 399.75

BRG. = N 84° 59' 49" W

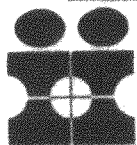

**INTERLINE SURVEY
SERVICES, INC.**
11221 W. FOREST HOME AVE
HALES CORNERS, WISCONSIN 53130
PHONE 425-2060

SURVEY CERTIFICATE

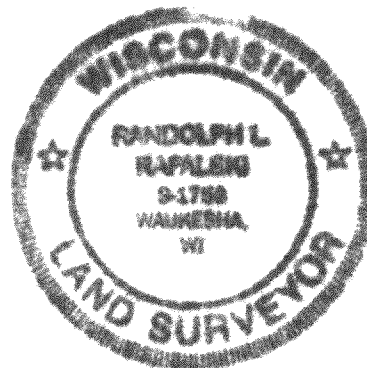

Scale: 1" = 100'

State of Wisconsin) ss
Milwaukee County

We, Interline Survey Services, Inc., certify that we have surveyed the above described property and the above map is a true representation thereof, and shows the size and location of the property, its exterior boundaries, the location and dimensions of all visible structures thereon, fences, apparent easements and roadways and visible encroachments, if any.

This survey is made for the exclusive use of the present owners of the Property, and also those who purchase, mortgage, or guarantee the title thereto, within one (1) year from date hereof.

Randolph L. Rafalek

Wisconsin Registered Land Surveyor

Date: 12/9/93
Job No.: 22581