




PLAT OF SURVEY

of
Lots 5 and 6 of Baywood Park Subdivision,
located in the Northeast 1/4 of Section 2, Town 3 North,
Range 16 East, Town of Sugar Creek, and the Southeast 1/4
of Section 35, Town 4 North, Range 16 East, Town of
La Grange, Walworth County, Wisconsin.

Surveyed for: Jeff & Kris Wiswell
RFD 1
Elkhorn, Wisconsin. 53121

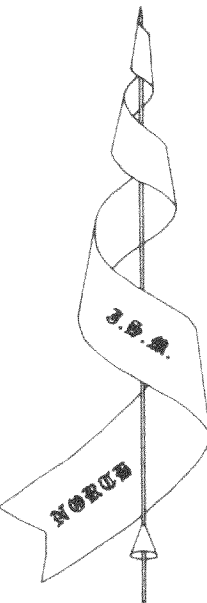

Bearings referenced to the Subdivision
Plat of Baywood Park Subdivision.

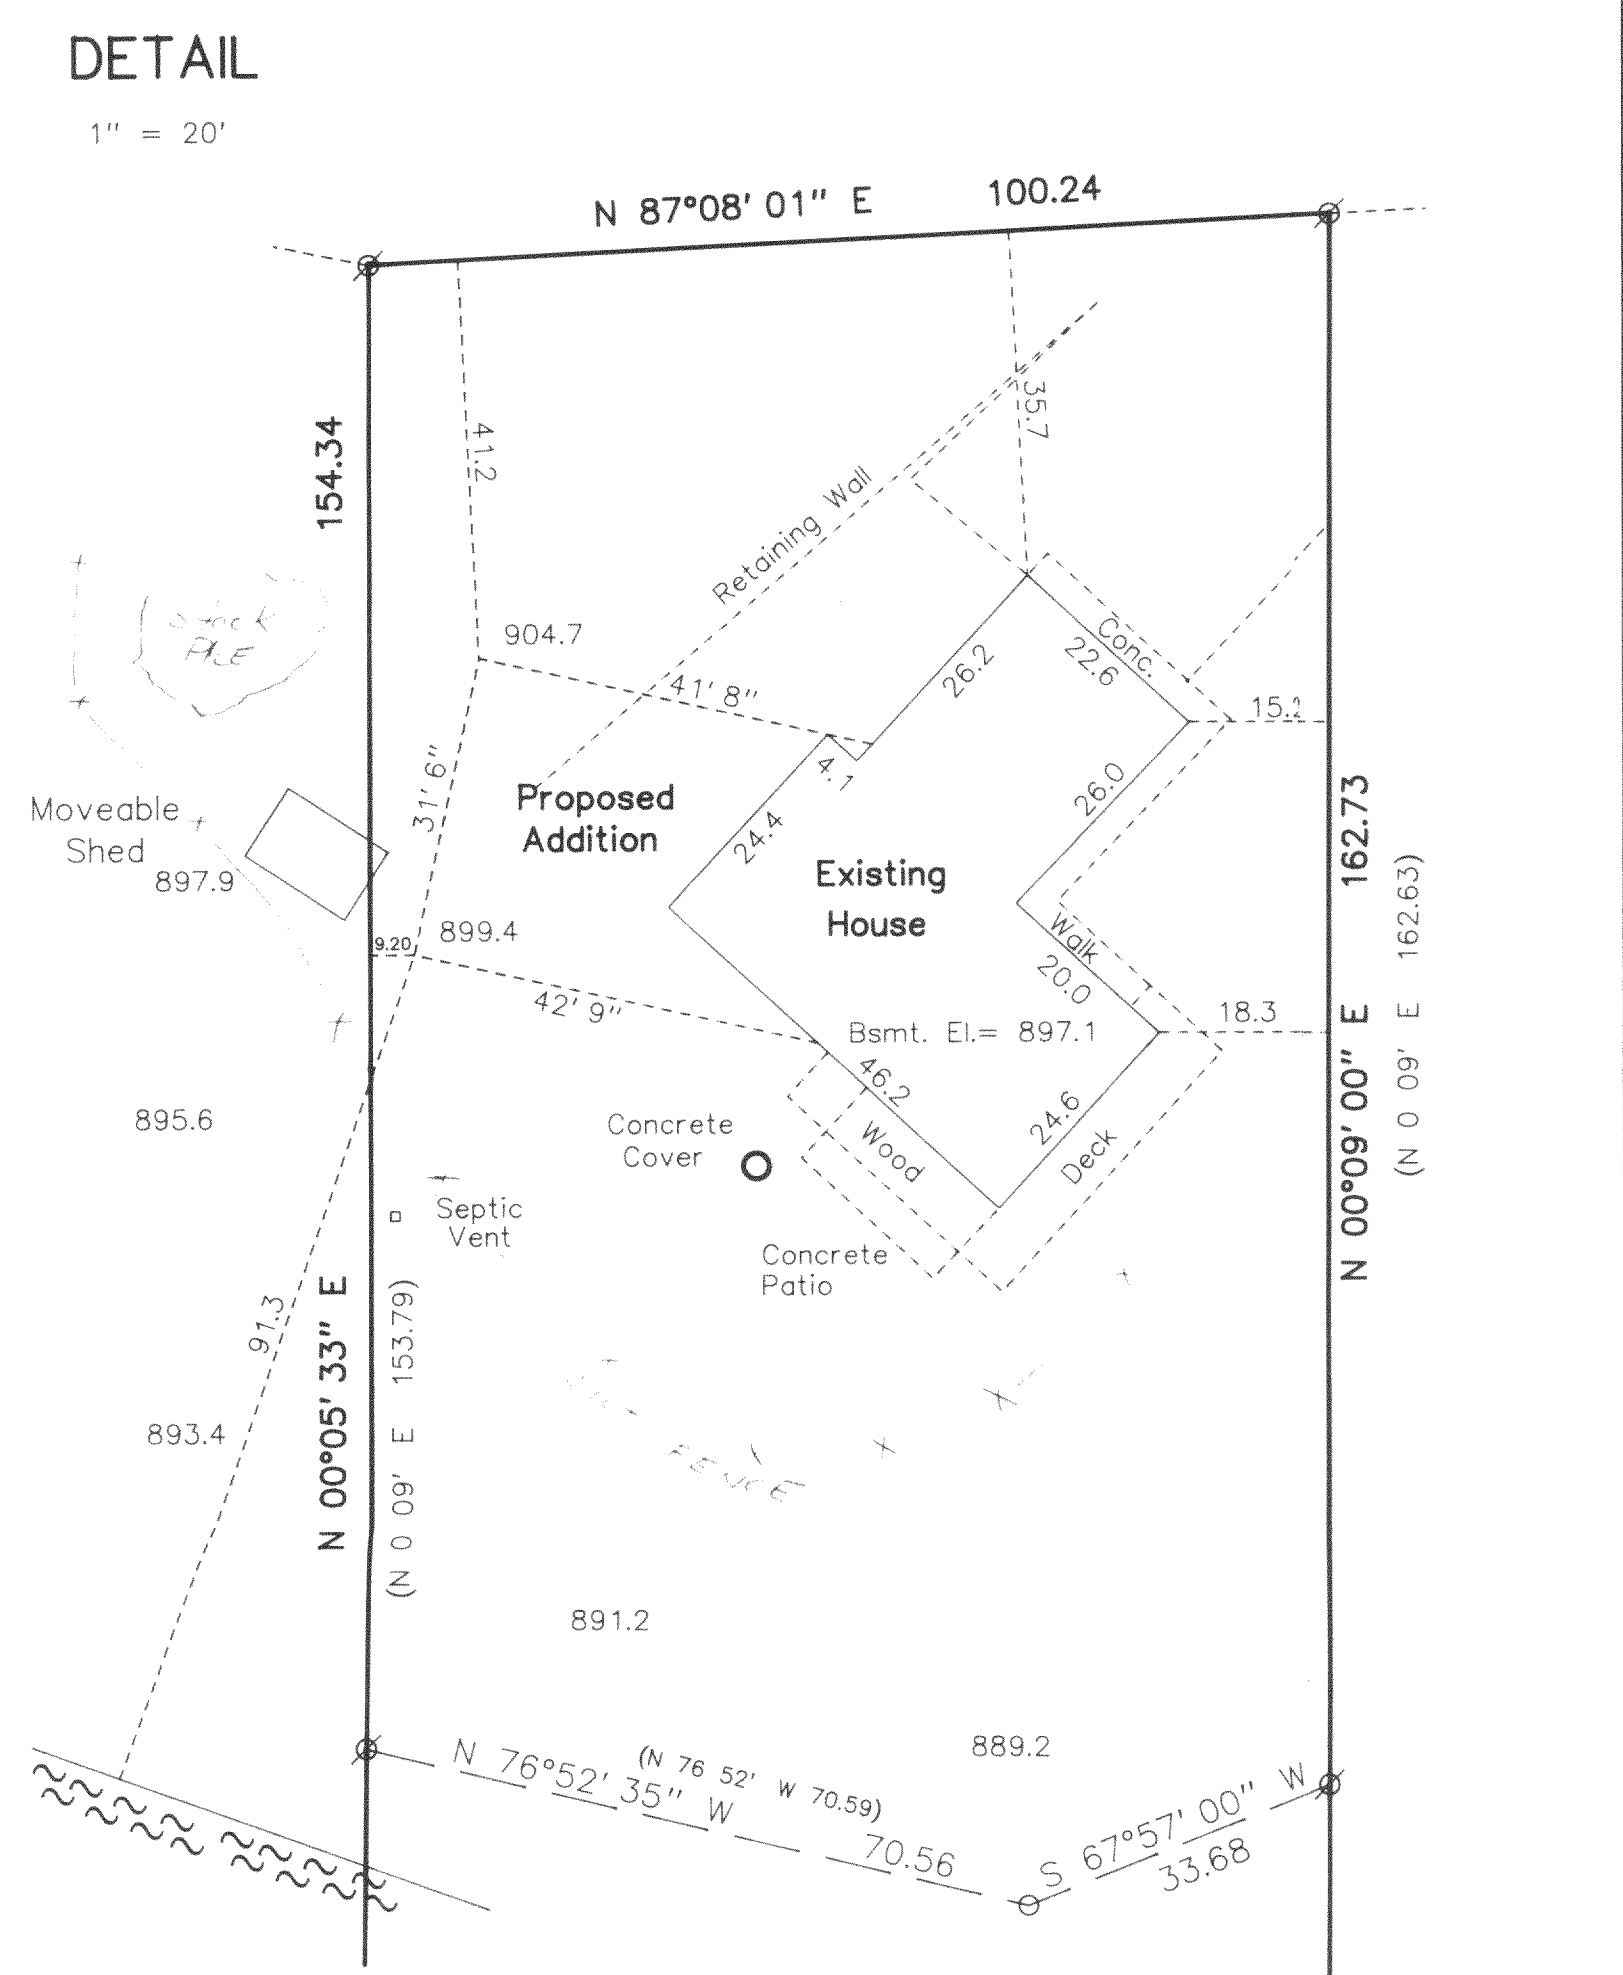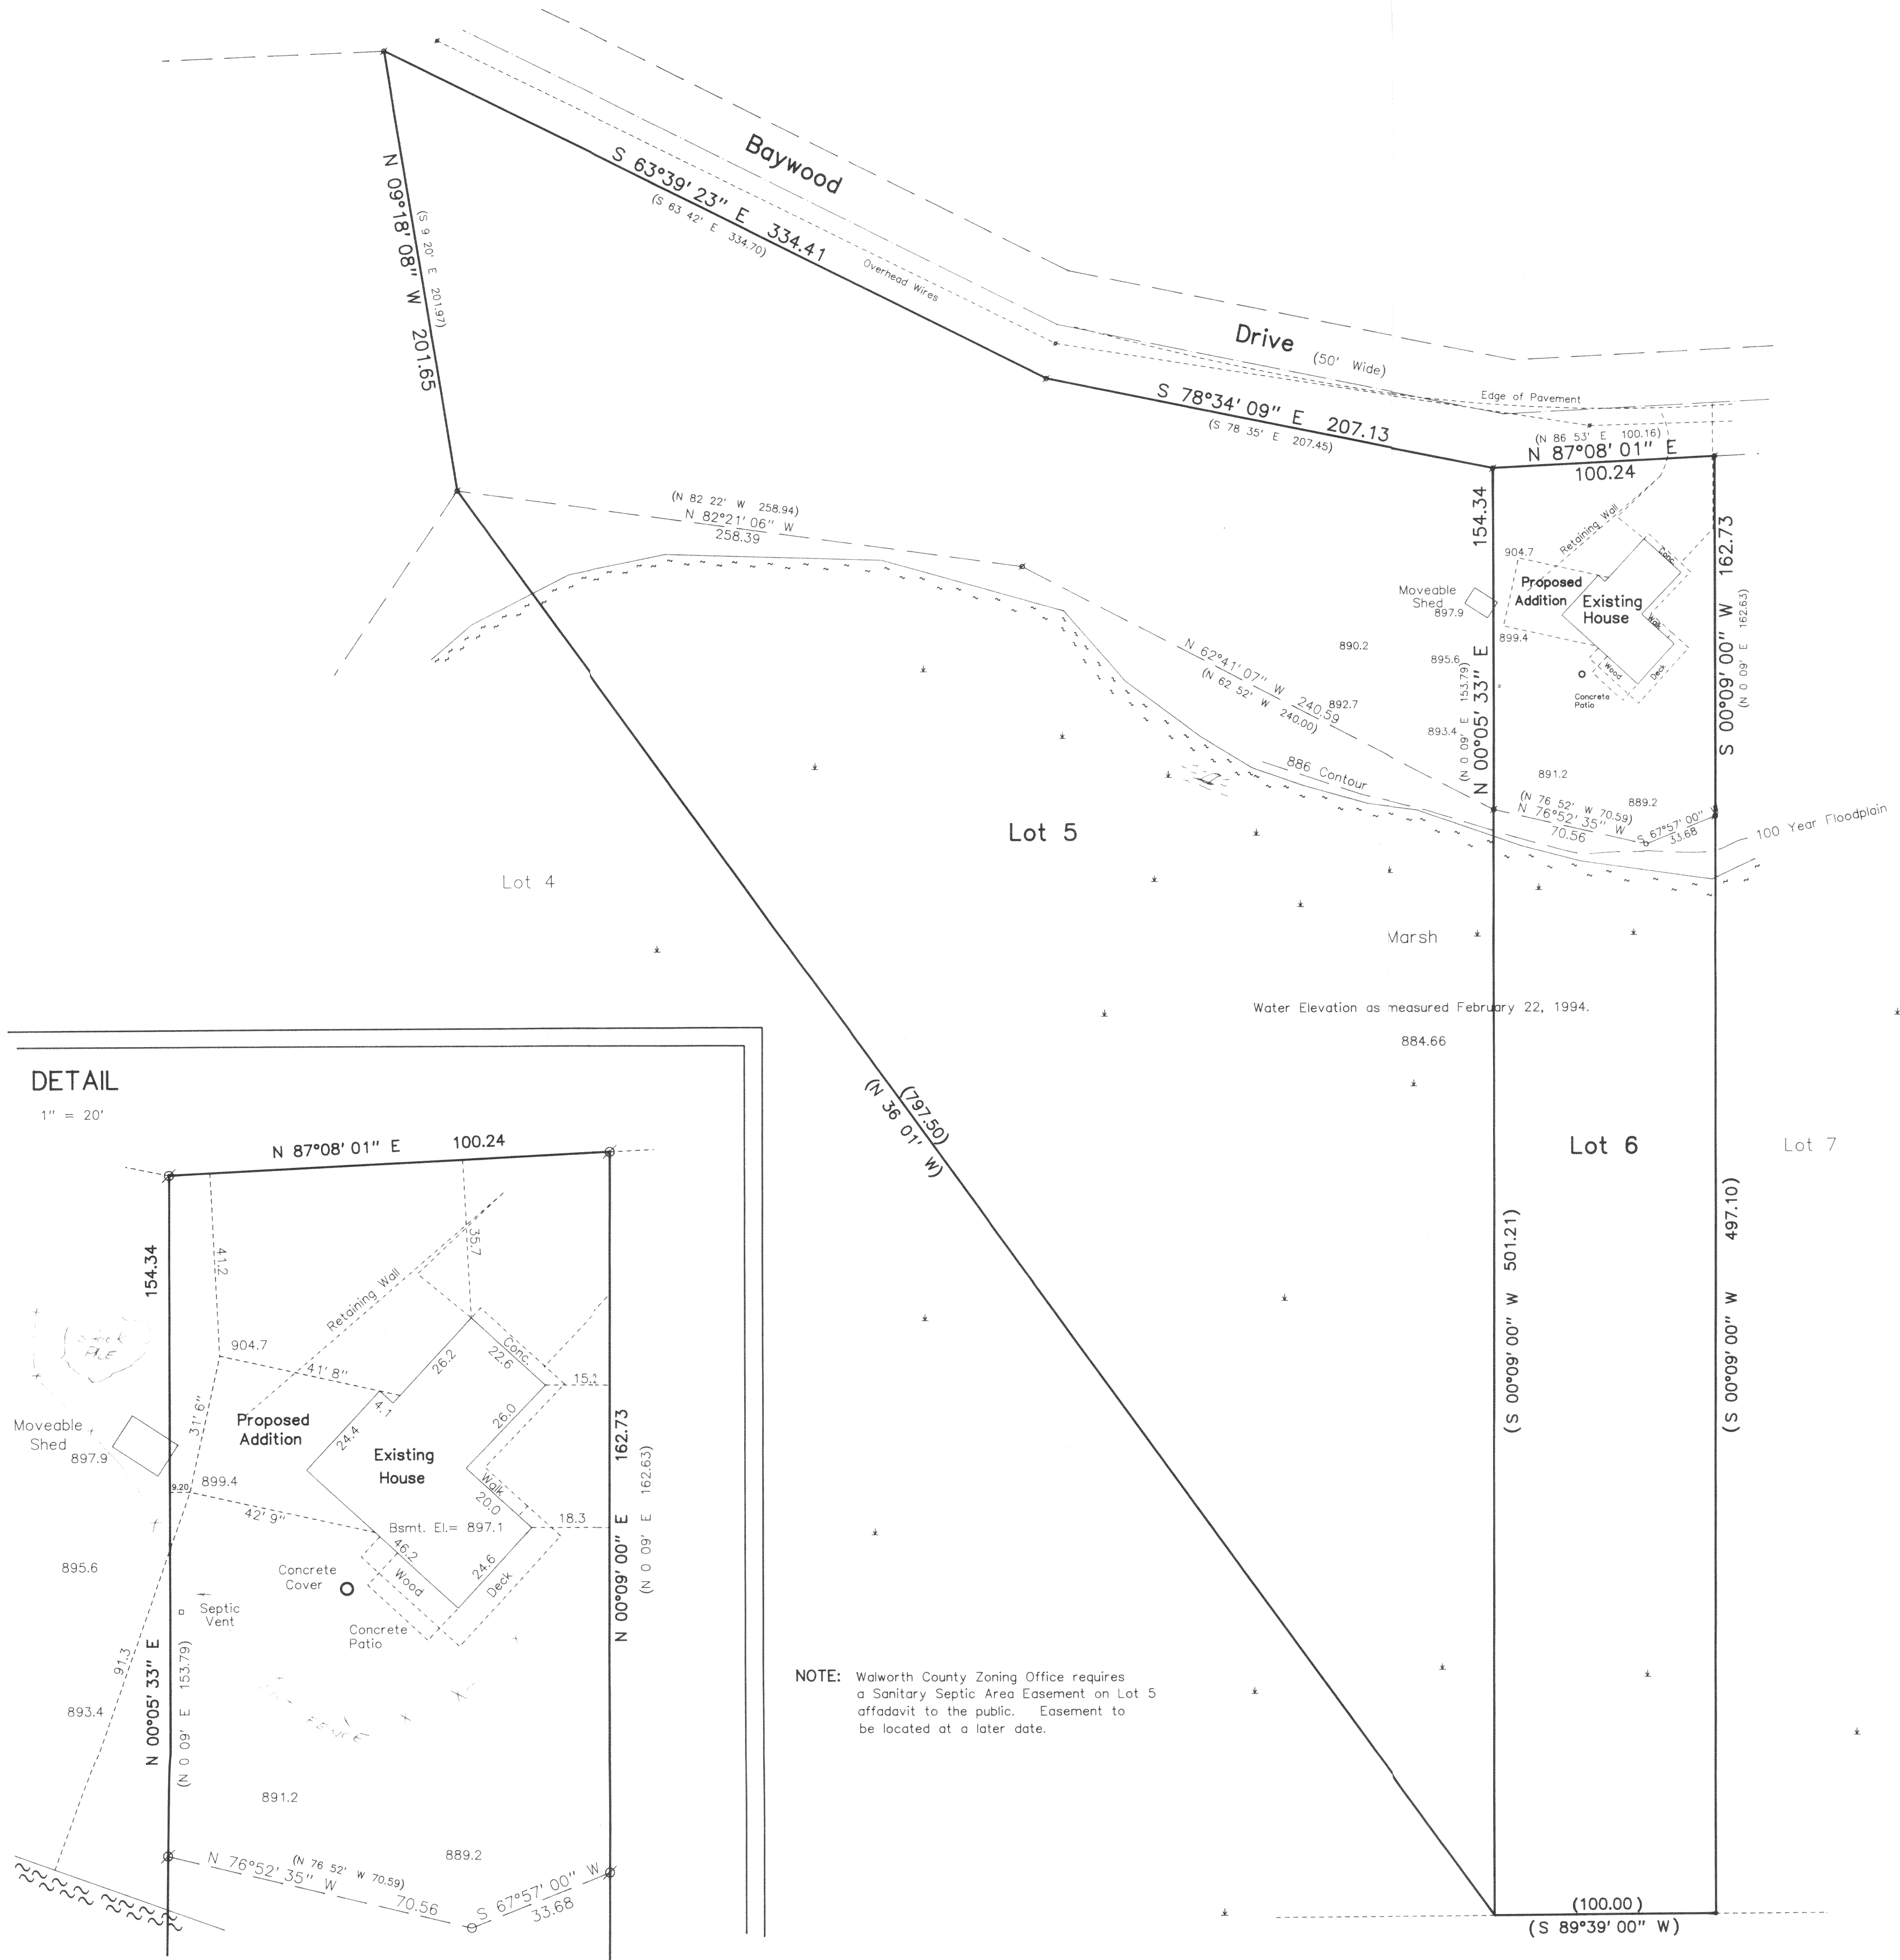

NOTE: Walworth County Zoning Office requires
a Sanitary Septic Area Easement on Lot 5
affadavit to the public. Easement to
be located at a later date.

JENSEN SURVEYING & MAPPING S.C.

45 South Wisconsin Street P.O. Box 322
Elkhorn, Wisconsin. 53121
Telephone & Facsimile (414) 723-3434

Mapping date: February 24, 1994.



Revisions:

Legend

- Found Iron Pipe
- Set Iron Rod 3/4" dia.
- Recorded as Dimension
- Utility Pole



Scale in Feet

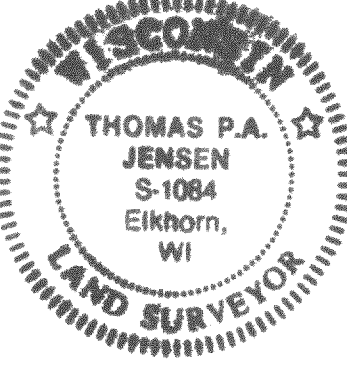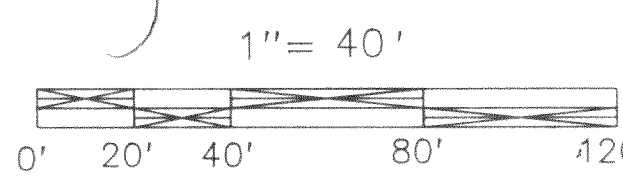

Copyright © 1994 by Jensen Surveying & Mapping S.C.

All rights reserved. No part of this survey plat may be reproduced
or transmitted in any form by any means — graphic, electronic, or
mechanical, including photocopying, tracing, or information storage
and retrieval systems — without permission in writing from Thomas
P.A. Jensen, Jensen Surveying & Mapping S.C..

I, Thomas P.A. Jensen, Wisconsin Registered Land Surveyor, do
hereby certify that this survey was performed by me, or under my
direction in full compliance with the owner's / agent's instructions
and Chapter A-E 7 of the Wisconsin Administrative Code "Minimum
Standards for Property Surveys"; and that this map is as accurate
representation thereof to the best of my knowledge and belief.

Note: This survey plat is not
certified unless signed
and sealed in red ink.

Thomas P.A. Jensen R.L.S. 1084

Sheet no. 1 of 1 Sheets

Job Reference Number: 1994.006

H&P-S
H&P-L
S&P-S
S&P-L