

ABERNATHY and ASSOCIATES

Kenneth B. Abernathy Jr.


Wisconsin Registered Land Surveyor S-1594

Rt. 3, Box 273  
Elkhorn, Wisconsin 53121  
Phone: (414) 723-4260 (office)  
(414) 723-4813 (residence)


PLAT OF SURVEY

LOT 2, FAIRBLUFF ESTATES ADDITION NO. 1  
SUBDIVISION, LOCATED IN THE SOUTHWEST 1/4 OF  
THE SOUTHEAST 1/4 OF SECTION 5, TOWN 4  
NORTH, RANGE 16 EAST, TOWN OF LAGRANGE,  
WALWORTH COUNTY, WISCONSIN.

OWNERS: MARK & CHERYL MIRITZ  
W424 POWERS LAKE ROAD  
GENOA CITY, WIS. 53128

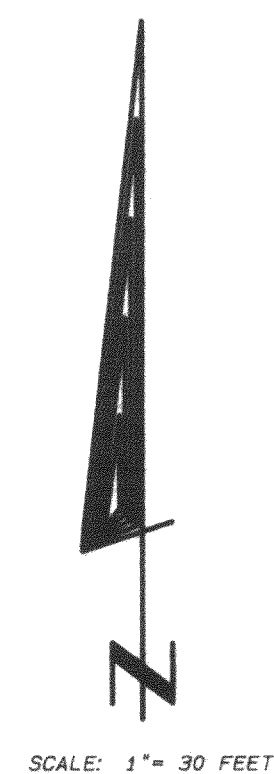

SCALE: 1" = 30 FEET

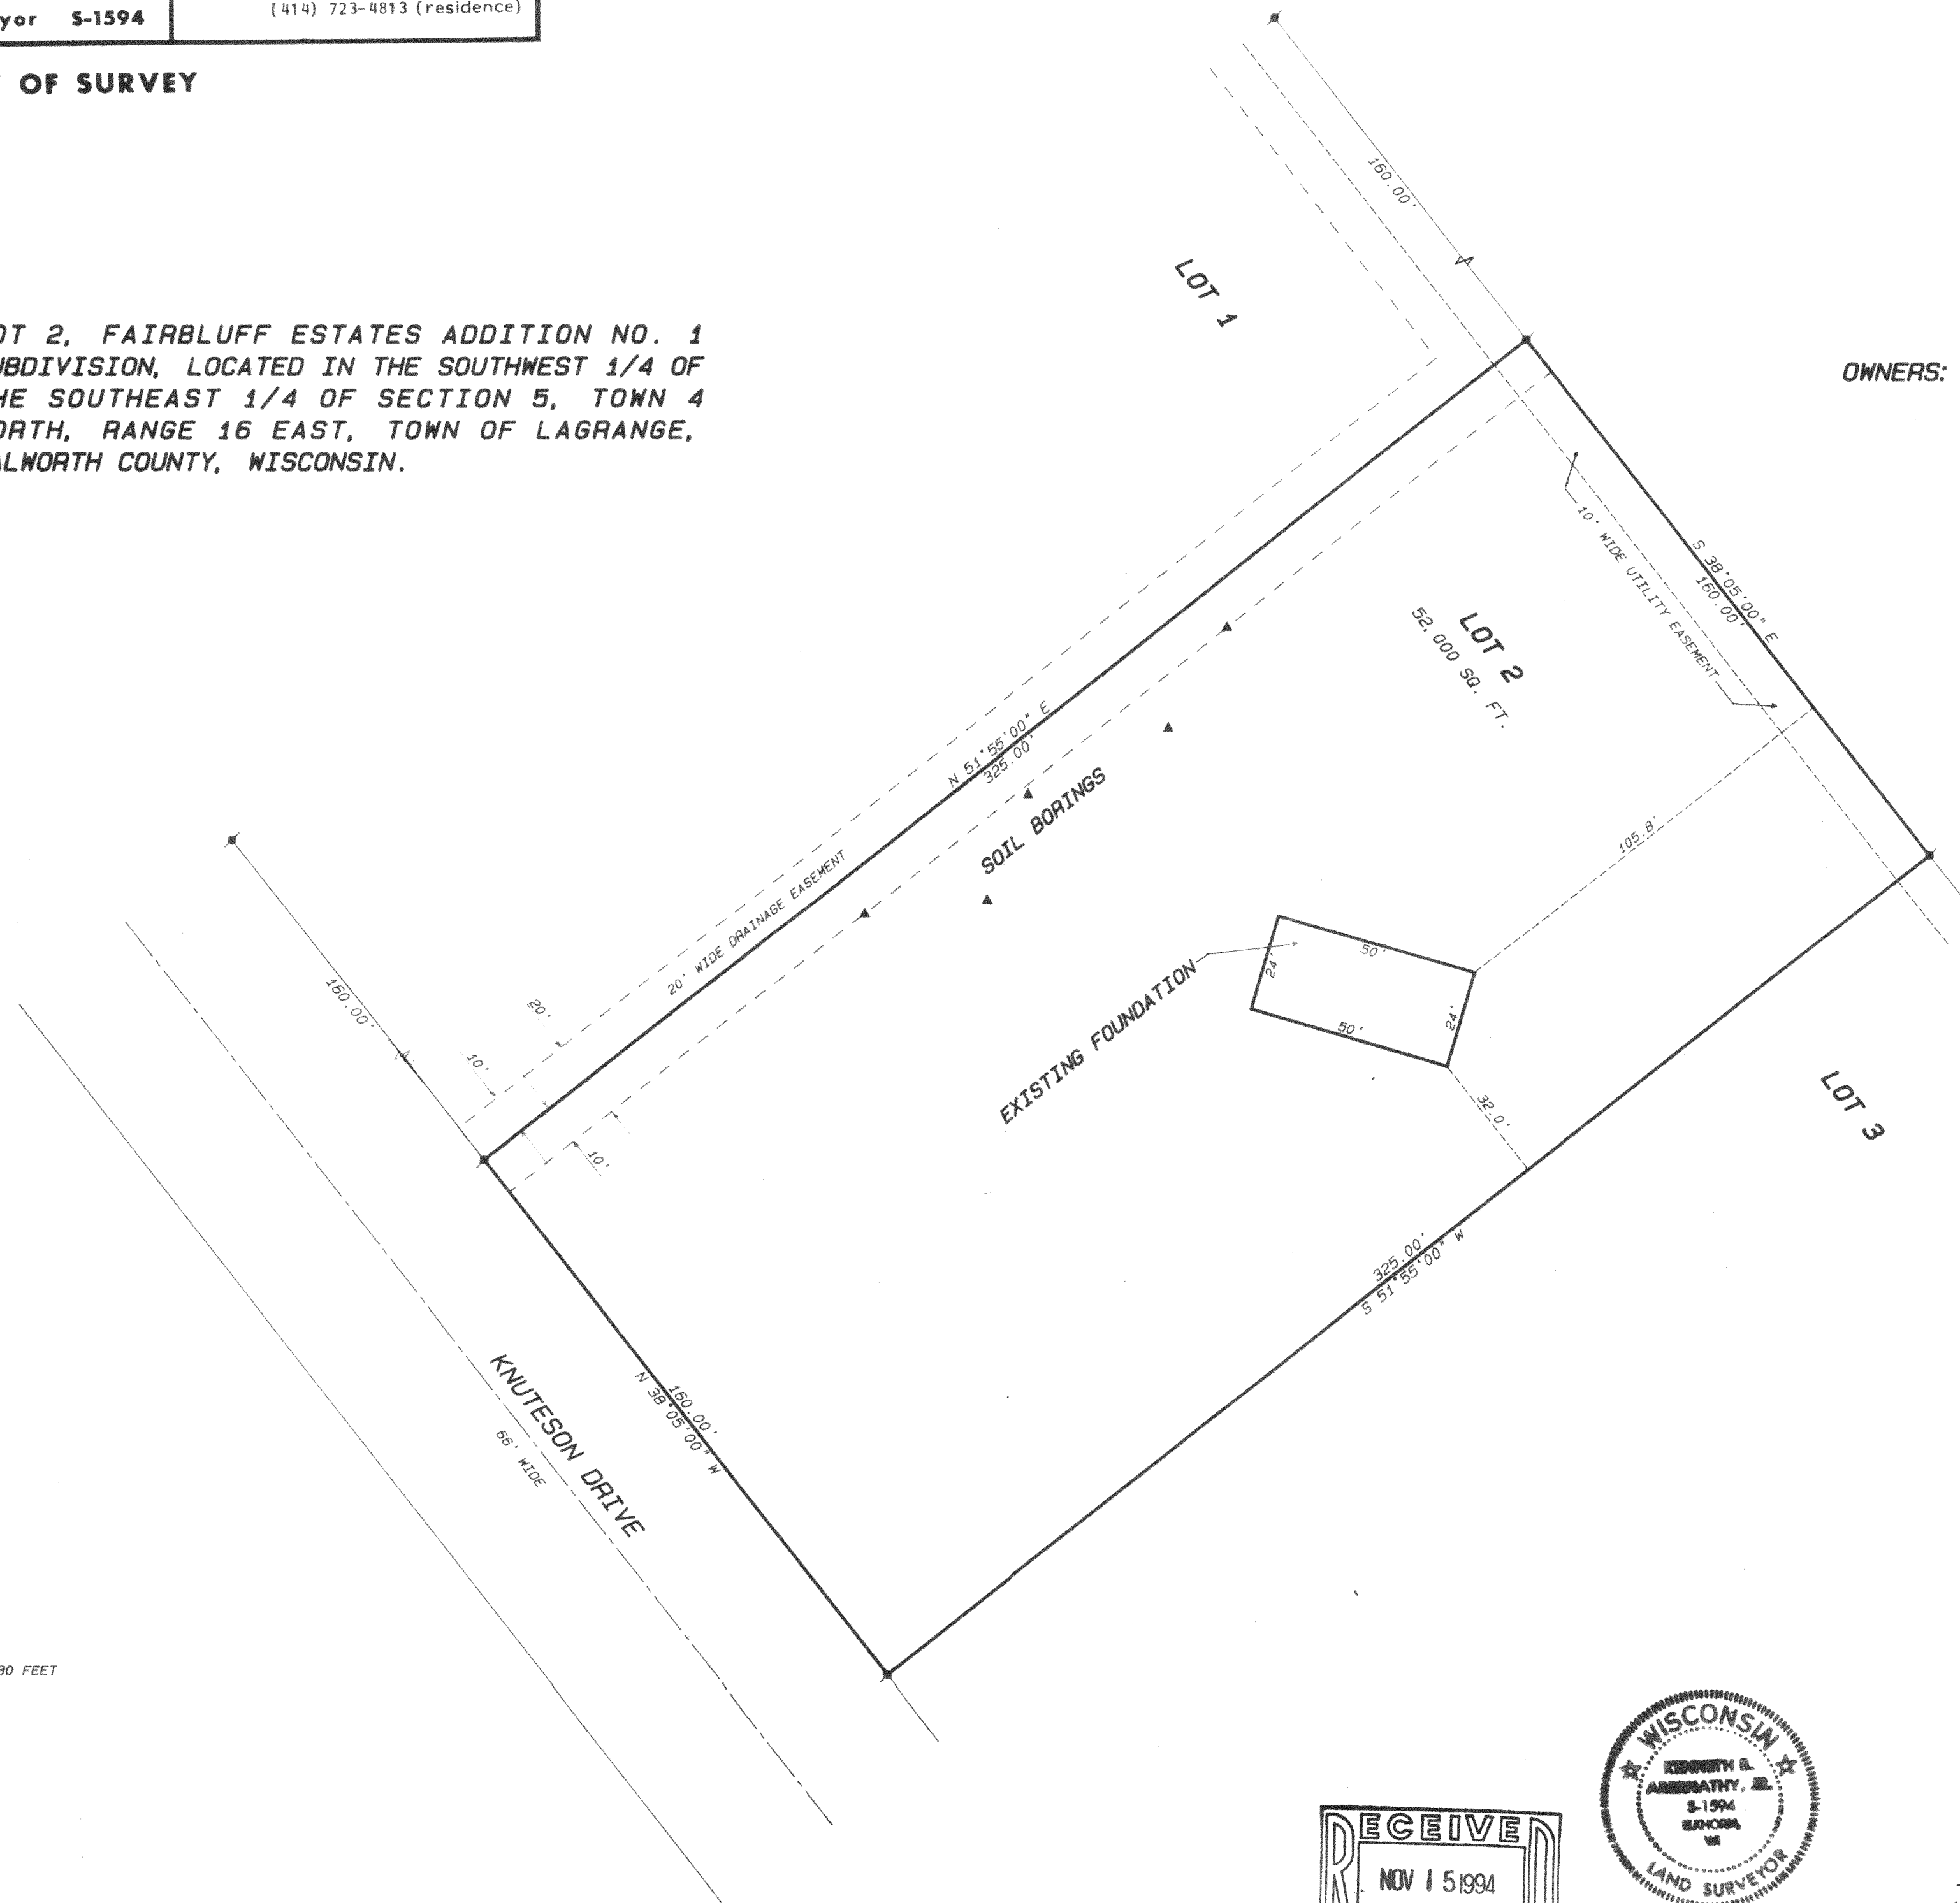

Legend

- FOUND IRON PIPE
- FOUND IRON ROD
- FOUND BRASS CAPPED MONUMENT
- FOUND CONCRETE MONUMENT
- CHISEL CUT IN CONCRETE
- SET IRON ROD, 24" LONG, WEIGHING 1.5 LBS./LINEAL FT., 3/4" DIA.
- SET IRON ROD, 30" LONG, WEIGHING 4.5 LBS./LINEAL FT., 1-11/16" DIA.
- (xx) RECORDED AS DIMENSION
- EXISTING FENCE

SCALE: 1" = 30 FEET


"I hereby certify that I have surveyed the above described property and that the above map is a true representation thereof and shows the size and location of the property, its exterior boundaries, the location of all visible structures and dimensions of all principal buildings thereon, boundary fences, apparent easements, roadways and visible encroachments, if any."

"This survey is made for the use of the present owners of the property, and also those who purchase, mortgage, or guarantee the title thereto within one year from date hereof."

*Kenneth B. Abernathy Jr.*

KENNETH B. ABERNATHY, JR.  
WISCONSIN REGISTERED LAND SURVEYOR,  
S-1594



Date: SEPT. 9, 1994 Job No. 94612AB

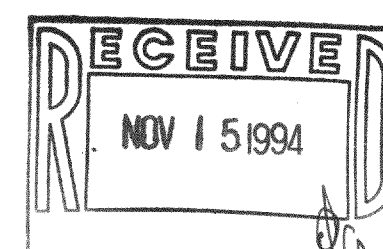

PLAT OF SURVEY


LOT 2, FAIRBLUFF ESTATES ADDITION NO. 1  
SUBDIVISION, LOCATED IN THE SOUTHWEST 1/4 OF  
THE SOUTHEAST 1/4 OF SECTION 5, TOWN 4  
NORTH, RANGE 16 EAST, TOWN OF LAGRANGE,  
WALNORTH COUNTY, WISCONSIN.

OWNERS: MARK & CHERYL MIRITZ  
W424 POWERS LAKE ROAD  
GENOA CITY, WIS. 53128

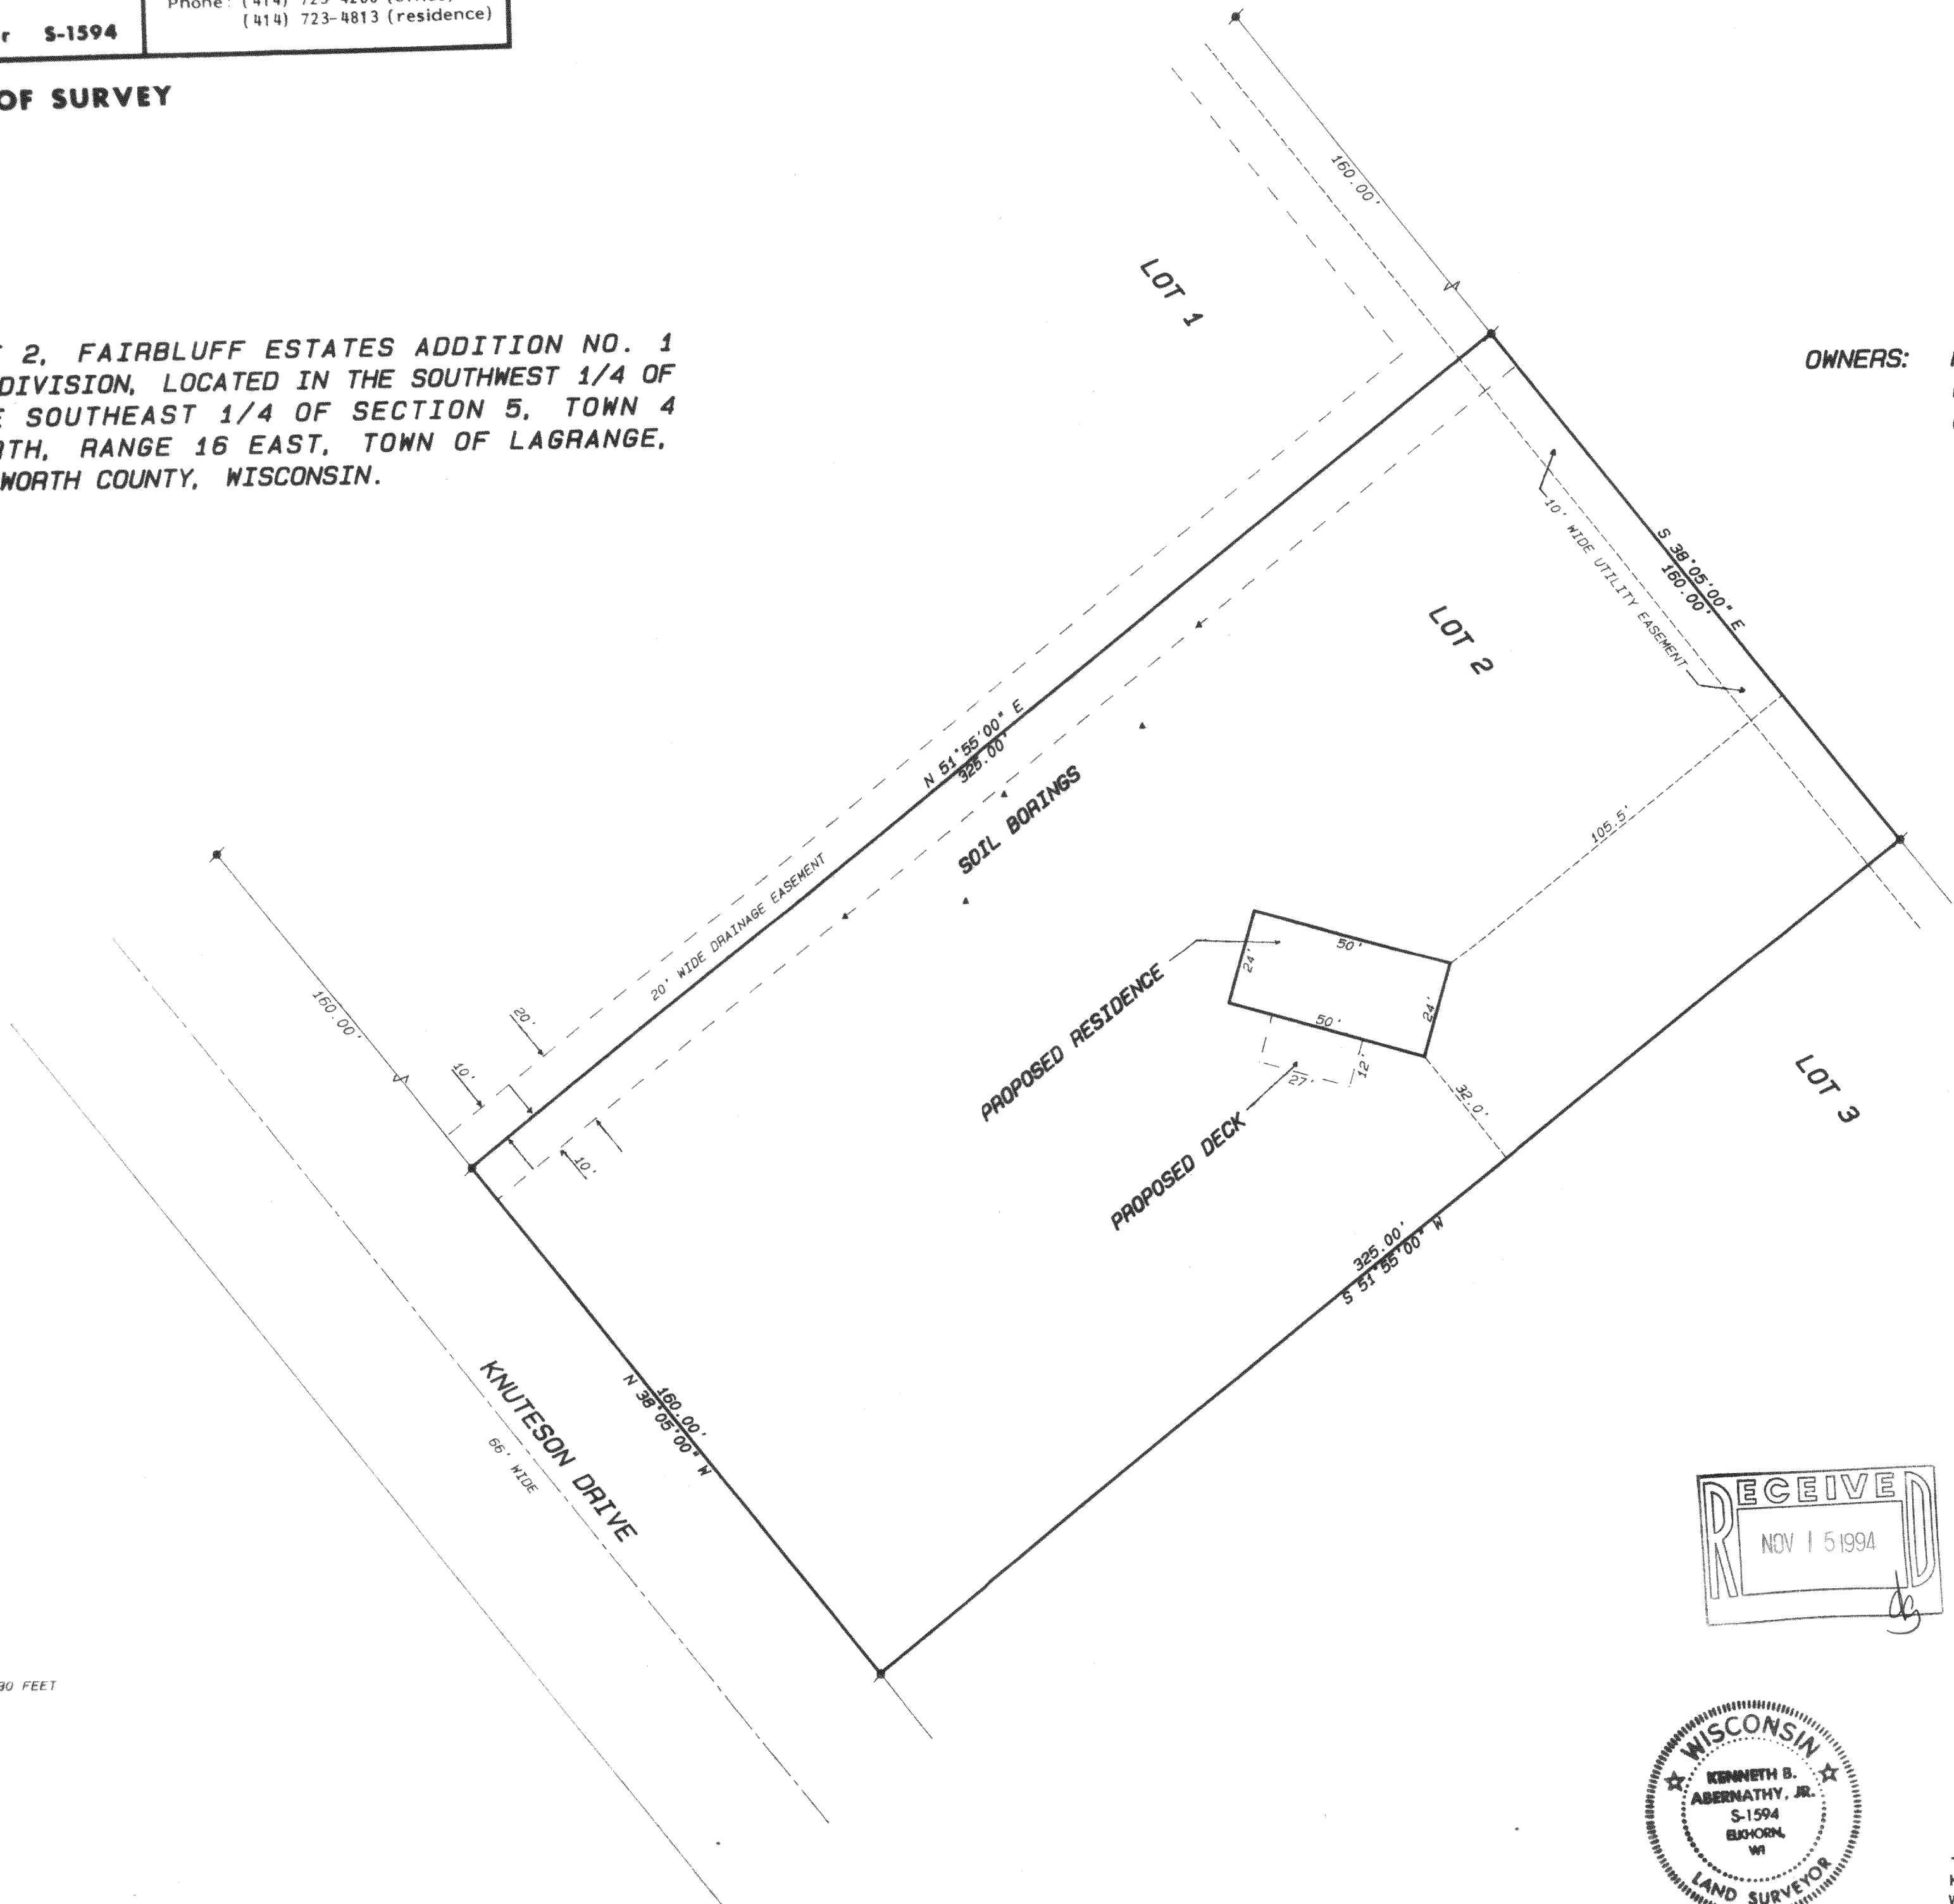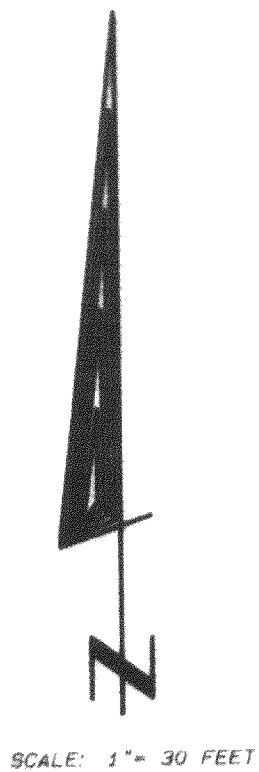


Legend

- FOUND IRON PIPE
- FOUND IRON ROD
- FOUND BRASS CAPPED MONUMENT
- FOUND CONCRETE MONUMENT
- CHISEL CUT IN CONCRETE
- SET IRON ROD, 24" LONG, WEIGHING 1.5 LBS./LINEAL FT., 3/4" DIA.
- SET IRON ROD, 30" LONG, WEIGHING 4.5 LBS./LINEAL FT., 1-11/16" DIA.
- (xx) RECORDED AS DIMENSION
- x-x- EXISTING FENCE

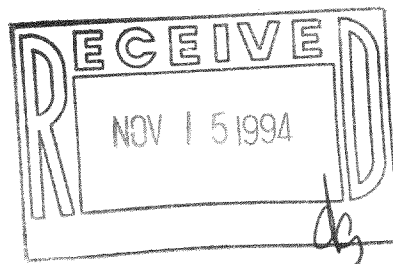

SCALE: 1" = 30 FEET

"I hereby certify that I have surveyed the above described property and that the above map is a true representation thereof and shows the size and location of the property, its exterior boundaries, the location of all visible structures and dimensions of all principal buildings thereon, boundary fences, apparent easements, roadways and visible encroachments, if any."  
"This survey is made for the use of the present owners of the property, and also those who purchase, mortgage, or guarantee the title thereto within one year from date hereof."

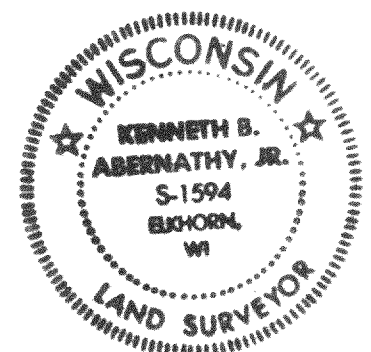

*Kenneth B. Abernathy, Jr.*  
KENNETH B. ABERNATHY, JR.  
WISCONSIN REGISTERED LAND SURVEYOR,  
S-1594  
Date: JULY 9, 1994 Job No. 94812