

AMERICAN SURVEYING COMPANY, INC.




LAND SURVEYORS

12207 C.T.H. "K"
FRANKSVILLE, WISCONSIN 53126
TEL. NO. (414) 835-4774

PLAT OF SURVEY

PREPARED FOR: NORM KEEKER

DESCRIPTION: LOT 2 OF CERTIFIED SURVEY MAP NO. 36, LOCATED IN THE SOUTHWEST 1/4 OF SECTION 35,
TOWN 4 NORTH, RANGE 16 EAST, TOWN OF LA GRANGE, COUNTY OF WALWORTH, STATE OF WISCONSIN.

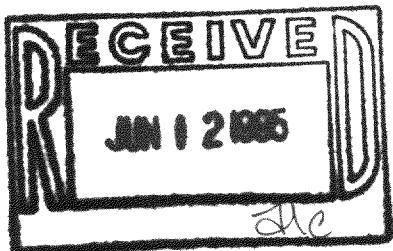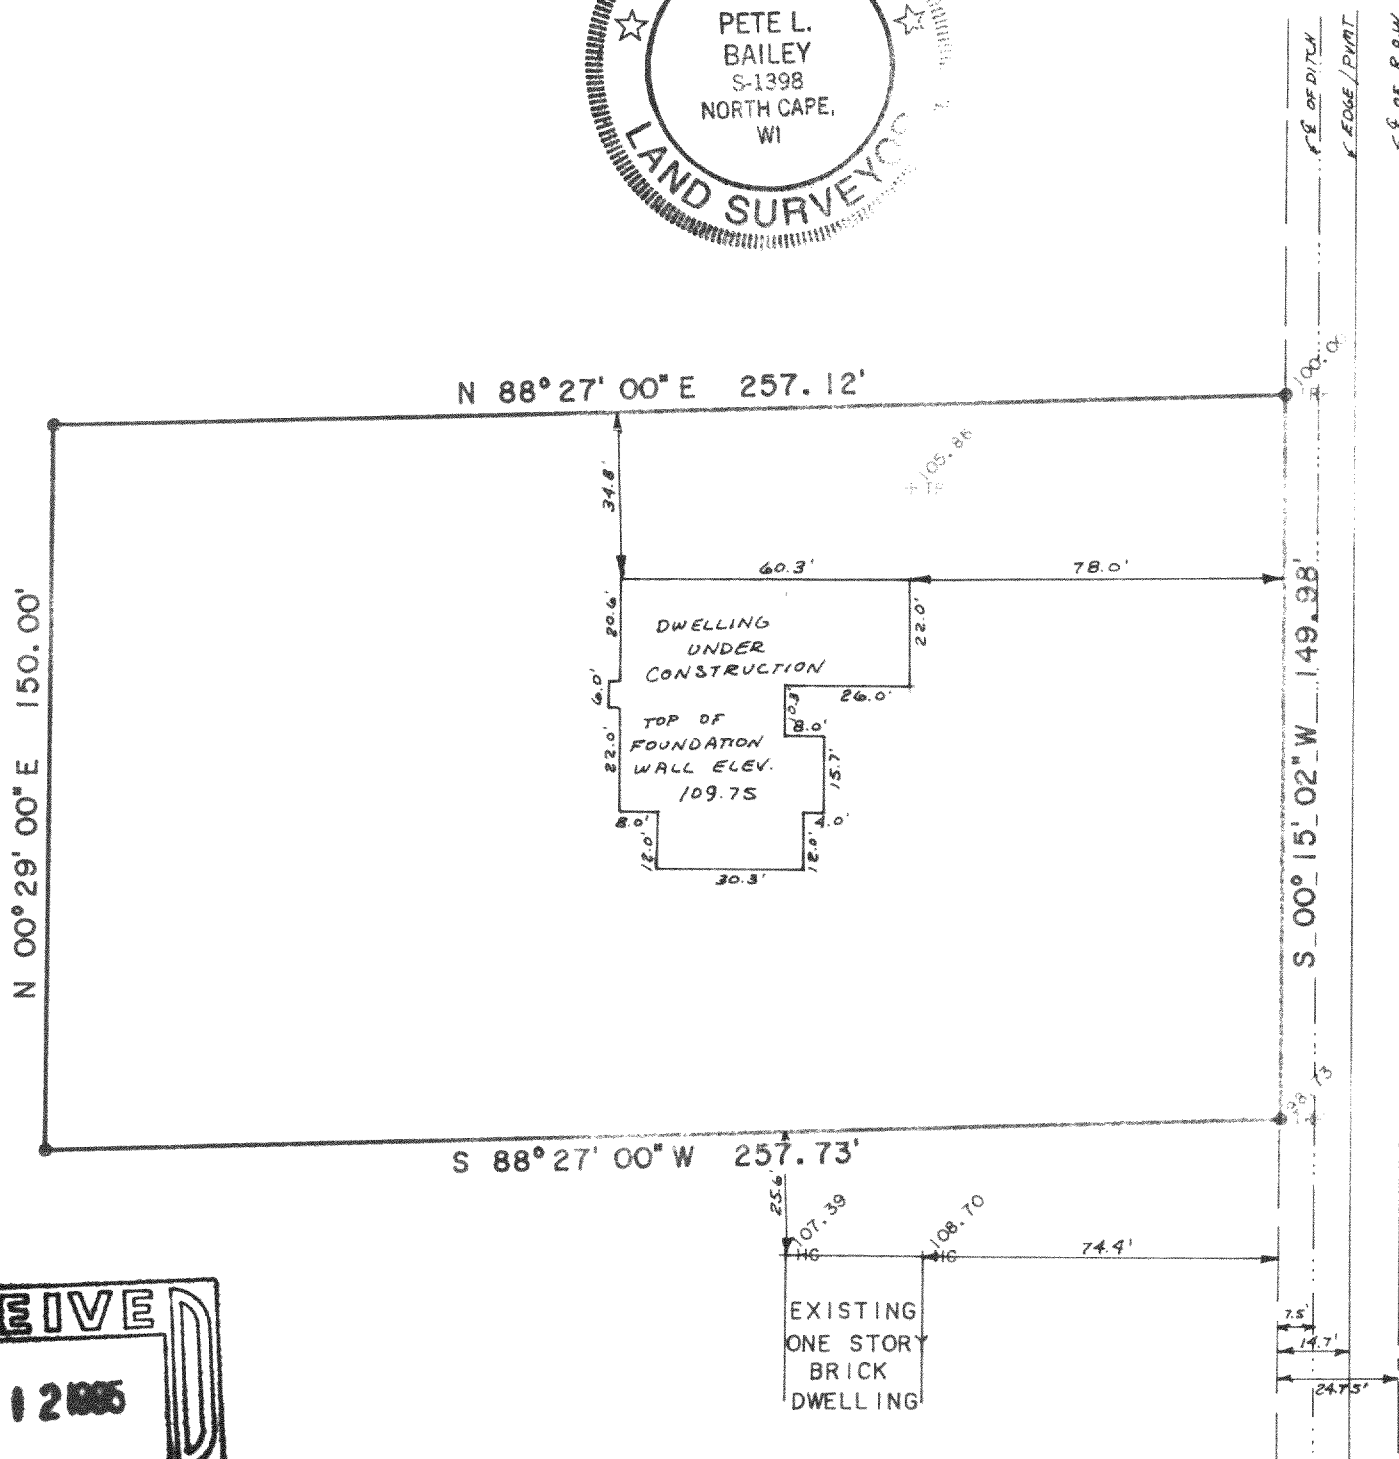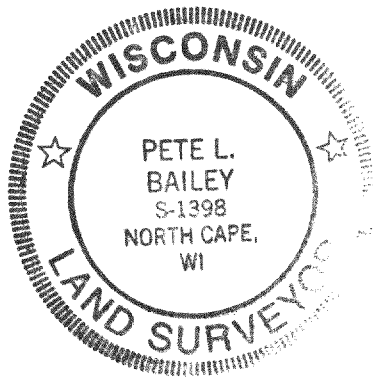

STATE OF WISCONSIN
COUNTY OF RACINE

The above described property has been surveyed under my direction and the above map is a correct representation thereof.

Dated at NORTH CAPE, this 7th day of OCTOBER, 19 94. Recertified FEBRUARY 2, 1995

Registered Land Surveyor

JOB NO. 94297

HA-36-2

416-1128