


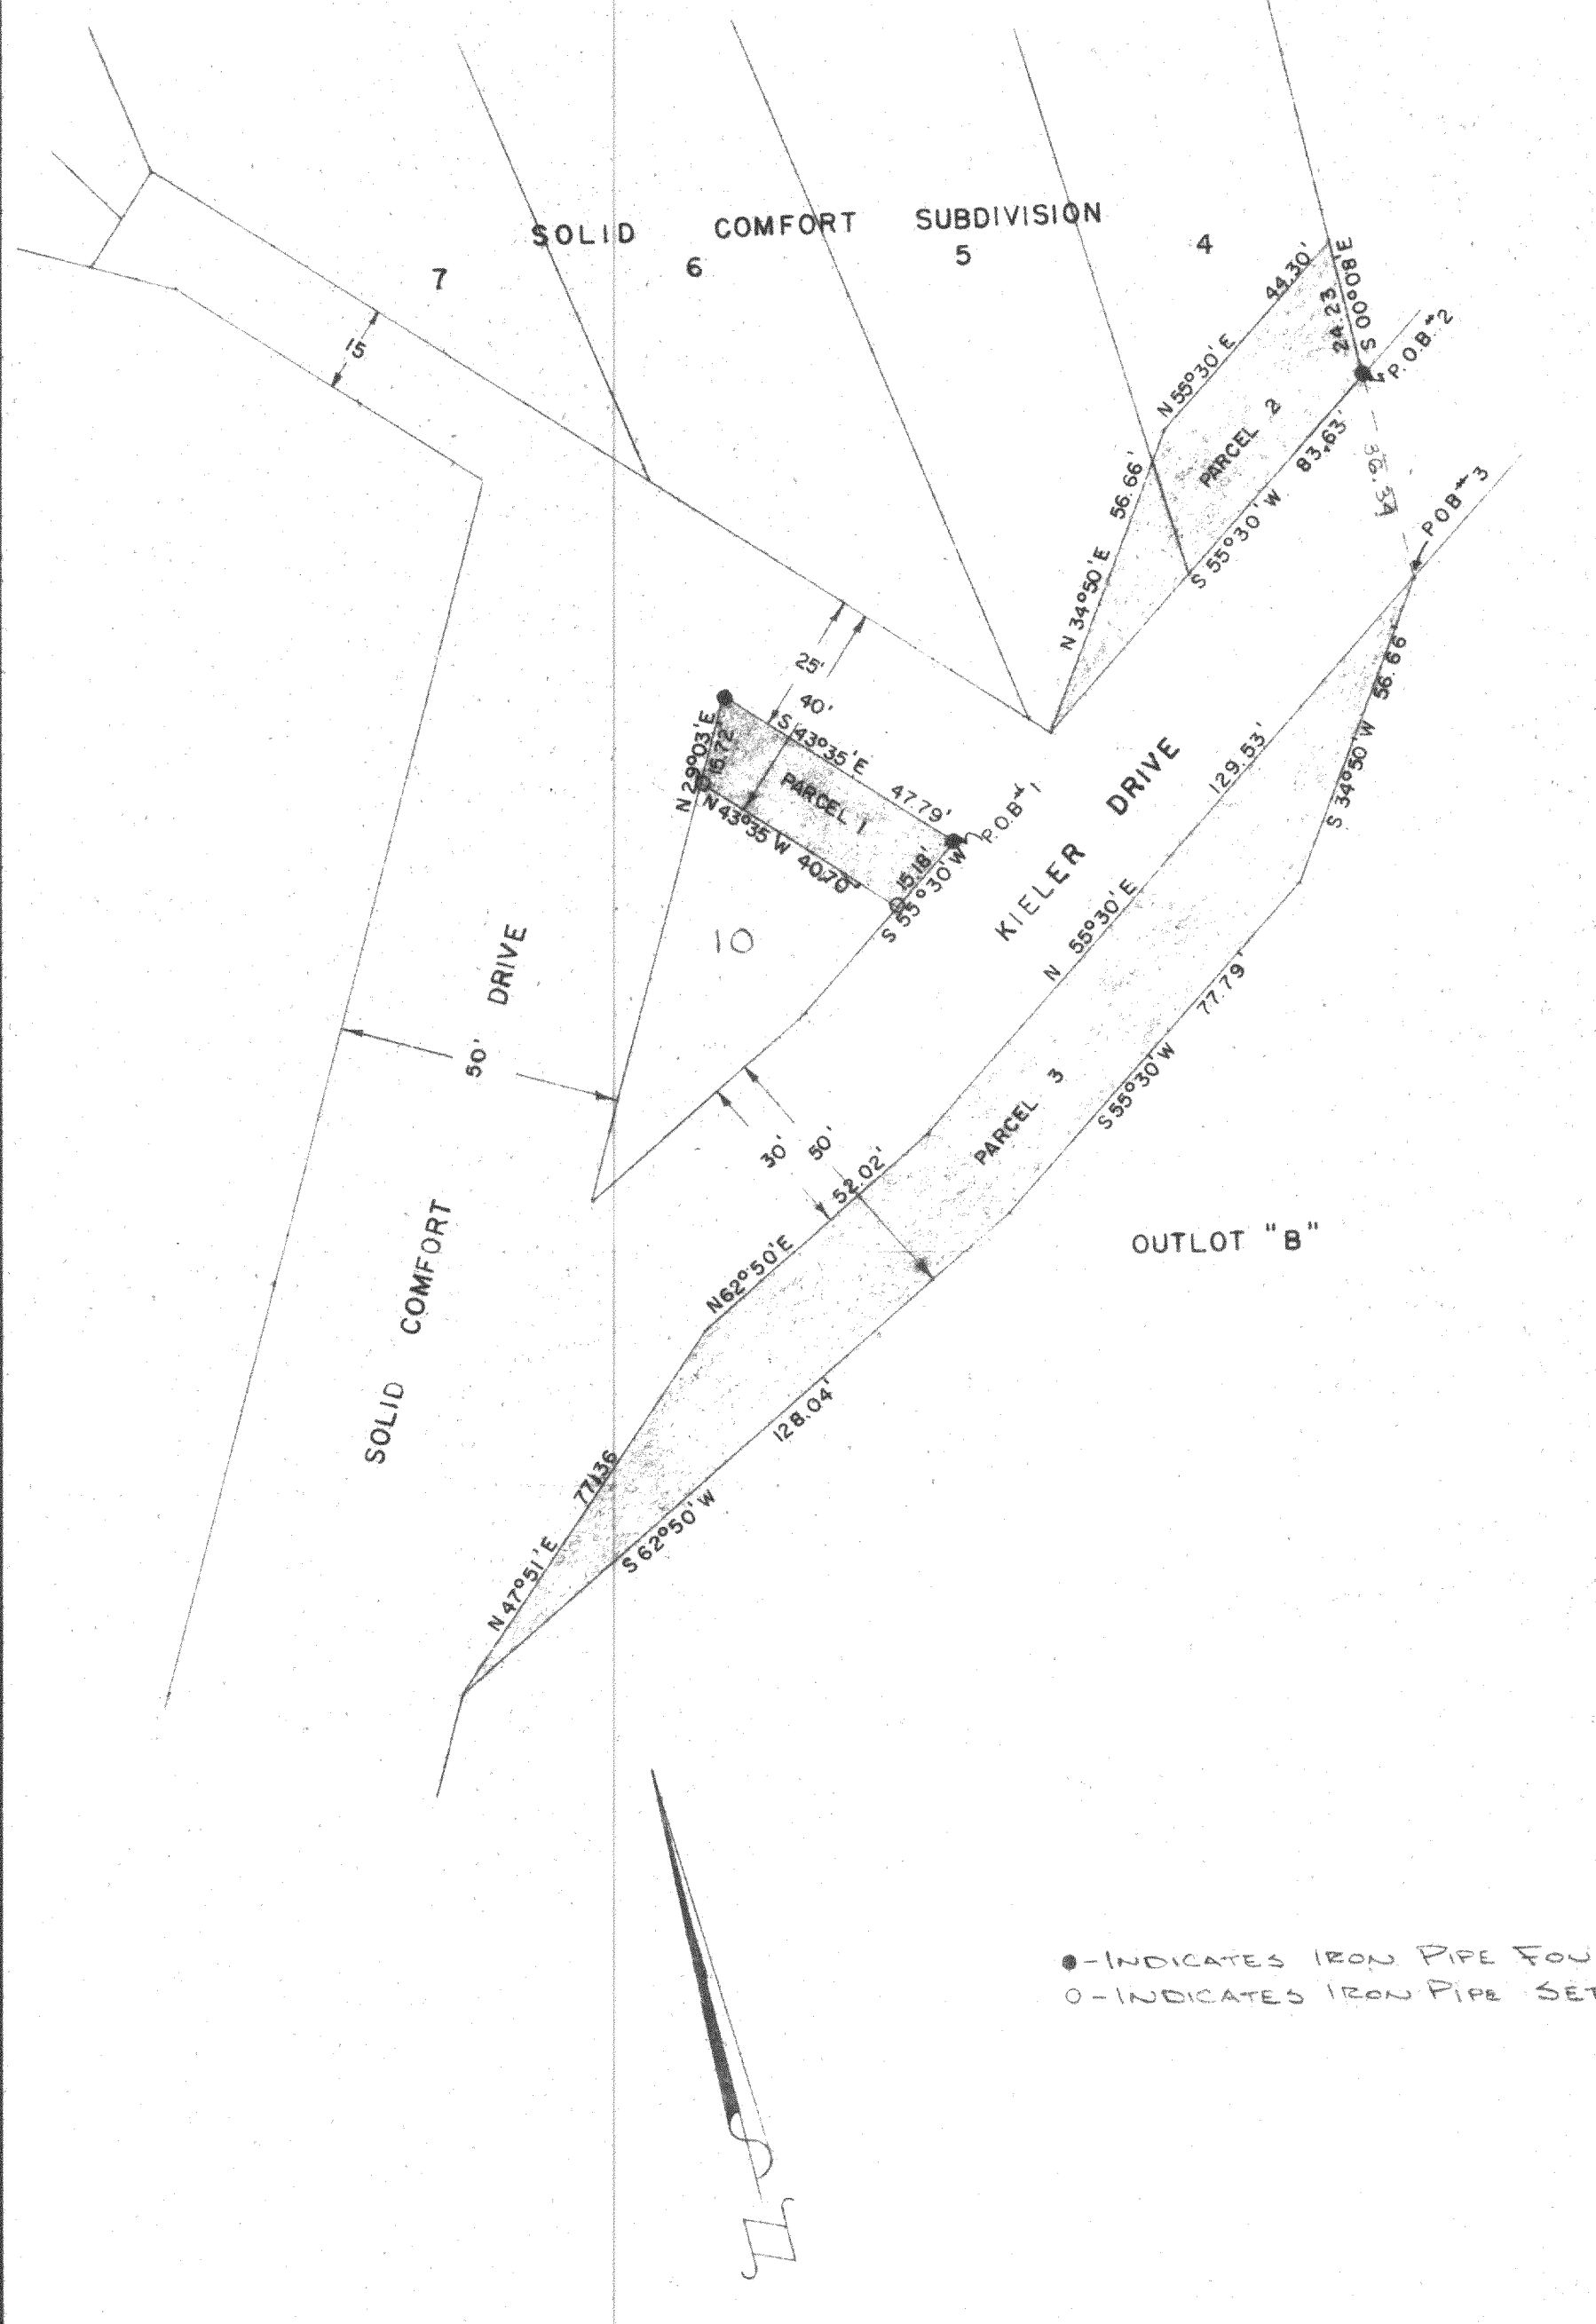

DESCRIPTION OF PARCEL NO. 1

Commencing at the SE corner of Lot 10 of Solid Comfort Subdivision, Section 26, T4N, R16E, Walworth County, Wisconsin, also the place of beginning of the lands hereinafter described; thence S 55°30' W along the north line of Kieler Drive, 15.18 feet; thence N 43°35' W parallel to the East line of said Lot 10, 40.70 feet to the South line of Solid Comfort Drive; thence N 29°03' E along said South line of said Solid Comfort Drive, 15.72 feet to the NE corner of said Lot 10; thence S 43°35' E along said East line of said Lot 10, 47.79 feet to the place of beginning, containing 0.015 acres of land more or less.

DESCRIPTION OF PARCEL NO. 2

Commencing at the SE corner of Lot 4 of Solid Comfort Subdivision, Section 26, T4N, R16E, Walworth County, Wisconsin, also the place of beginning of the lands hereinafter described; thence S 55°30' W along the North line of Kieler Drive, 83.63 feet to the SW corner of Lot 5 of Solid Comfort Subdivision; thence N 34°50' E, 56.66 feet; thence N 55°30' E parallel to said North line of said Kieler Drive, 44.30 feet to the East line of said Lot 4; thence S 00°08' E along said East line of said Lot 4, 24.23 feet to the place of beginning, containing 0.029 acres of land more or less.

DESCRIPTION OF PARCEL NO. 3


Commencing at the SE corner of Lot 4 of Solid Comfort Subdivision, Section 26, T4N, R16E, Walworth County, Wisconsin; thence S 00°08' E along a prolongation of the East line of said Lot 4, 36.34 feet to the South line of Kieler Drive and the place of beginning of the lands hereinafter described; thence S 34°50' W, 56.66 feet; thence S 55°30' W parallel to said South line of said Kieler Drive, 77.79 feet; thence S 62°50' W parallel to said South line of said Kieler Drive, 128.04 feet to the South line of Solid Comfort Drive; thence N 47°51' E along said South line of said Kieler Drive, 77.36 feet; thence N 62°50' E along said South line of said Kieler Drive, 52.02 feet; thence N 55°30' E along said South line of said Kieler Drive, 129.53 feet to the place of beginning, containing 0.089 acres of land more or less.

CERTIFICATE:

I, James F. Biagi, surveyor, do hereby certify that I have surveyed the lands hereon described.

July 5, 1971

James F. Biagi
James F. Biagi L.S. 272

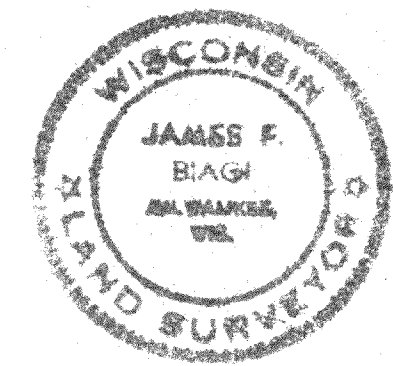

● - INDICATES IRON PIPE FOUND
○ - INDICATES IRON PIPE SET

REVISIONS			KIELER ROAD		
NO.	DATE	BY	SOLID COMFORT SUBD.		
1					
2					
3			DRAWN BY	SCALE	MATERIAL
4			CHK'D	DATE	DRAWING NO.
5			TRACED	APP'D	

416-115