
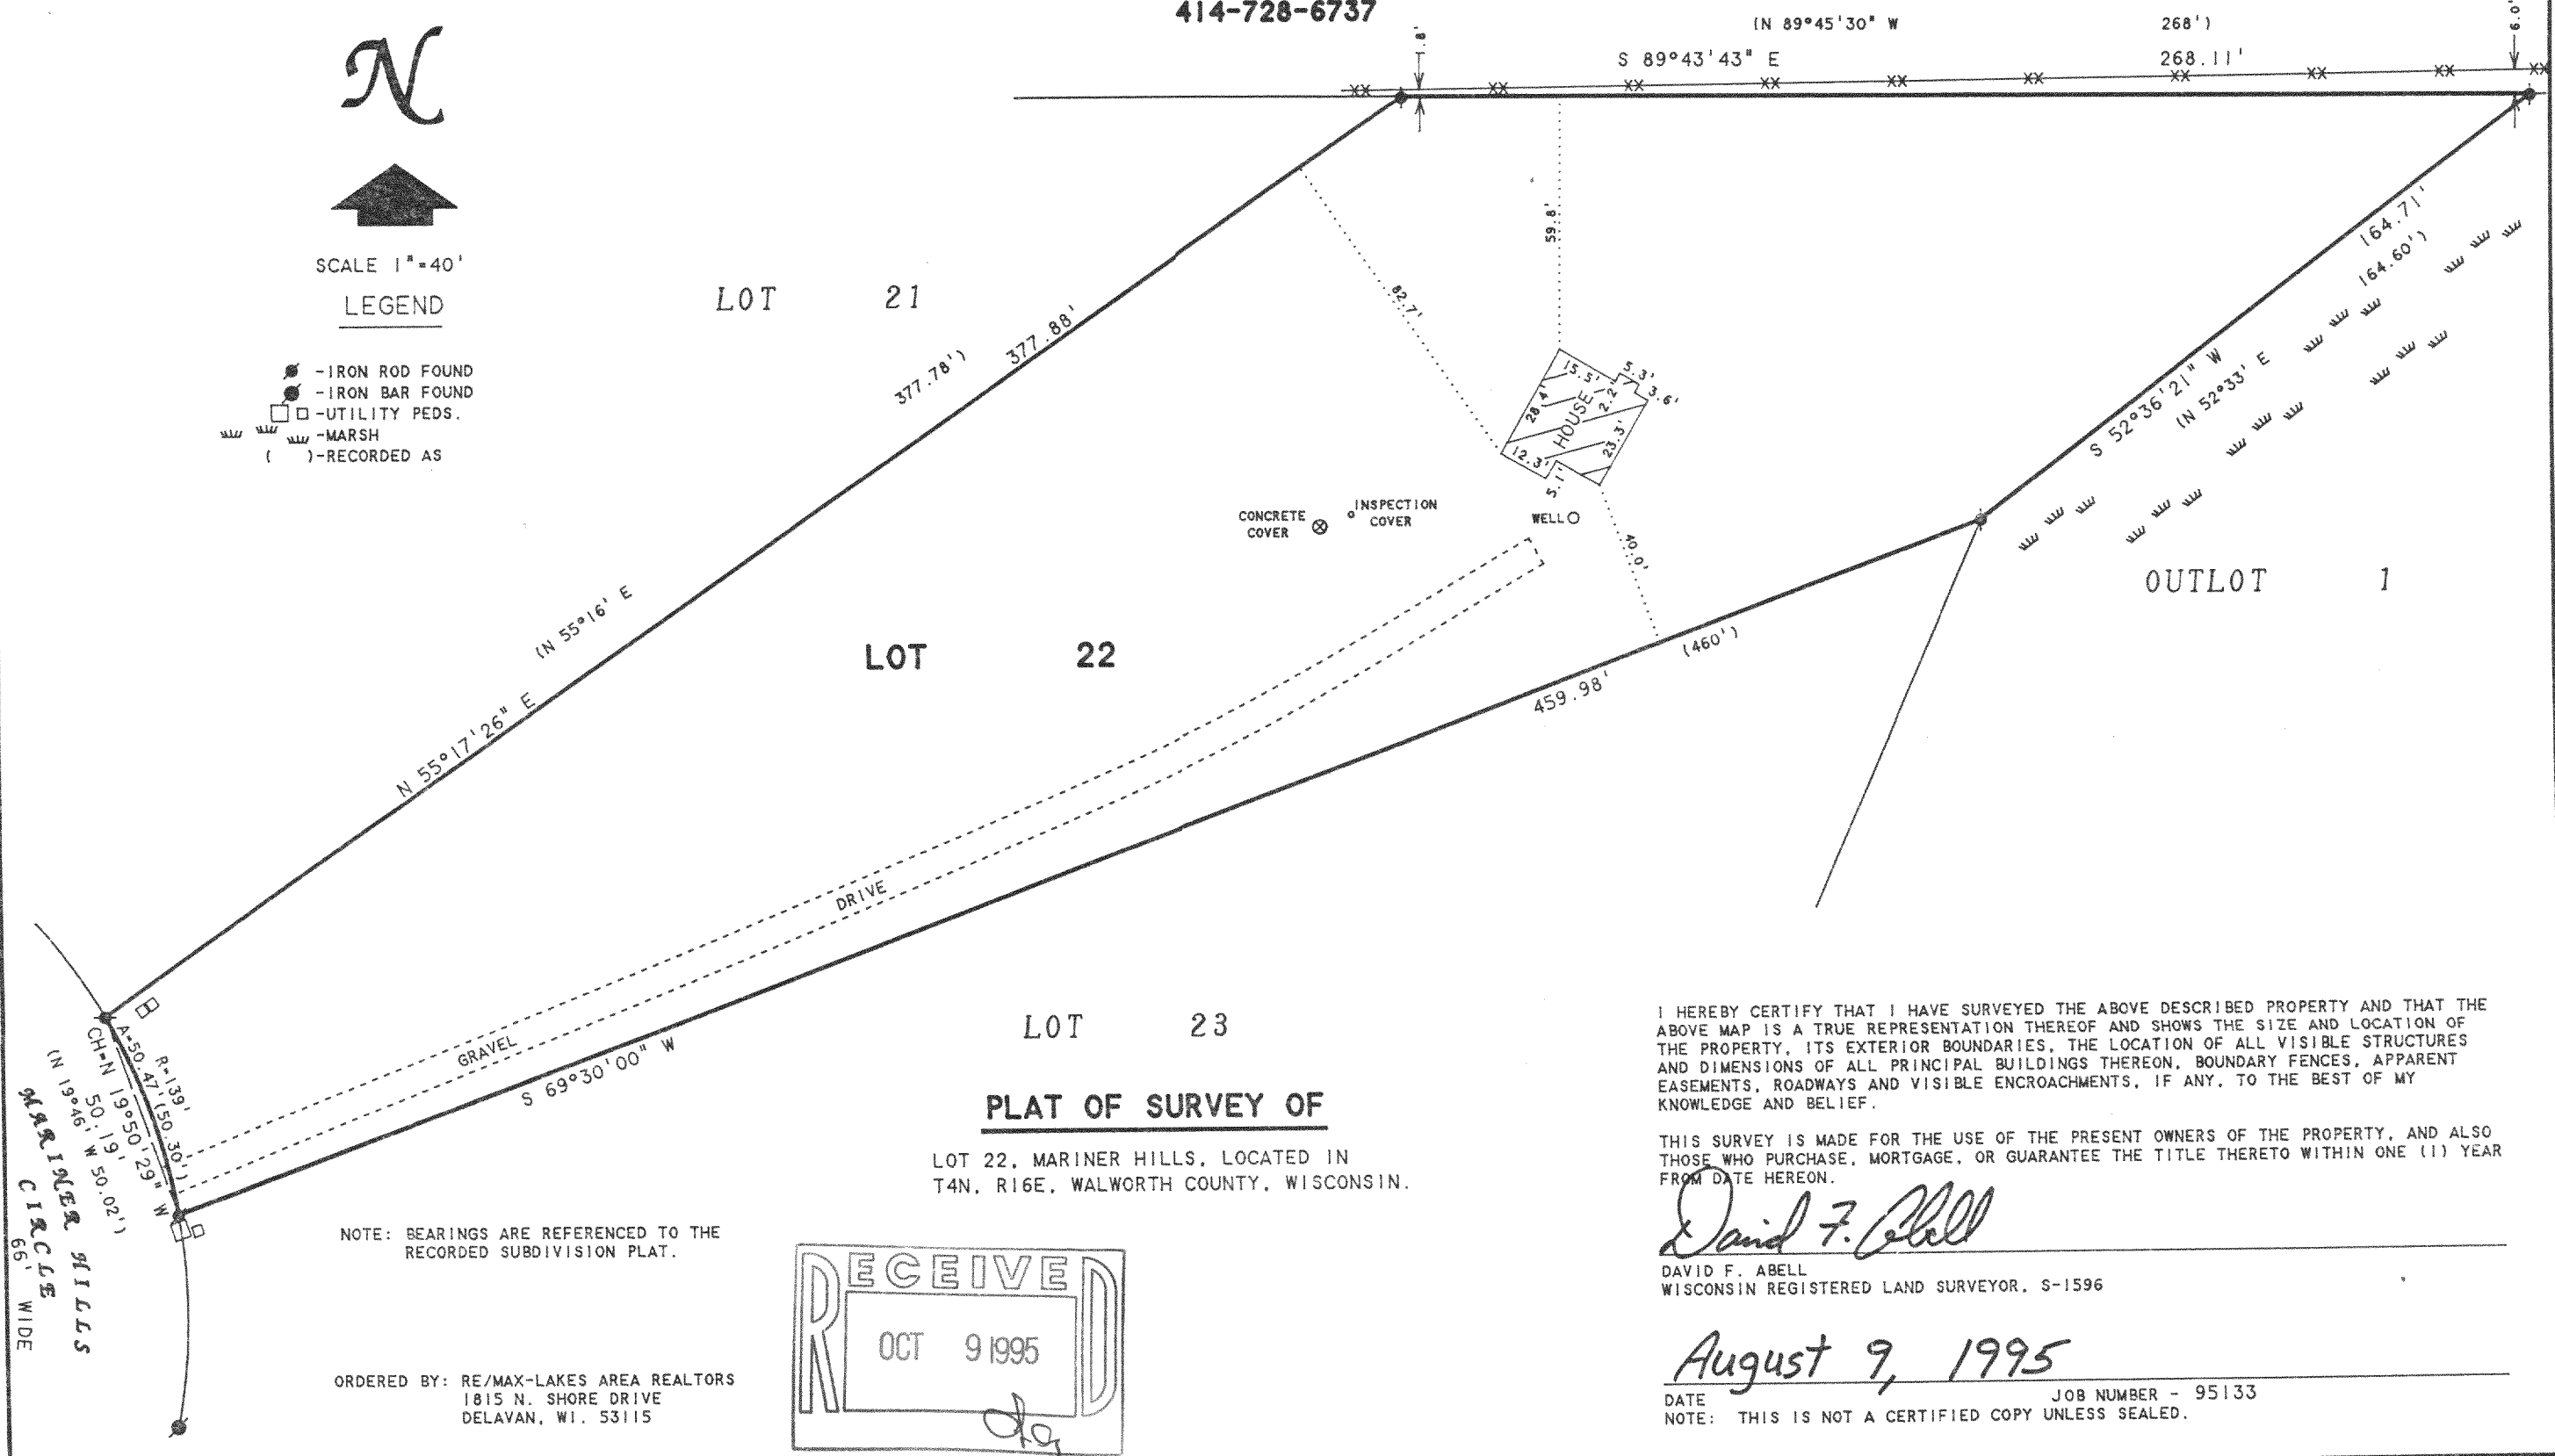


ABELL
SURVEYING & MAPPING
DELAVAN, WISCONSIN 53115
414-728-6737

2ND ADDITION TO BUBBLING SPRINGS SUBDIVISION


SCALE 1"=40'
LEGEND
● - IRON ROD FOUND
● - IRON BAR FOUND
□ - UTILITY PEDS.
--- - MARSH
() - RECORDED AS



HMH-22

416-1165