
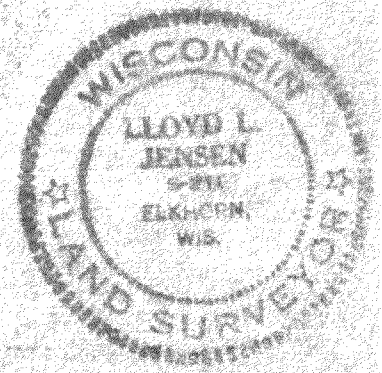


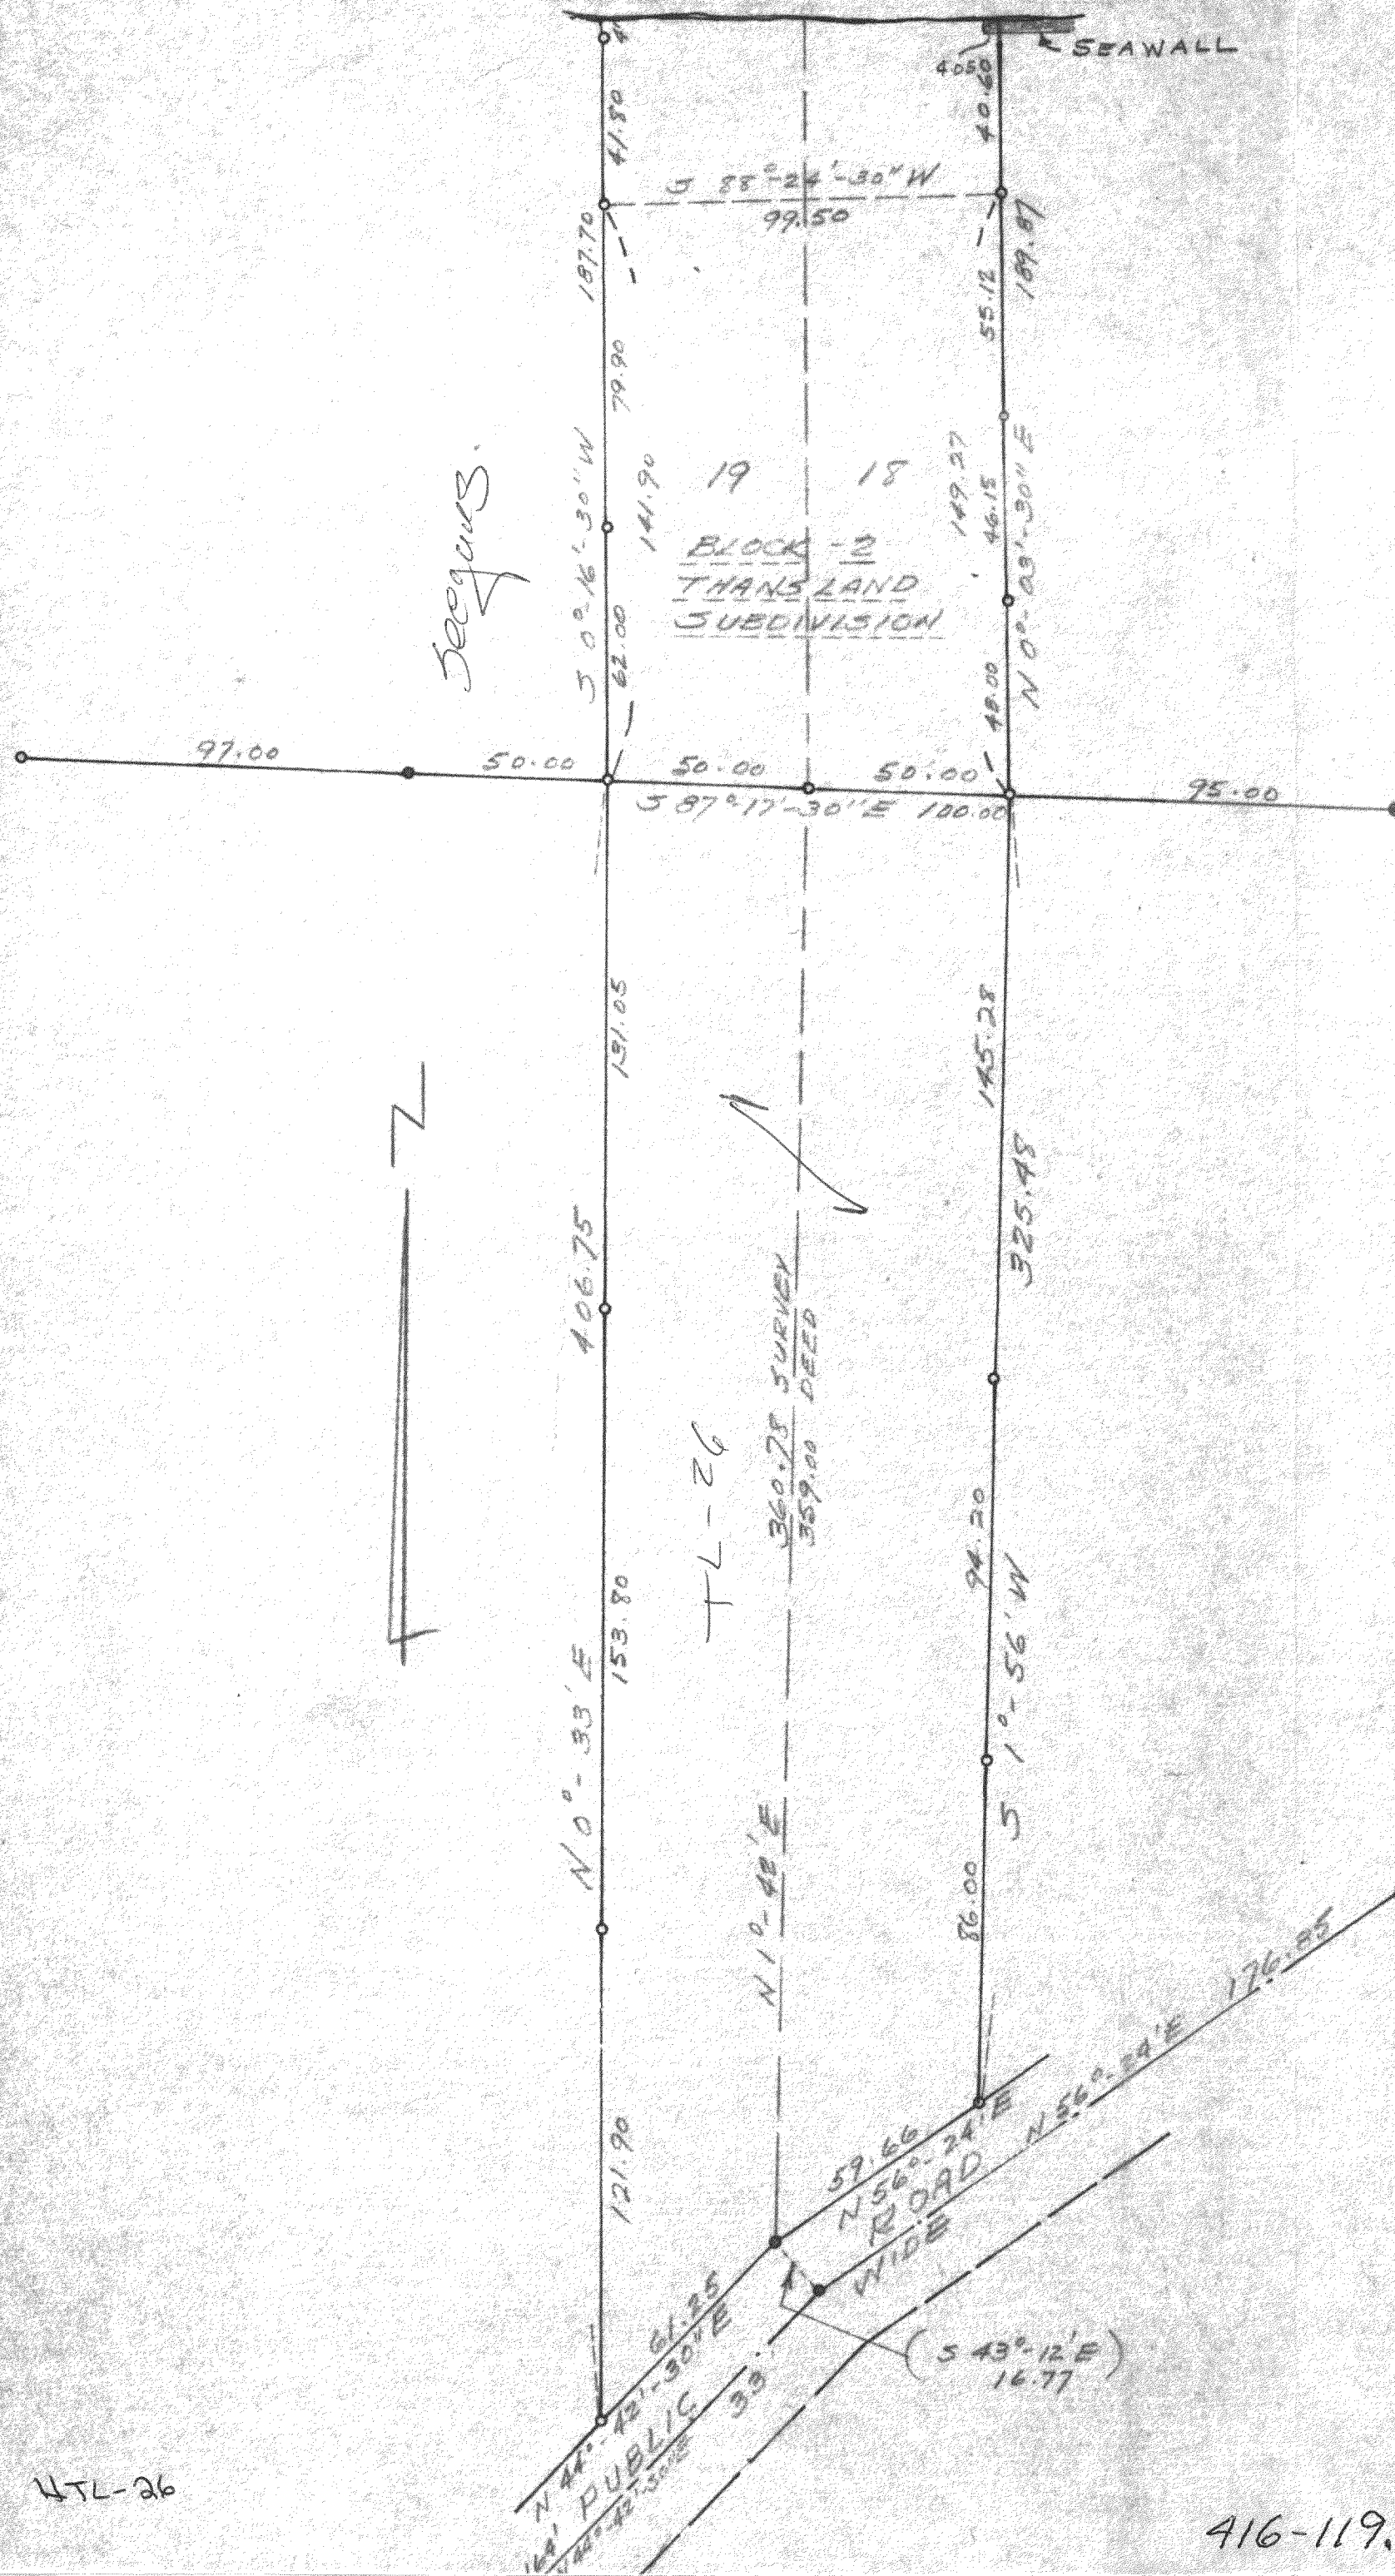

PLAT OF SURVEY OF

LOTS 18-19, BLOCK 2 - THANSLAND
SUBDIVISION, AND LAND TO THE SOUTH,
SECTION 35, T4N-R16E
WALWORTH COUNTY
WISCONSIN

Lloyd L. Jensen
SURVEYOR

SCALE 1" = 40'

DATE JUNE 14, 1966