

ABELL
SURVEYING & MAPPING
DELAVER, WISCONSIN 53115
414-728-6737

PLAT OF SURVEY OF

A PARCEL OF LAND LOCATED IN BLOCK 4 OF GREEN LAKE PARK SUBDIVISION WHICH IS LOCATED IN THE SOUTHWEST 1/4 OF SECTION 26, T4N, R16E, WALWORTH COUNTY, WISCONSIN, AS DESCRIBED IN VOL. 460 PAGE 546 AS DOCUMENT NO. 179731, TAX PARCEL NO. HGP-38.

TAX PARCEL
HGP-41

TAX PARCEL
HGP-37

TAX PARCEL
HGP-38

BLOCK

PUBLIC

ROAD


N



SCALE 1"=10'

LEGEND

- - IRON PIPE FOUND
- - IRON ROD FOUND
- - IRON PIPE SET found 3/20/96
- OVERHEAD UTILITY LINES
- - UTILITY PED.
- () - RECORDED AS

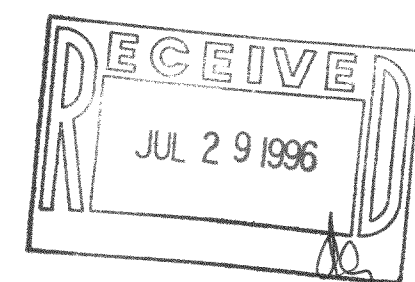

ORDERED BY: DON HANSEN
320 MARGATE TERRACE
DEERFIELD, IL. 60015

HEREBY CERTIFY THAT I HAVE SURVEYED THE ABOVE DESCRIBED PROPERTY AND THAT THE ABOVE MAP IS A TRUE REPRESENTATION THEREOF AND SHOWS THE SIZE AND LOCATION OF THE PROPERTY, ITS EXTERIOR BOUNDARIES, THE LOCATION OF ALL VISIBLE STRUCTURES AND DIMENSIONS OF ALL PRINCIPAL BUILDINGS THEREON, BOUNDARY FENCES, APPARENT EASEMENTS, ROADWAYS AND VISIBLE ENCROACHMENTS, IF ANY, TO THE BEST OF MY KNOWLEDGE AND BELIEF.

THIS SURVEY IS MADE FOR THE USE OF THE PRESENT OWNERS OF THE PROPERTY, AND ALSO THOSE WHO PURCHASE, MORTGAGE, OR GUARANTEE THE TITLE THERETO WITHIN ONE (1) YEAR FROM DATE HEREON.

David F. Abell

DAVID F. ABELL
WISCONSIN REGISTERED LAND SURVEYOR, S-1596

March 25, 1991

REVISED DATE: MARCH 22, 1996

DATE: JOB NUMBER - 91039
NOTE: THIS IS NOT A CERTIFIED COPY UNLESS SEALED.

HGP-38

46-1241