




WALWORTH COUNTY SURVEYING & MAPPING

P. O. BOX 1115
LAKE GENEVA, WISCONSIN
414-248-0505


PLAT OF SURVEY OF

LOTS 8 AND 9 IN WHAT IS KNOWN AS LONG POINT
SITUATED ON LOT 7 OR THE EAST 1/2 OF THE SOUTHEAST
FRACTIONAL 1/4 OF SECTION 26, T 4 N, R 16 E, ACCORDING
TO A PLAT OF SAID LONG POINT ON RECORD IN THE OFFICE
OF THE REGISTER OF DEEDS IN AND FOR WALWORTH COUNTY,
WISCONSIN IN VOLUME 5 OF PLATS ON PAGE 66.

ORDERED BY: RE/MAX GENEVA REALTY, LTD.
101 BROAD STREET
LAKE GENEVA, WISCONSIN
53147

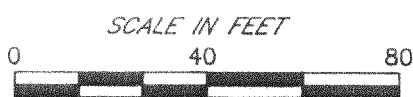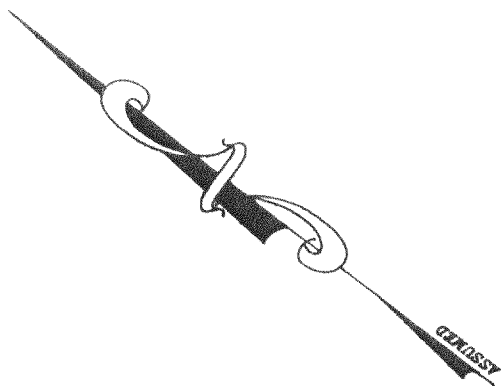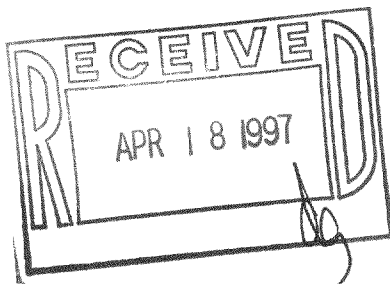

- LEGEND**
- IRON PIPE FOUND
 - ⊗-IRON ROD FOUND
 - CONCRETE MONUMENT FOUND
 - IRON PIPE PLACED
 - ()-RECORDED AS
 - ⊕-UTILITY POLE

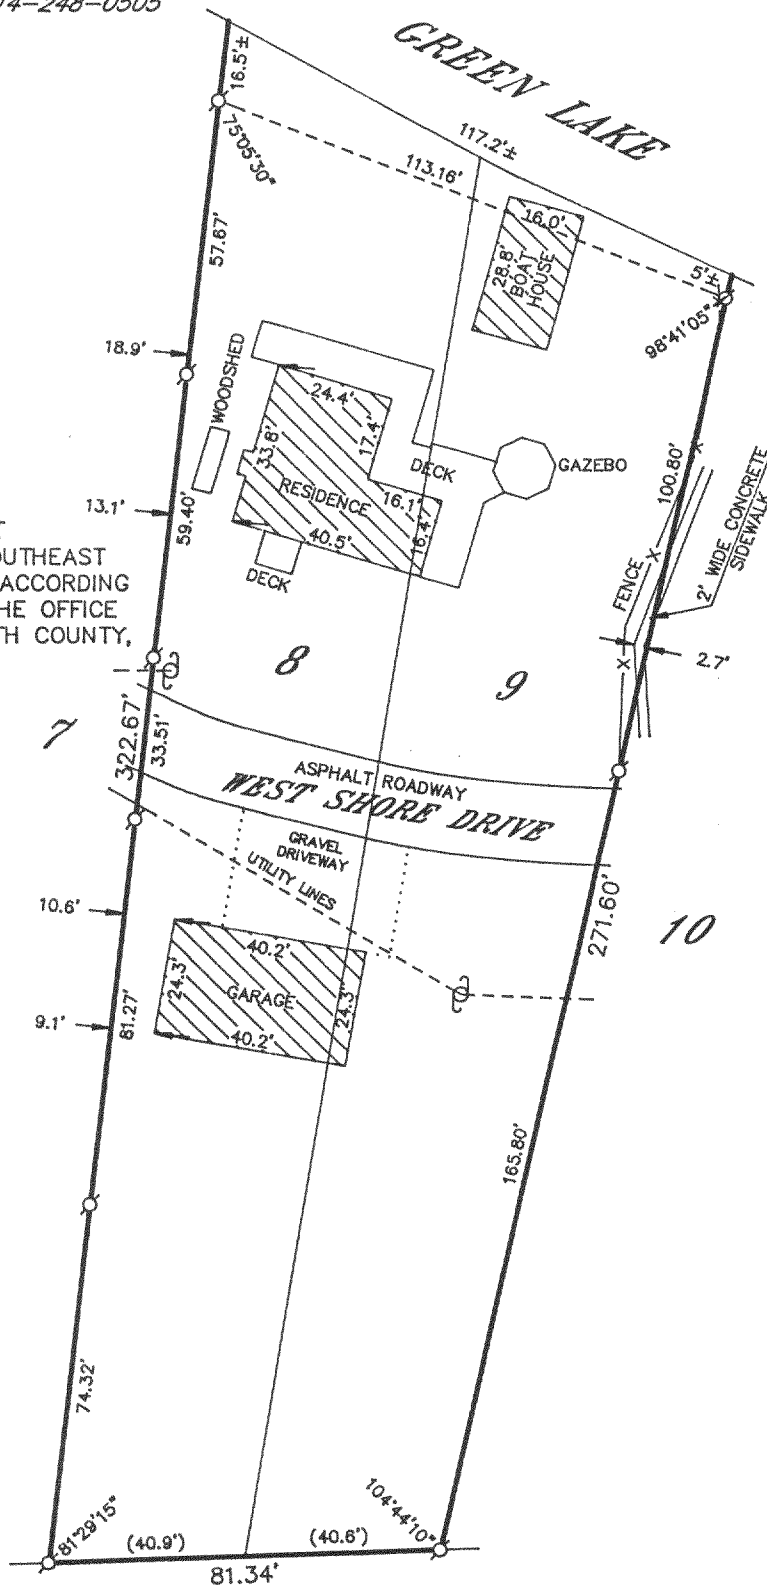

I HEREBY CERTIFY THAT I HAVE SURVEYED THE ABOVE DESCRIBED
PROPERTY AND THAT THE ABOVE MAP IS A TRUE REPRESENTATION
THEREOF AND SHOWS THE SIZE AND LOCATION OF THE PROPERTY,
ITS EXTERIOR BOUNDARIES, THE LOCATION OF ALL VISIBLE STRUCTURES
AND DIMENSIONS OF ALL PRINCIPAL BUILDINGS THEREON, BOUNDARY
FENCES, APPARENT EASEMENTS, ROADWAYS AND VISIBLE ENCROACH-
MENTS, IF ANY, TO THE BEST OF MY KNOWLEDGE AND BELIEF.

THIS SURVEY IS MADE FOR THE USE OF THE PRESENT OWNERS OF
THE PROPERTY AND ALSO THOSE WHO PURCHASE, MORTGAGE OR
GUARANTEE THE TITLE THERETO WITHIN ONE (1) YEAR FROM DATE
HEREOF.

Robert M. Baerenwald
ROBERT M. BAERENWALD
WISCONSIN REGISTERED LAND SURVEYOR, S-1508

DEC. 15, 1996
DATE JOB NO. 5300

NOTE: THIS IS NOT A CERTIFIED COPY UNLESS SEALED.

HLPN-4
416-1287