


PLAT OF SURVEY

LOT 6 OF OAK PARK SUBDIVISION, LOCATED IN SECTION 26, TOWN 4 NORTH, RANGE 16 EAST, TOWN OF LaGRANGE, WALWORTH COUNTY, WISCONSIN.

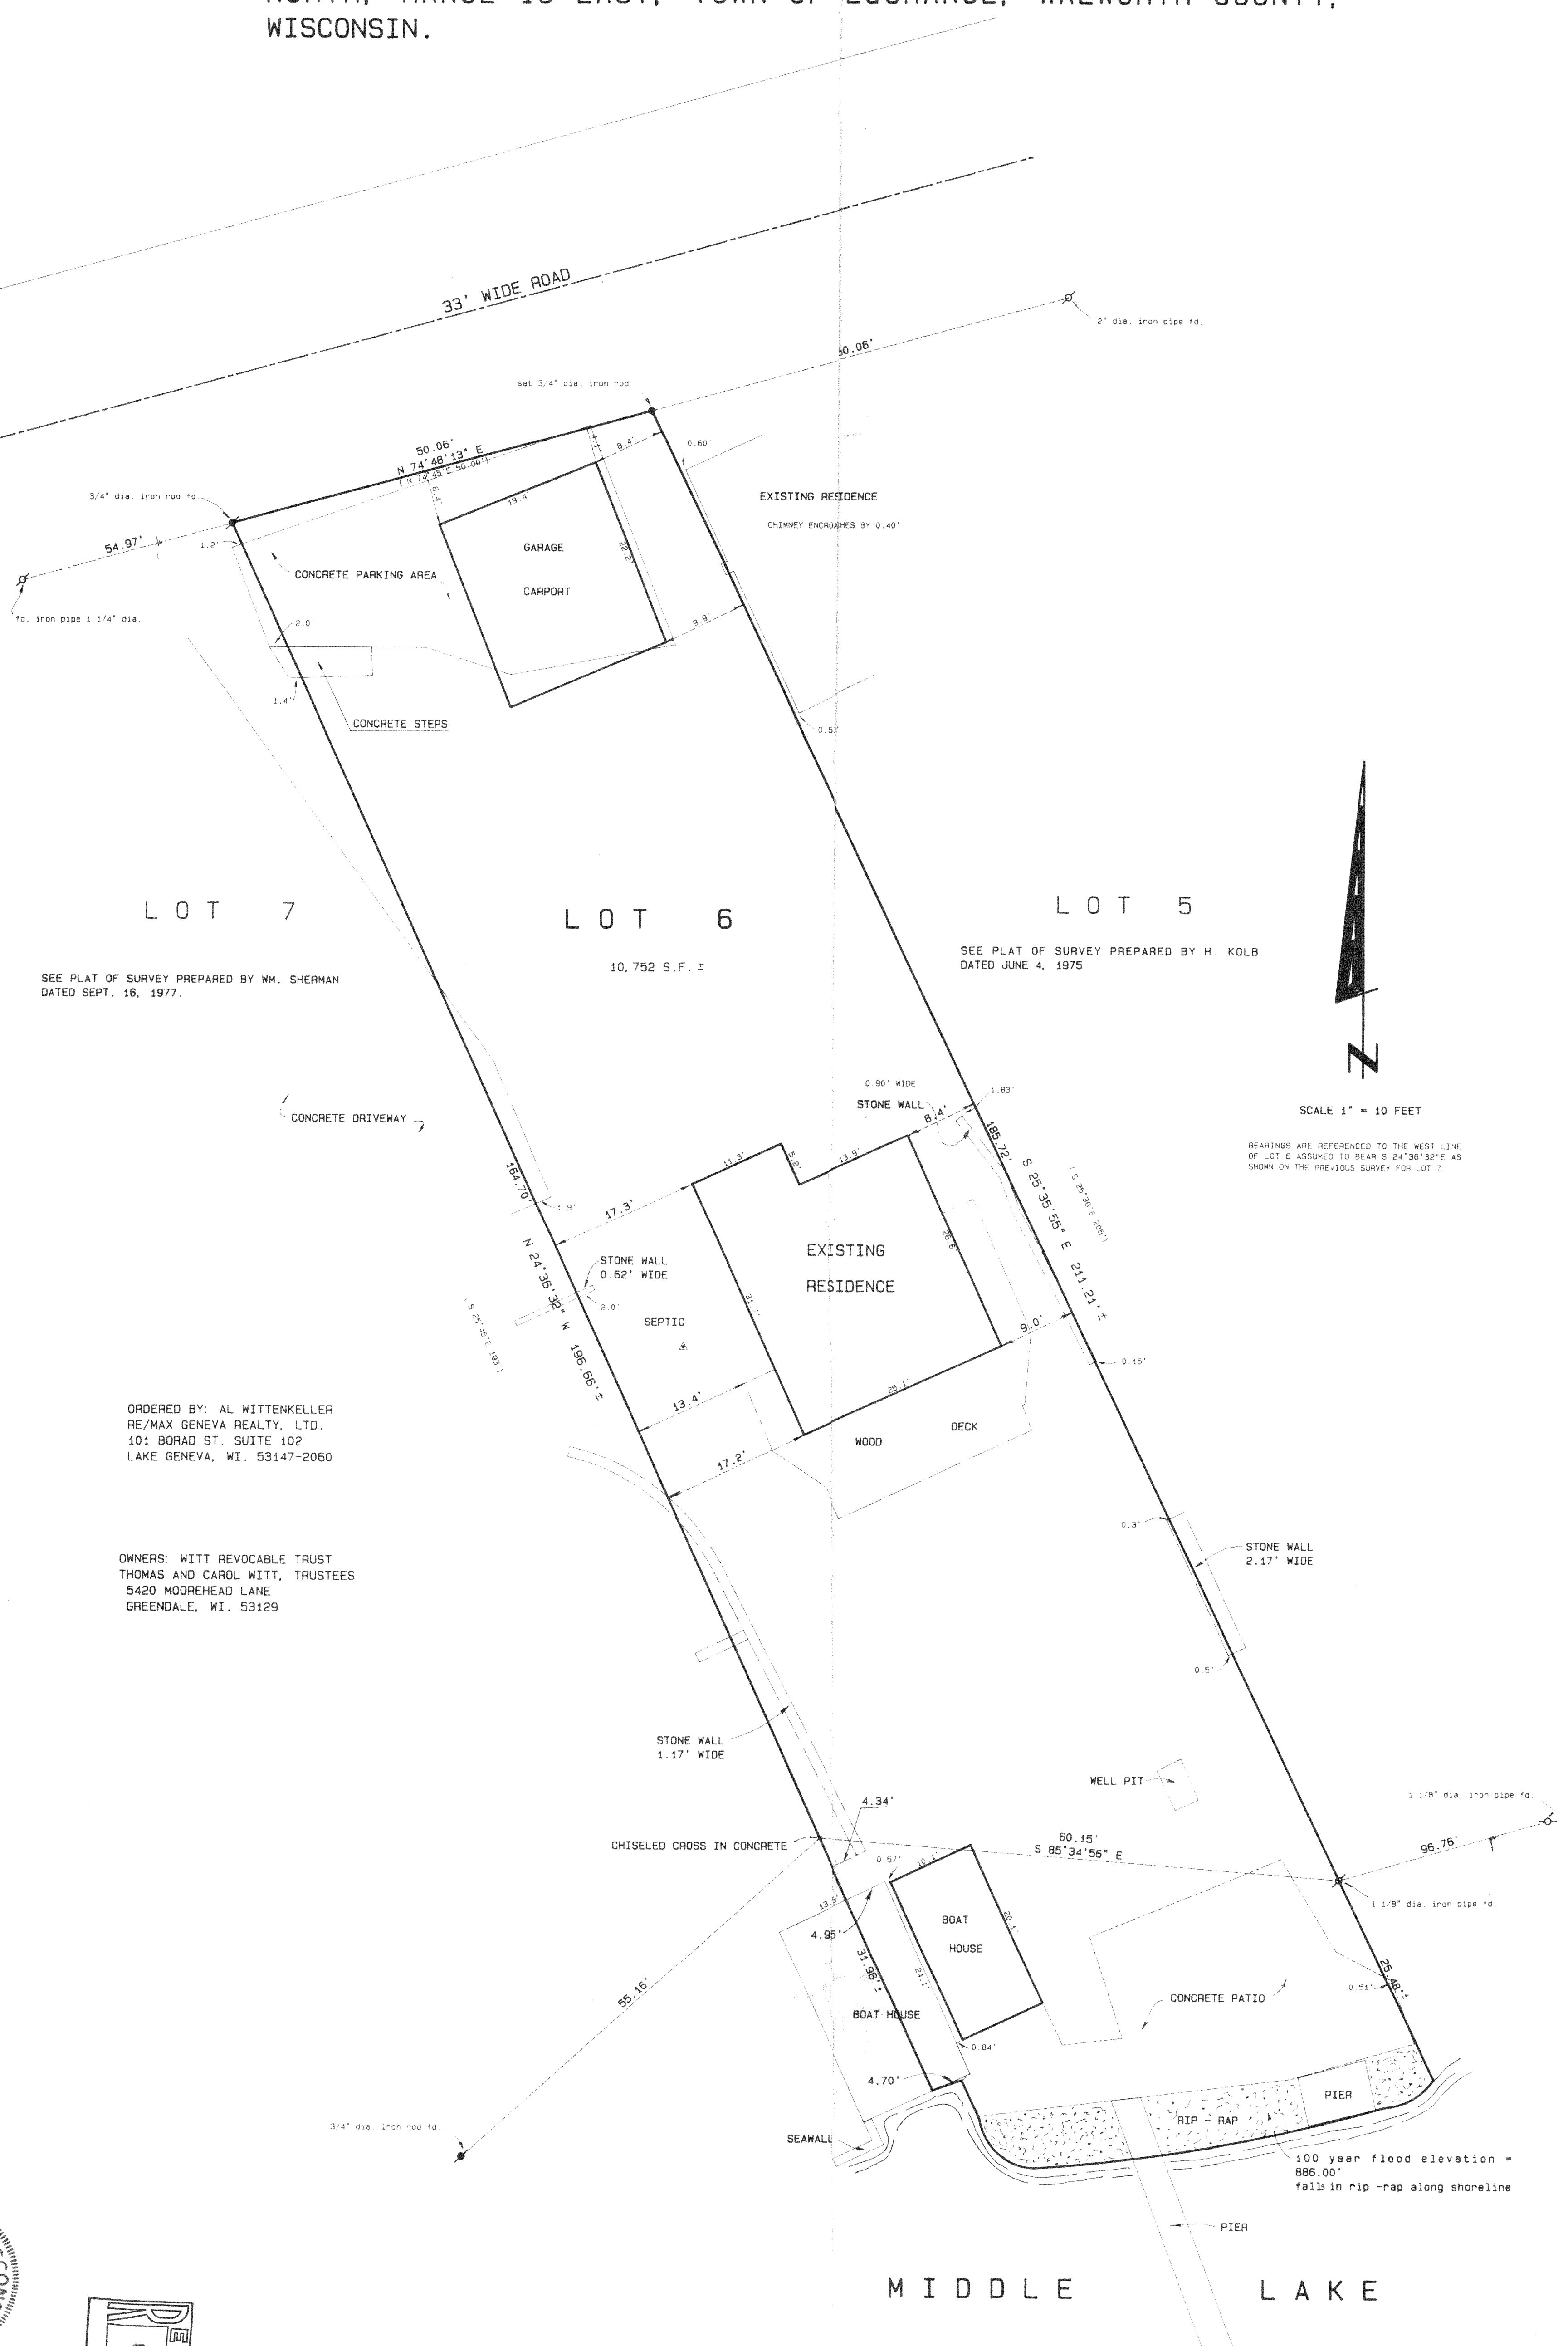


SEE PLAT OF SURVEY PREPARED BY WM. SHERMAN
DATED SEPT. 16, 1977.

SEE PLAT OF SURVEY PREPARED BY H. KOLB
DATED JUNE 4, 1975

ORDERED BY: AL WITTENKELLER
RE/MAX GENEVA REALTY, LTD.
101 BORAD ST, SUITE 102
LAKE GENEVA, WI. 53147-2060

OWNERS: WITT REVOCABLE TRUST
THOMAS AND CAROL WITT, TRUSTEES
5420 MOOREHEAD LANE
GREENDALE, WI. 53129

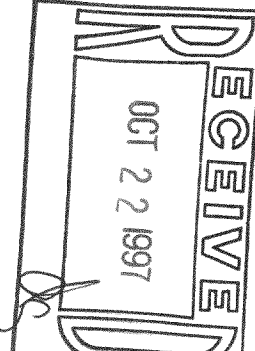

SCALE: 1" = 10 FEET

- Legend
- FOUND IRON PIPE
 - FOUND IRON ROD
 - FOUND BRASS CAPPING MONUMENT
 - FOUND CONCRETE MONUMENT
 - CHISEL CUT IN CONCRETE
 - SET IRON ROD 1/2" LONG, MEASURING
 - SET IRON ROD 36" LONG, MEASURING
 - 4.5 LBS. LINEAL FT. 1 1/8" DIA.
 - RECORDED AS DIMENSION
 - EXISTING FENCE

Kenneth B. Abernathy, Jr.
WISCONSIN REGISTERED LAND SURVEYOR, S-1594
Date: 8-25-97 Job No. 97.814