


56-54

PLAT OF SURVEY

1156

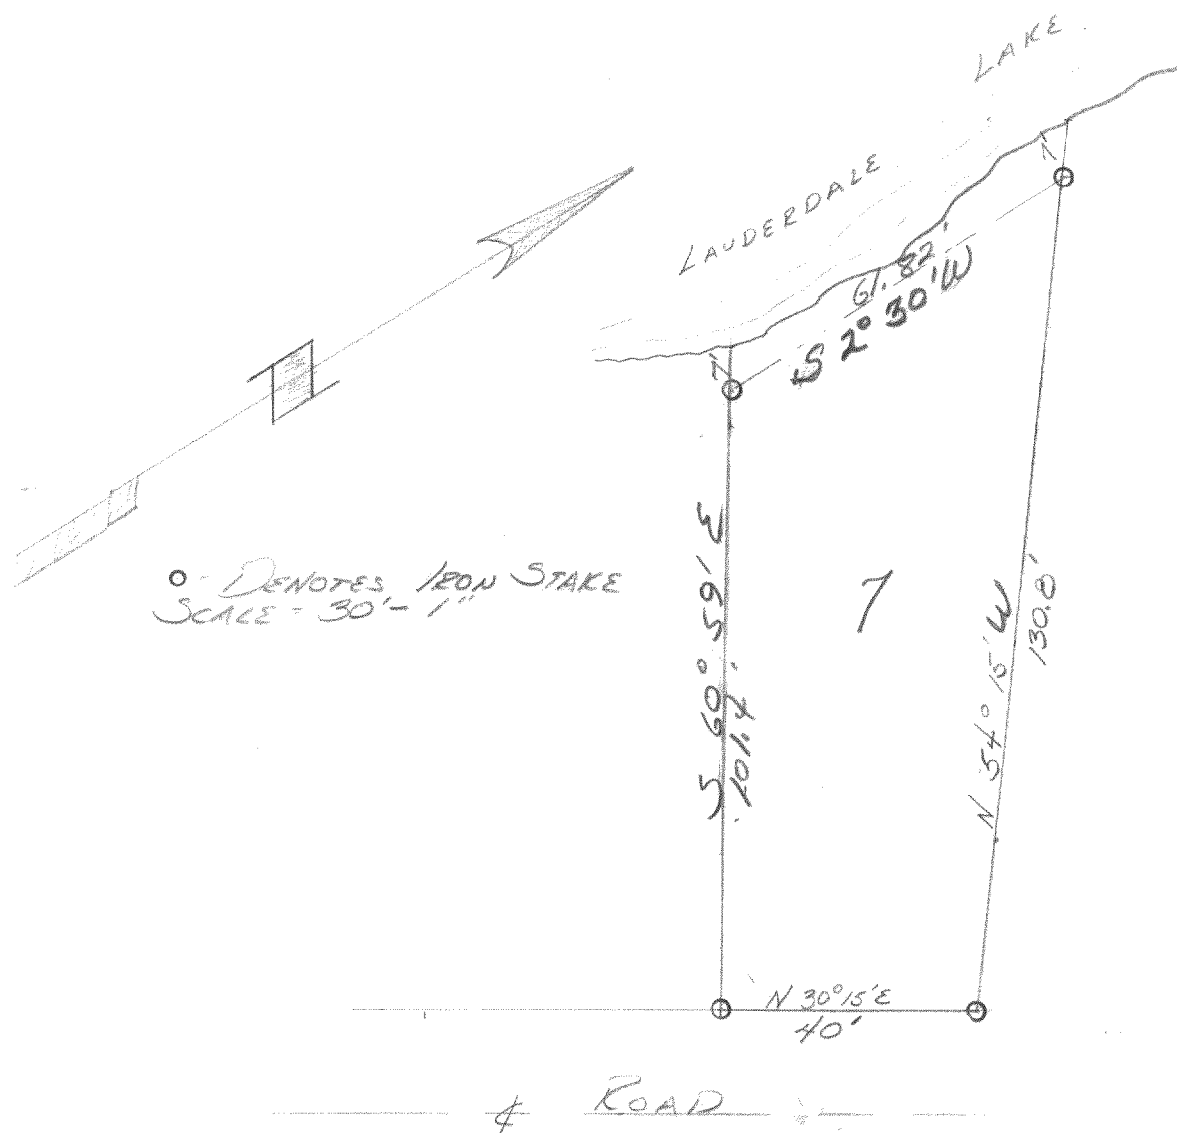


DESCRIPTION: All of Lot No. 7 except the Westerly 10 feet of Lot 7 of La Silva subdivision, a subdivision of a part of the N.W. $\frac{1}{4}$ of the S.E. $\frac{1}{4}$ of Section 26 T. 4, N., R 16, E. in the Town of La Grange, Walworth County, Wisconsin.

CERTIFICATE: I hereby certify that I have on this the 9th day of July 1956 surveyed the above property, and further certify that the exterior boundaries are as shown on this drawing.

SIGNED AND SEALED ON THIS THE 9th DAY OF JULY, 1956

Surveyor.

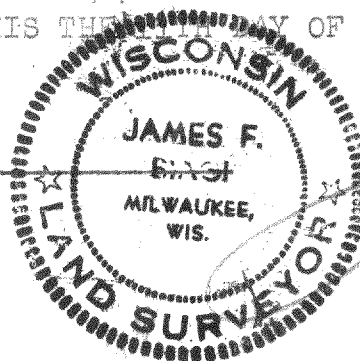

Reg. Land Surveyor. 272

416-132B

HL 5A

416-132B