


PLAT OF SURVEY



LOT 19 OF MORRIS PARK, LOCATED IN
SECTION 26, TOWN 4 NORTH, RANGE 16 EAST,
TOWN OF LAGRANGE, WALWORTH COUNTY,
WISCONSIN.

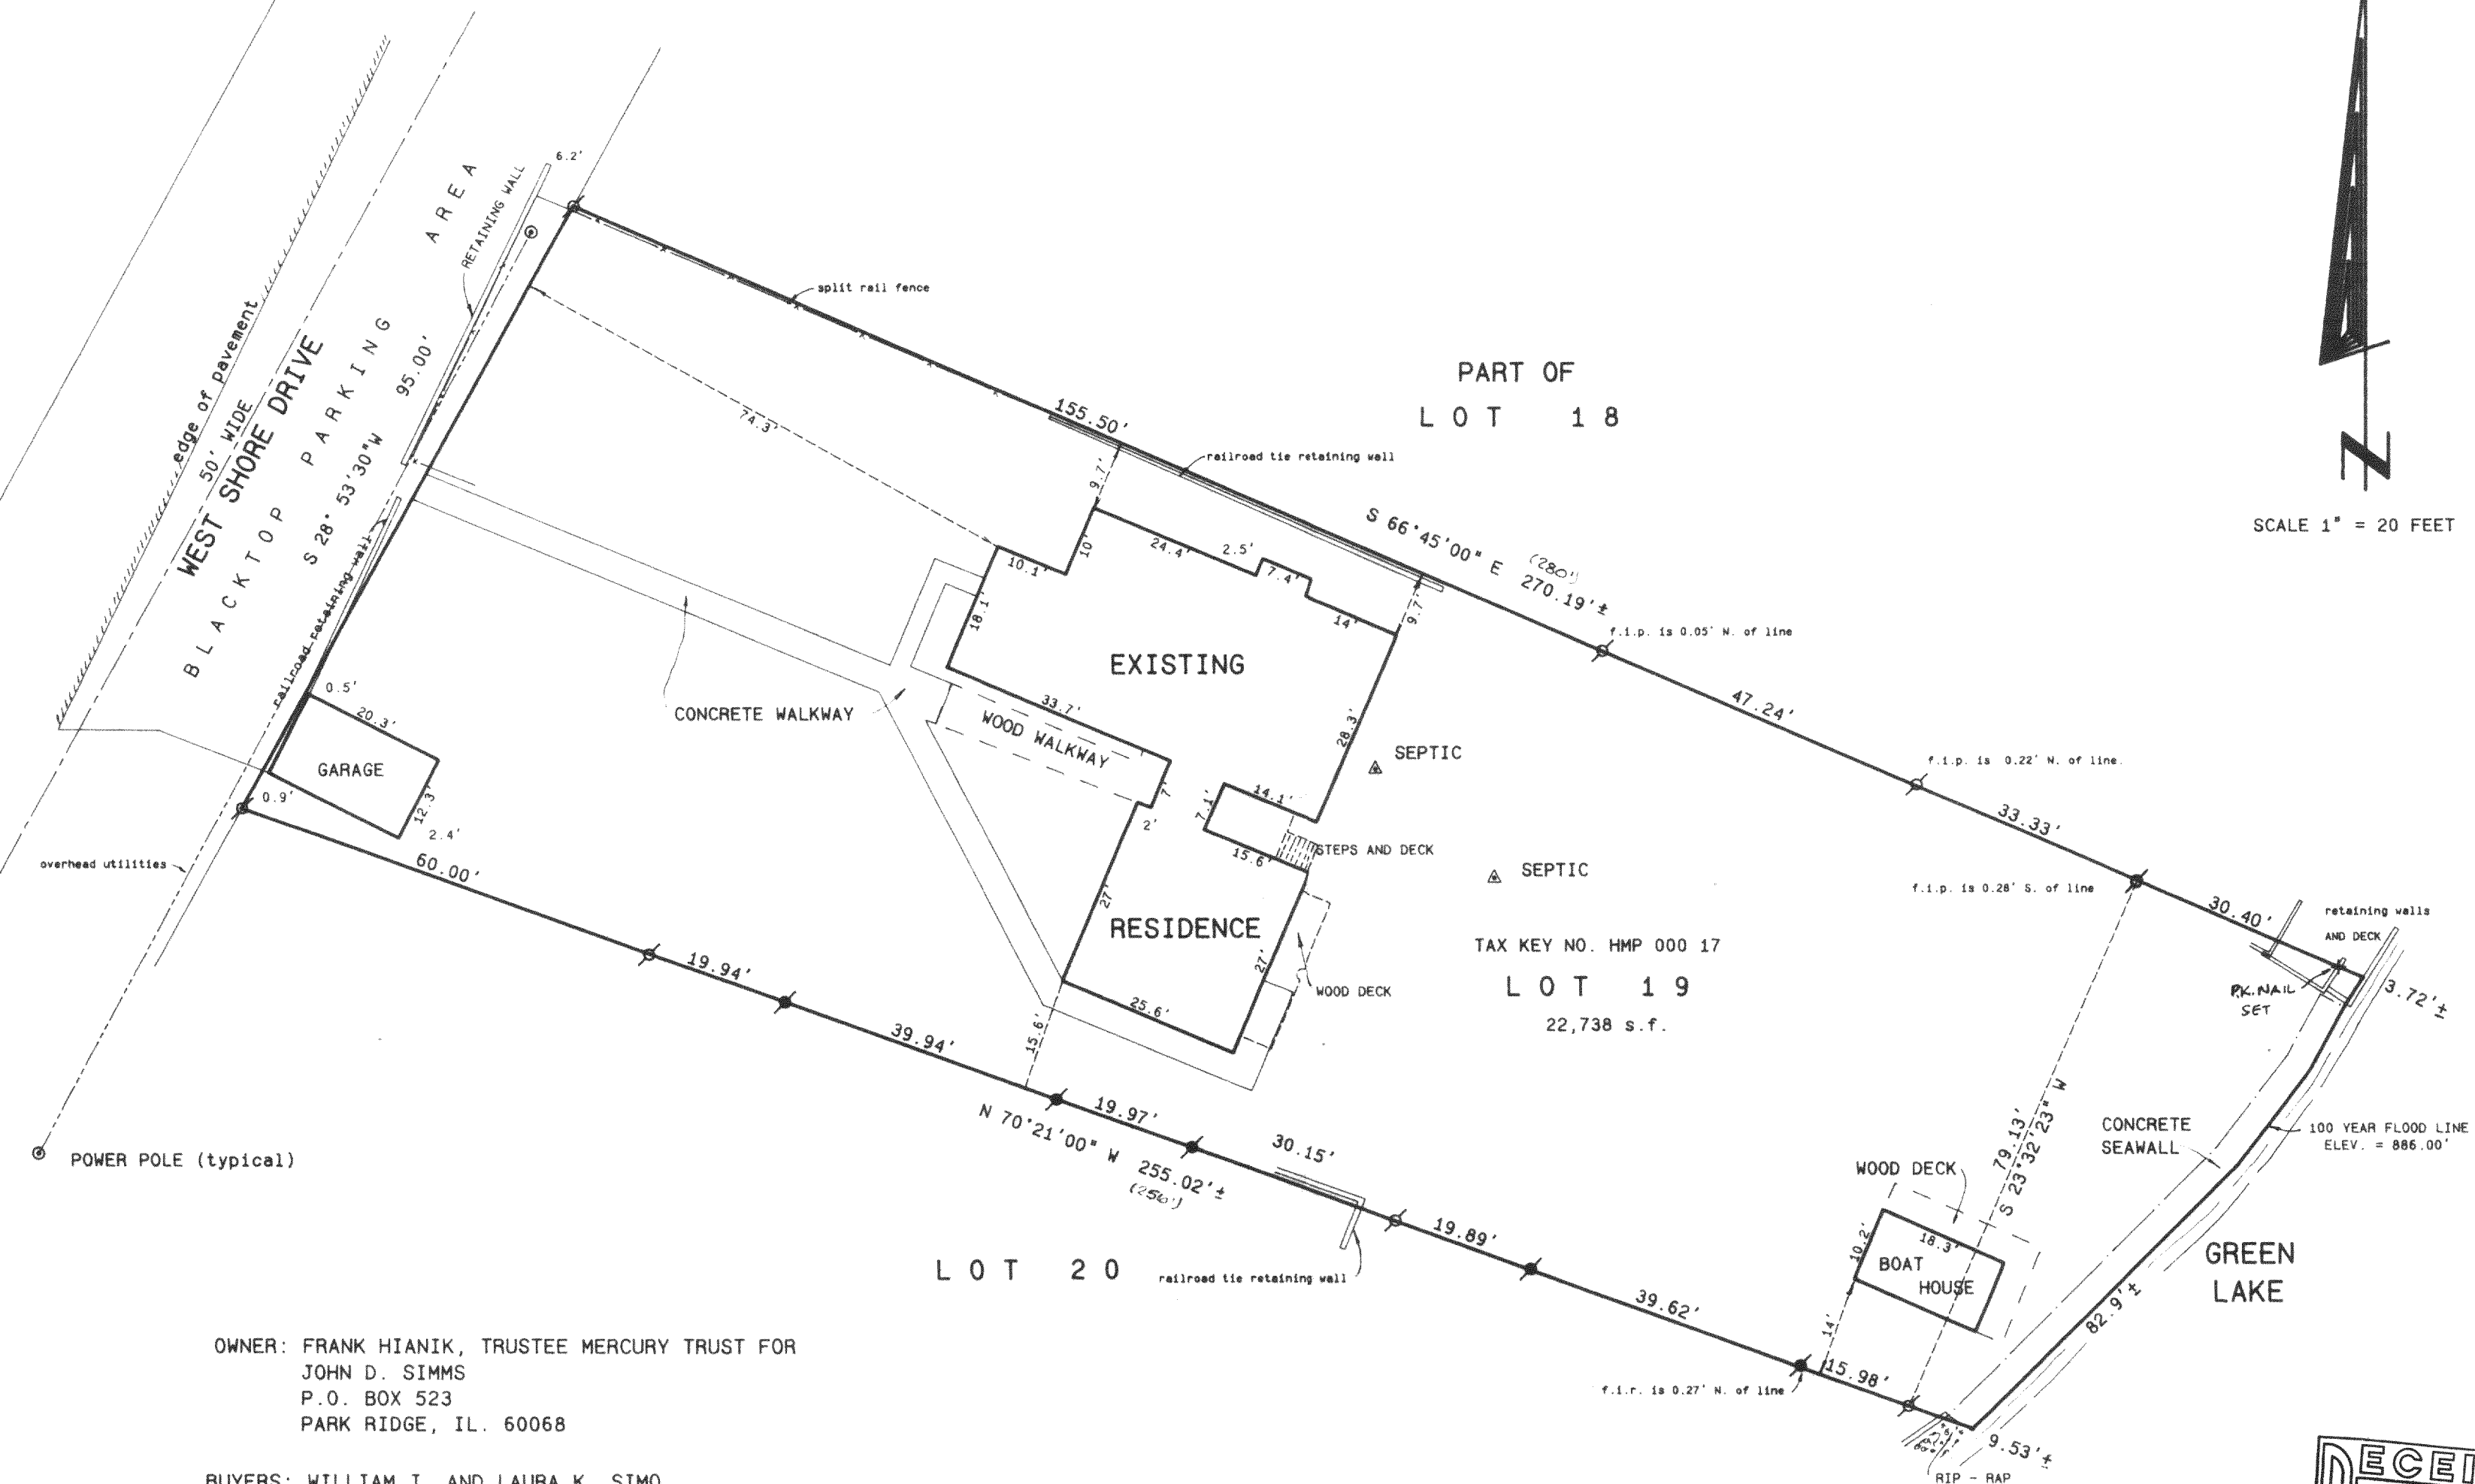

OWNER: FRANK HIANIK, TRUSTEE MERCURY TRUST FOR
JOHN D. SIMMS
P.O. BOX 523
PARK RIDGE, IL. 60068

BUYERS: WILLIAM J. AND LAURA K. SIMO

ORDERED BY: KEEFE REAL ESTATE
P.O. BOX 460
LAKE GENEVA, WI. 53147

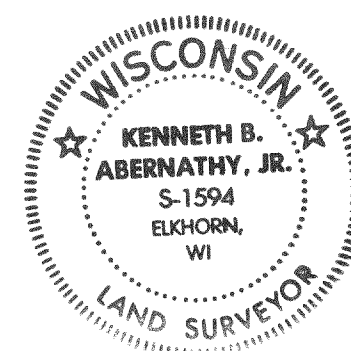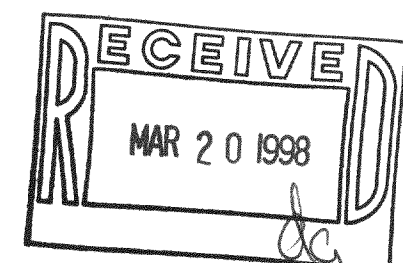

"I hereby certify that the above described property has been surveyed by me or under my direction and that the above map is a true representation thereof and shows the size and location of the property, its exterior boundaries, the location of all visible structures and dimensions of all principal buildings thereon, boundary fences, apparent easements, roadways and visible encroachments, if any."

"This survey is made for the use of the present owners of the property, and also those who purchase, mortgage, or guarantee the title thereto within one year from date hereof."

Kenneth B. Abernathy, Jr.
KENNETH B. ABERNATHY, JR.
WISCONSIN REGISTERED LAND SURVEYOR,
S-1594
Date: 3/3/98 Job No. 98.215