


PLAT OF SURVEY

PATHFINDER SURVEYING
FORMERLY KOLB LAND CONSULTING
929 WILLIAMS STREET LAKE GENEVA, WI. 53147
(414) 870-1894

ORDERED BY: CHERLY HANSEN
REMAX GENEVA REALTY
101 BROAD
LAKE GENEVA, WI. 53147

DATE: 2/ 17 / 1998



DESCRIPTION: LOT 26 , BLOCK 2, OF PEBBLE BEACH SUBDIVISION, LOCATED IN THE NORTHEAST 1/4 OF SECTION 26,
AND THE NORTHWEST 1/4 OF SECTION 25, T.4.N. , R.16.E. , WALWORTH COUNTY, WISCONSIN.

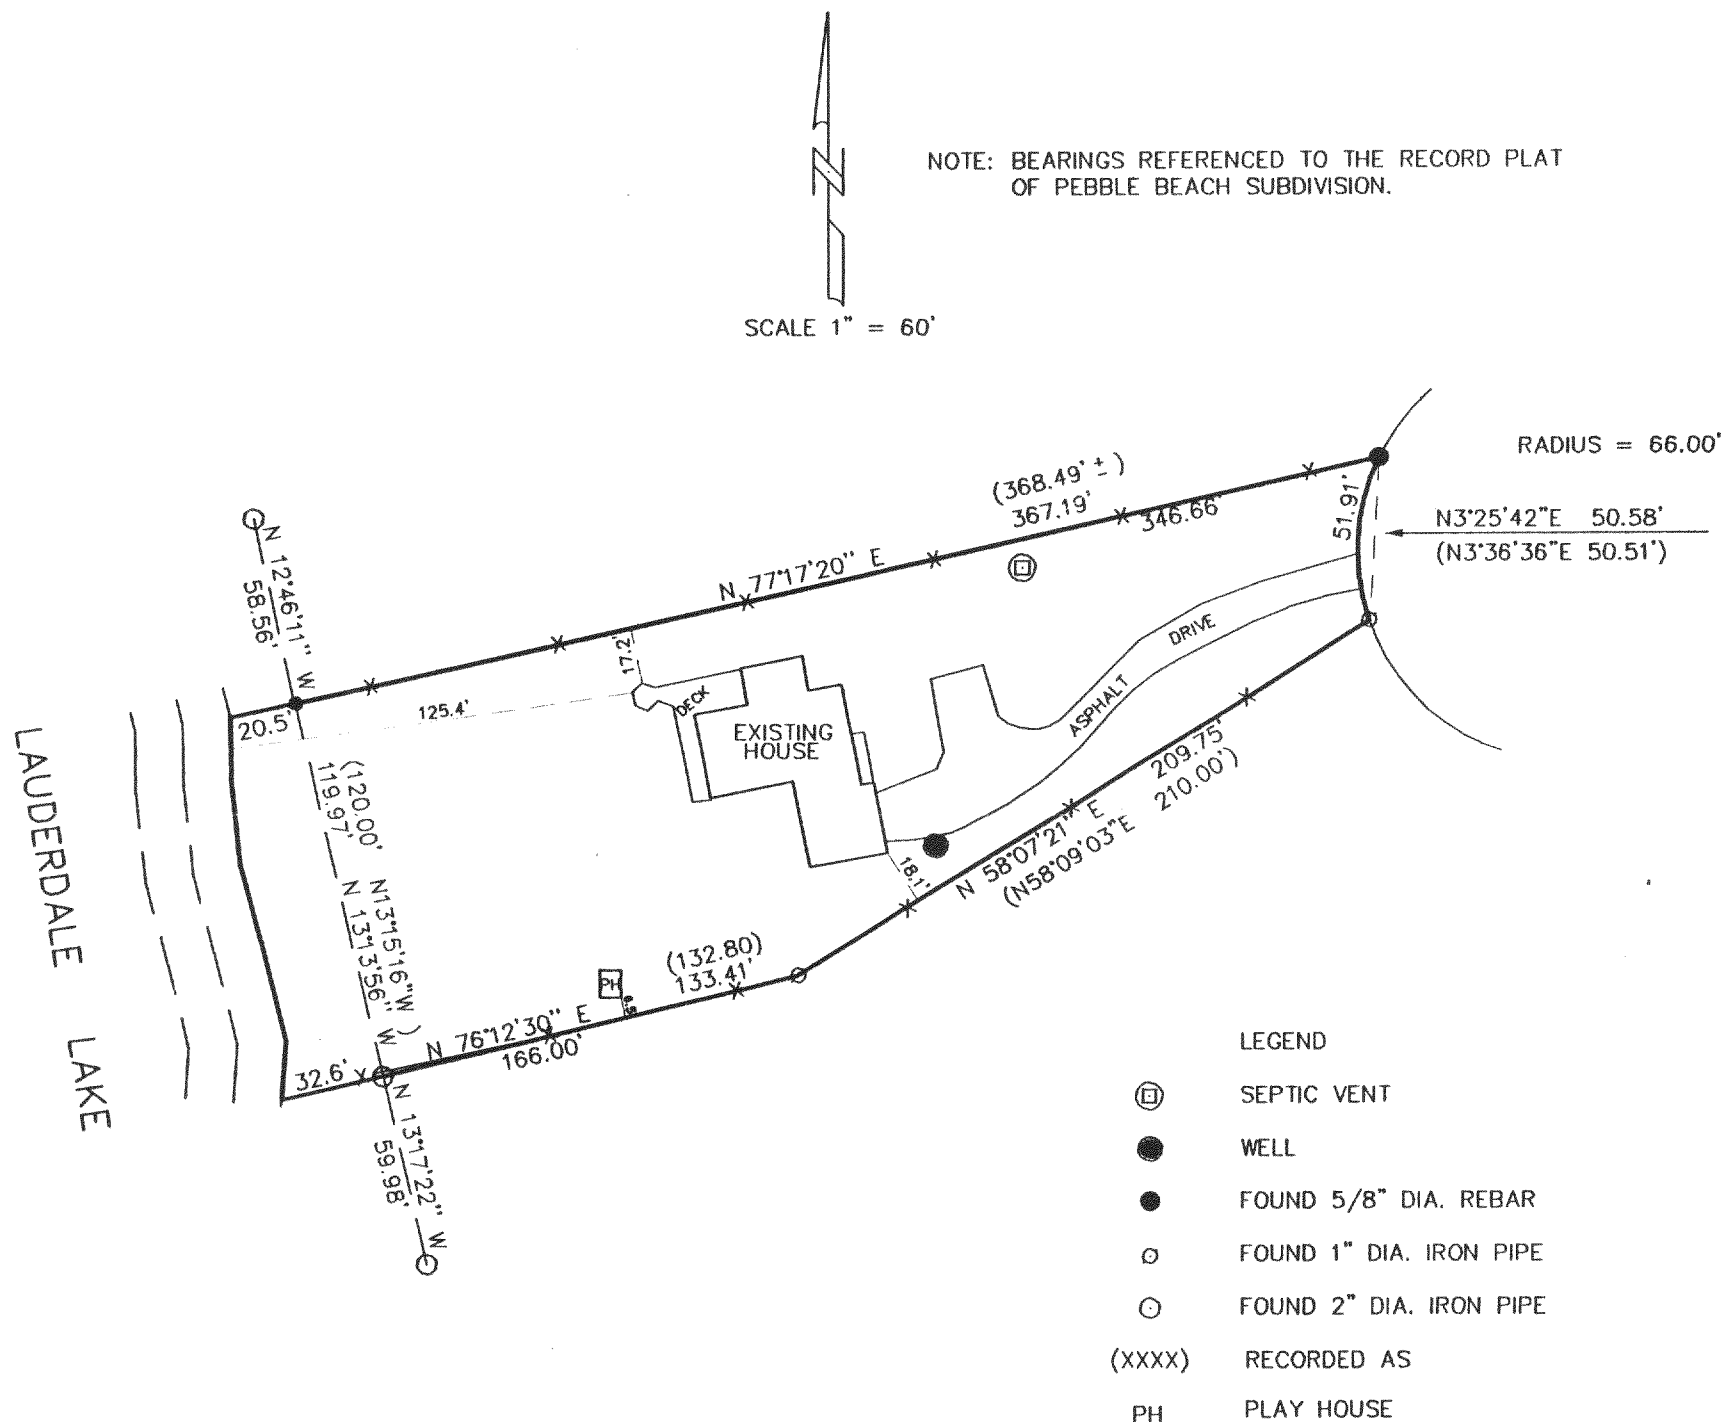

THE ABOVE MAP IS A TRUE REPRESENTATION THEREOF AND
SHOWS THE SIZE AND LOCATION OF ALL THE PROPERTY,
EXTERIOR BOUNDARIES, THE LOCATION OF ALL VISIBLE
BOUNDARY FENCES, APPARENT EASEMENTS, ROADWAYS
AND VISIBLE ENCROACHMENTS, IF ANY

THIS SURVEY IS MADE FOR THE USE OF THE PRESENT
OWNERS OF THE PROPERTY, AND ALSO THOSE WHO
PURCHASE, MORTGAGE OR GUARANTEE TITLE THERETO
WITHIN ONE (1) YEAR FROM DATE HERETO.

John P. Krott
JOHN P. KROTT, R.L.S. 2258

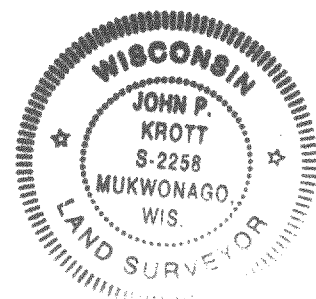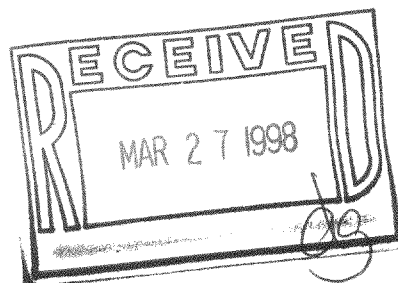

NOTE: THIS IS NOT A CERTIFIED COPY
UNLESS SEAL IS IN RED.

JOB NUMBER 4-16-00049 98013

HPE-49
416-1354