


PLAT OF SURVEY

DESCRIPTION: LOT 26 AND 27, BLOCK 2, OF PEBBLE BEACH SUBDIVISION, LOCATED IN THE NORTHEAST 1/4 OF SECTION 26, AND THE NORTHWEST 1/4 OF SECTION 25, T.4.N., R.16.E., WALWORTH COUNTY, WISCONSIN.

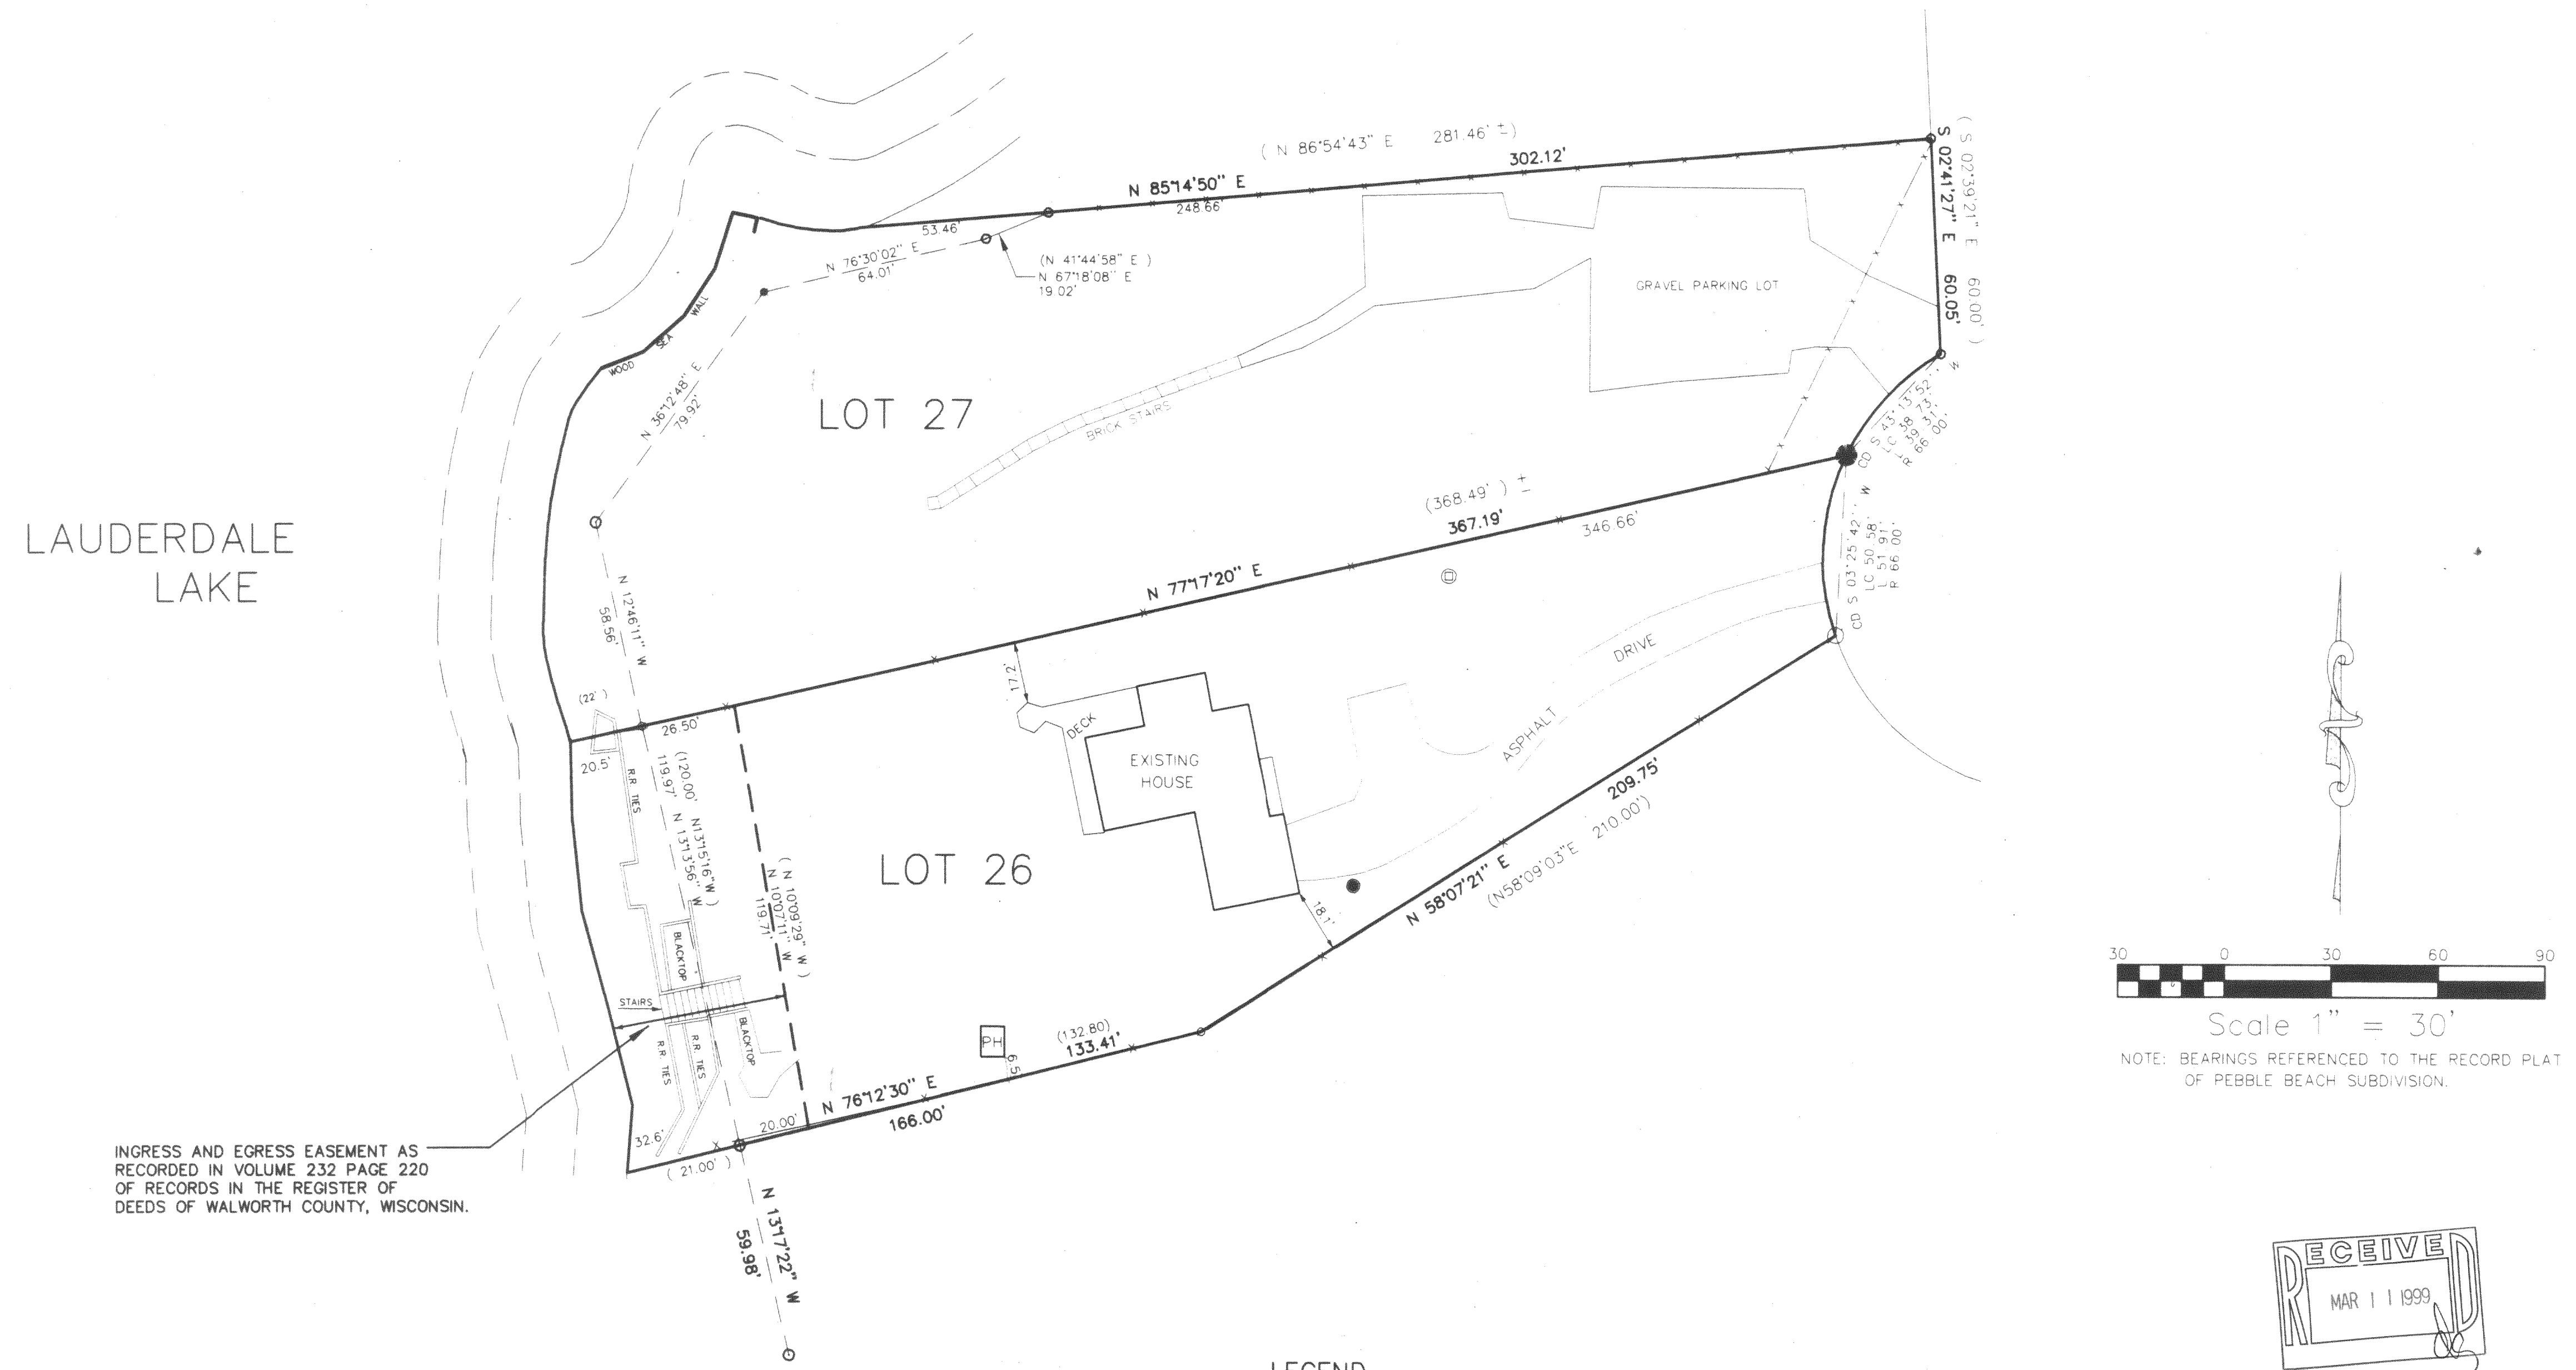

INGRESS AND EGRESS EASEMENT AS
RECORDED IN VOLUME 232 PAGE 220
OF RECORDS IN THE REGISTER OF
DEEDS OF WALWORTH COUNTY, WISCONSIN.

ORDERED BY:
GODFREY, NESHEK, WORTH, LEIBSLE & CONOVER, S.C.
11 NORTH WISCONSIN STREET P.O. BOX 260
ELKHORN, WI 53121

PATHFINDER SURVEYING

929 WILLIAMS STREET, LAKE GENEVA WISCONSIN 53147



(414) 248-3697

LEGEND

- ⊗ SEPTIC VENT
- WELL
- FOUND 5/8" DIA. REBAR
- FOUND 1" DIA. IRON PIPE
- FOUND 2" DIA. IRON PIPE
- (XXXX) RECORDED AS
- PH PLAY HOUSE
- SET 1 IN. DIA. IRON PIPE

THE ABOVE MAP IS A TRUE REPRESENTATION THEREOF AND
SHOWS THE SIZE AND LOCATION OF ALL THE PROPERTY,
EXTERIOR BOUNDARIES, THE LOCATION OF ALL VISIBLE
BOUNDARY FENCES, APPARENT EASEMENTS, ROADWAYS
AND VISIBLE ENCROACHMENTS, IF ANY.
THIS SURVEY IS MADE FOR THE USE OF THE PRESENT
OWNERS OF THE PROPERTY, AND ALSO THOSE WHO
PURCHASE, MORTGAGE OR GUARANTEE TITLE THERETO
WITHIN ONE (1) YEAR FROM DATE HERETO.

John P. Krott
JOHN P. KROTT, R.L.S. 2258

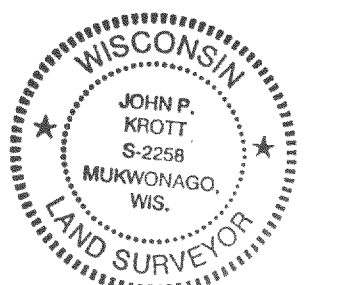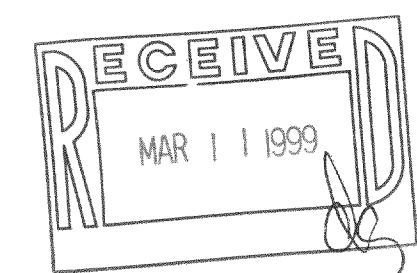

DATE: 12 / 17 / 1998

JOB NUMBER: 98013 4-16-HPE00049

416-1415