
ABELL SURVEYING & MAPPING DELAVAN, WISCONSIN 53115 414-728-6787

(N89°37'20"W 285.00')

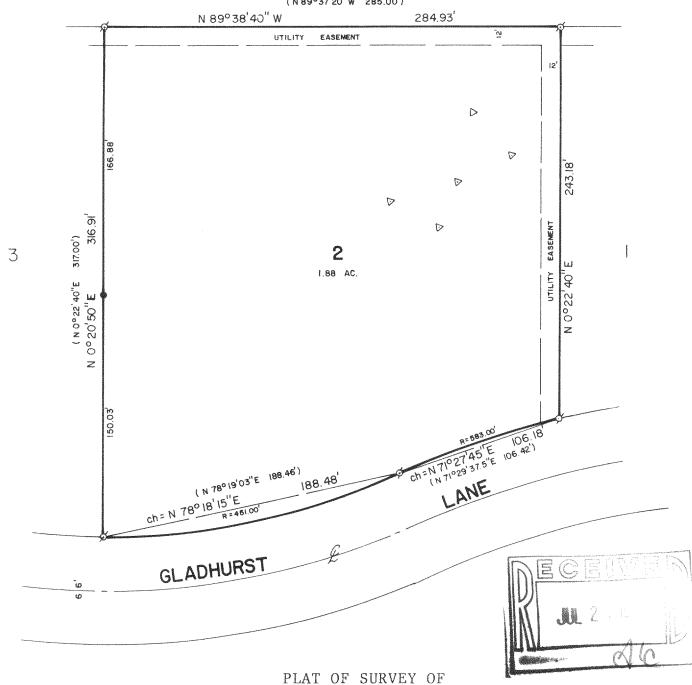

LOT 2 OF GLADHURST SUBDIVISION, LOCATED IN T4N, R16E, WALWORTH COUNTY, WISCONSIN.

ORDERED BY:

80443

ERA LANHAM REALTY

RECERTIFIED: APRIL 7, 1999

20 S. WASHINGTON ST. ELKHORN, WI.

ORDERED BY: DALE CARLSON

53121

P.O. BOX 675 FRISCO, COLORADO

THE BEARING ON THE EAST LINE OF LOT 2 OF GLADHURST

SUBDIVISION IS ASSUMED AS SHOWN ON THE SUBDIVISION

PLAT.



1"=60' SCALE

LEGEND Ø - IRON PIPE FOUND

- IRON ROD FOUND

△ - SOIL BORINGS ()- RECORDED AS

I HEREBY CERTIFY THAT I HAVE SURVEYED THE ABOVE DESCRIBED PROPERTY AND THAT THE ABOVE MAP IS A TRUE REPRESENTATION THEREOF AND SHOWS THE SIZE AND LOCATION OF THE PROPERTY, ITS EXTERIOR BOUNDARIES, THE LOCATION OF ALL VISIBLE STRUCTURES AND DIMENSIONS OF ALL PRINCIPAL BUILDINGS THEREON, BOUNDARY FENCES, AFPARENT EASEMENTS, ROADWAYS AND VISIBLE ENCROACHMENTS, IF ANY, TO THE BEST OF MY KNOWLEDGE AND BELIEF.

THIS SURVEY IS MADE FOR THE USE OF THE PRESENT OWNERS OF THE PROPERTY, AND ALSO THOSE WHO PURCHASE, HORIGAGE, OR GUARANTEE THE TITLE THERETO WITHIN ONE (1) YEAR FROM DATE HEREOF.

DAVID F. ABELL
WISCONSIN REGISTERED LAND SURVEYOR, S-1596

1990 ept. 24, 1990 RECERTIFIED: APRIL 7, 1999
THIS IS NOT A CERTIFIED COPY UNLESS SEALED. 90193

416-1494 HG-2