

ABERNATHY and ASSOCIATES

Kenneth B. Abernathy Jr.

Wisconsin Registered Land Surveyor S-1594

Rt. 3, Box 273
Elkhorn, Wisconsin 53121
Phone: (414) 723-4260 (office)
(414) 723-7209 (FAX)

PLAT OF SURVEY


LOT 8 OF WALNUT HILLS
SUBDIVISION LOCATED IN THE
NE 1/4 OF THE NW 1/4 AND
THE NW 1/4 OF THE NE 1/4
AND THE SW 1/4 OF THE NE
1/4 OF SECTION 36, TOWN 4
NORTH, RANGE 16 EAST,
WALWORTH COUNTY, WISCONSIN.

OWNER: MARK LORENZ
W4994 HAWK DR.
ELKHORN, WI. 53121

ORDERED BY: MARILYN MOHNS
C/O KEEFE REAL ESTATE
1155 E. GENEVA
DELAVER, WI. 53115

NOTE:


PLAT IS RECORDED IN
CABINET B AS SLIDE 7

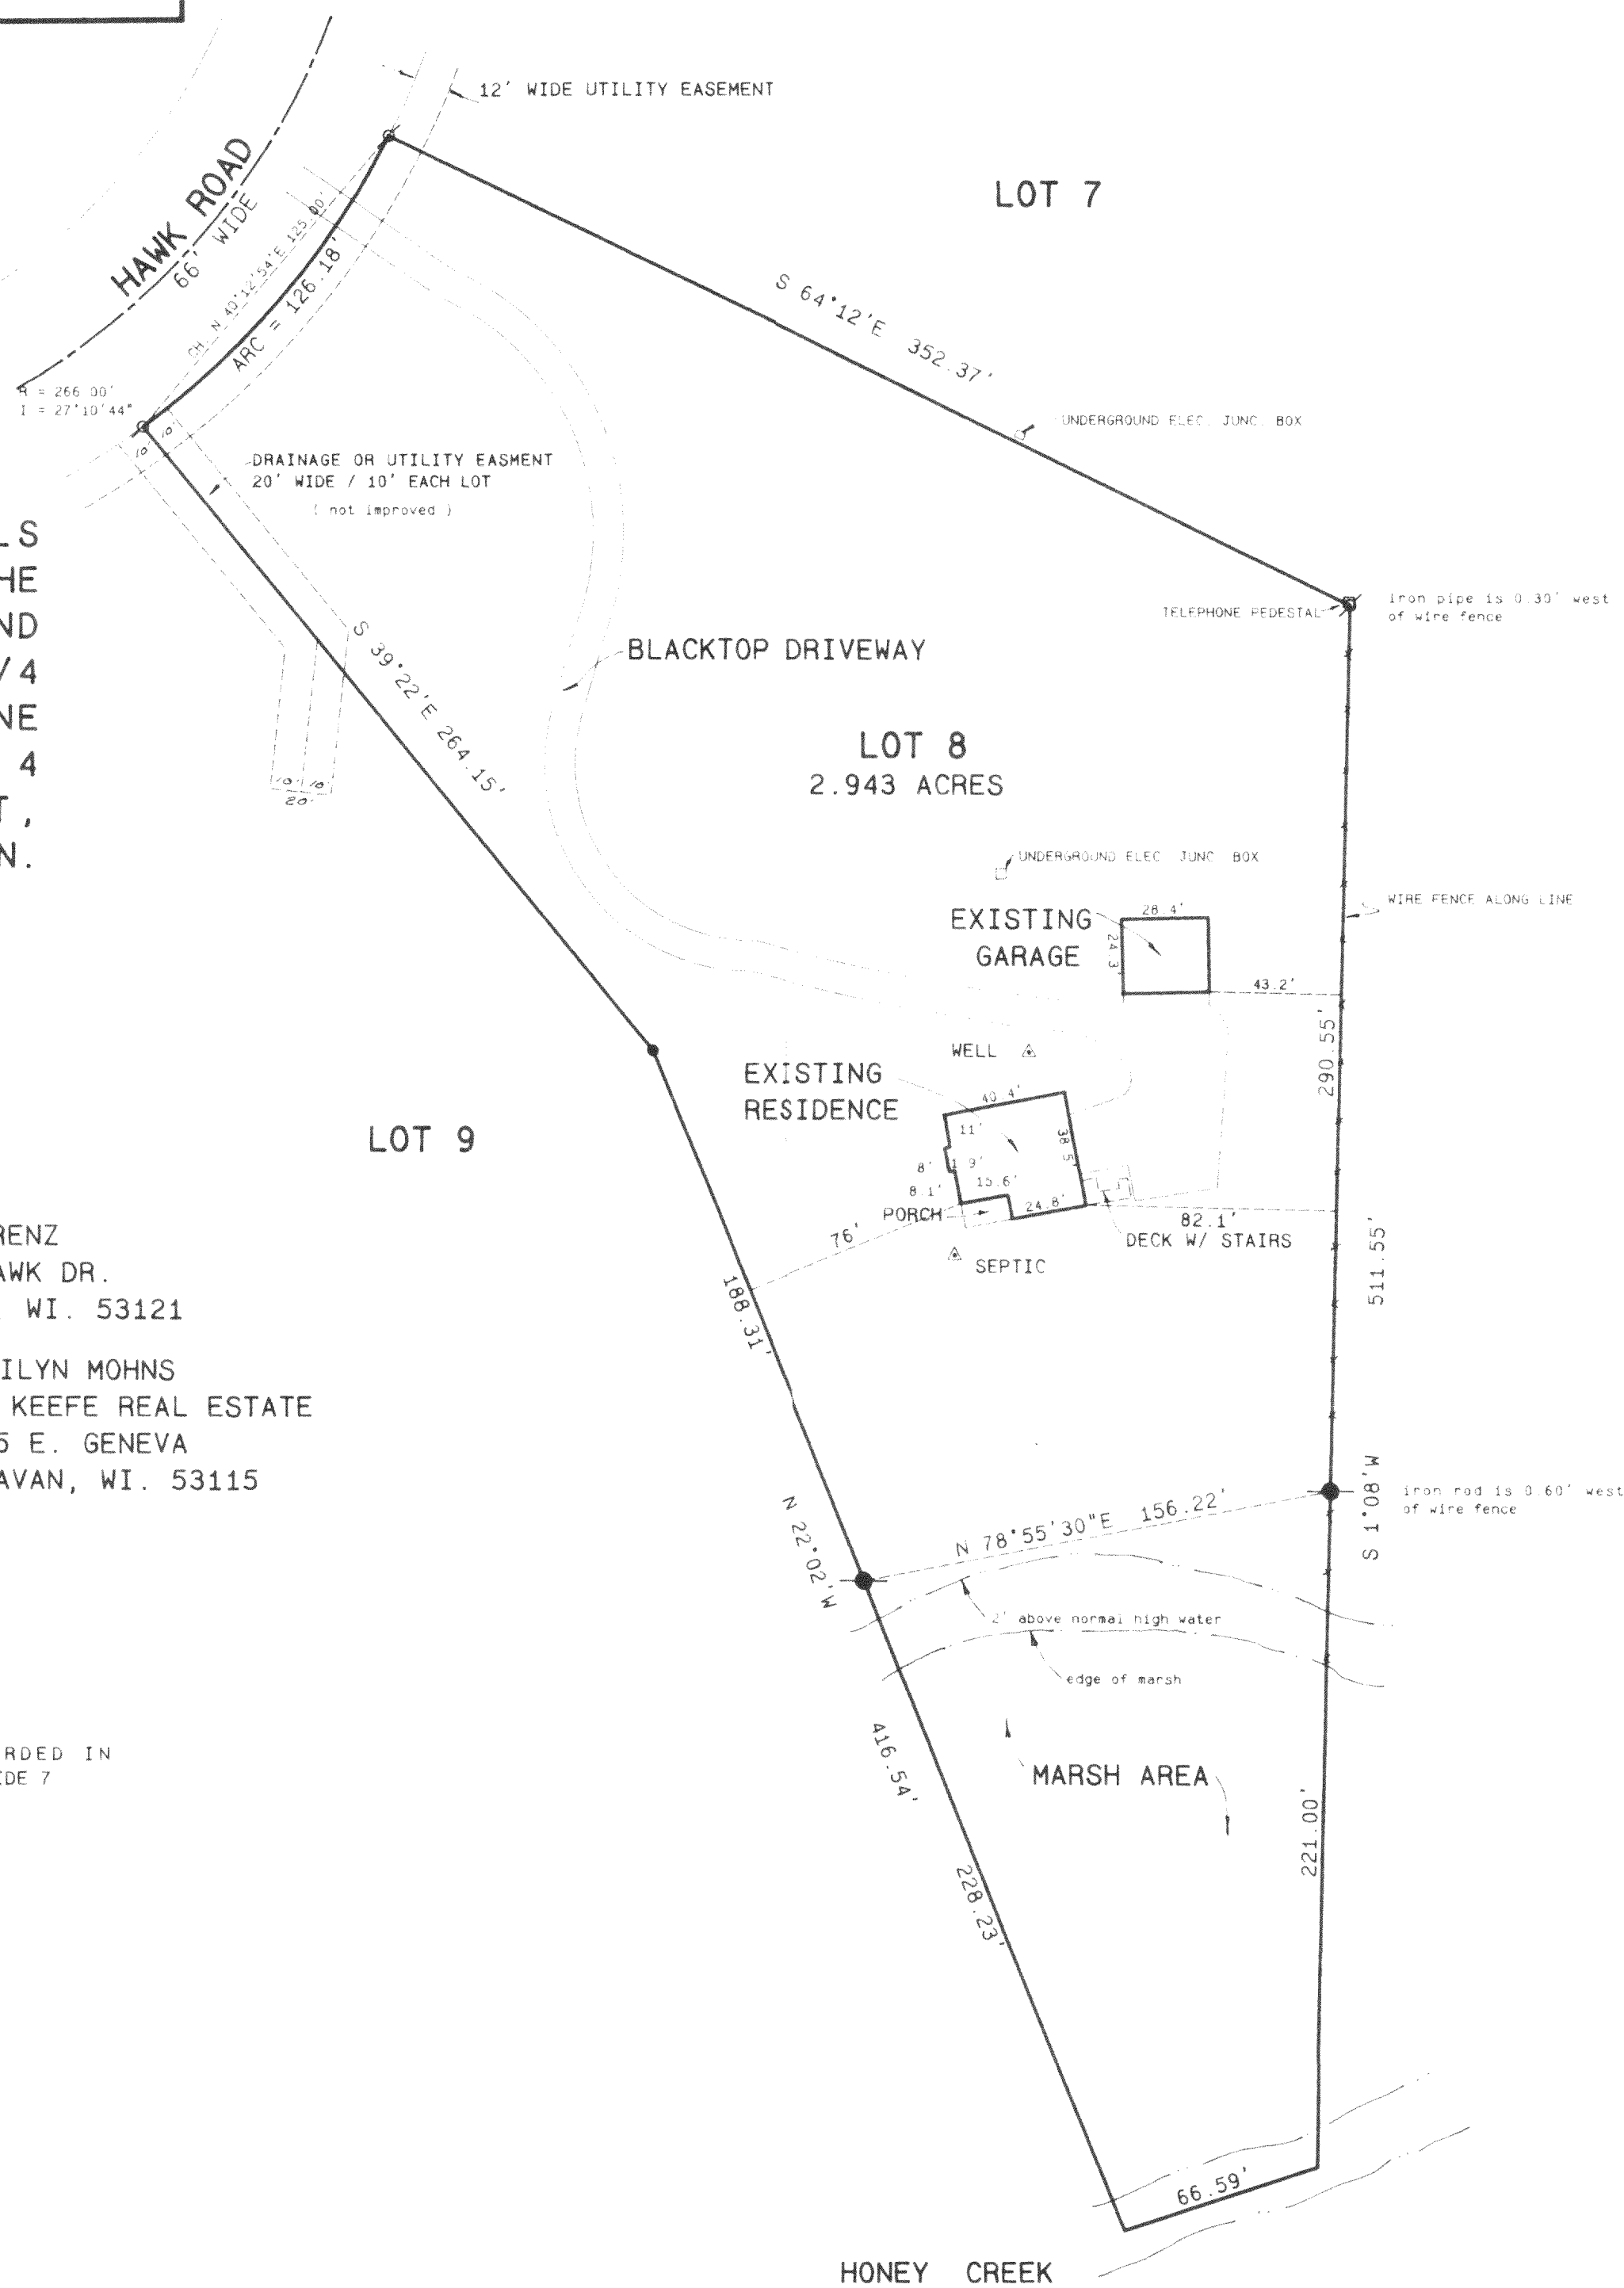


SCALE 1" = 50 FEET

Legend

- FOUND IRON PIPE
- FOUND IRON ROD
- FOUND BRASS CAPPED MONUMENT
- ✕ FOUND CONCRETE MONUMENT
- ✕ CHISEL CUT IN CONCRETE
- SET IRON ROD, 24" LONG, WEIGHING 1.5 LBS. LINEAL FT. 1/4" DIA.
- SET IRON ROD, 30" LONG, WEIGHING 4.5 LBS. LINEAL FT. 1/4" DIA.
- RECORDED AS DIMENSION
- EXISTING FENCE

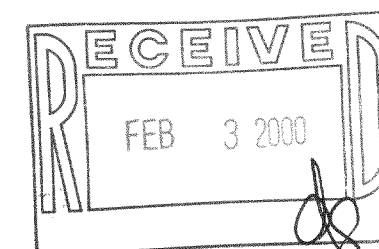

SCALE: 1" = 50 FEET

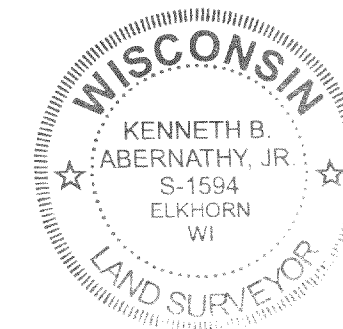

REVISED OCTOBER 10, 1999

I hereby certify that the above described property has been surveyed by me in accordance with the laws of the State of Wisconsin and that the above map is a true and correct representation thereof and shows the size and location of the property, its external boundaries, the location of all visible structures and dimensions of all portions, buildings, thereon, boundary fences, apparent easements, roadways and visible encroachments, if any.

This survey is made for the use of the present owners of the property and as to those who purchase, mortgage, or otherwise acquire the title thereto within one year from date hereof.

Kenneth B. Abernathy, Jr.
KENNETH B. ABERNATHY, JR.
WISCONSIN REGISTERED LAND SURVEYOR,
S-1594

Date: MARCH 2, 1995 Job No. 95.206

416-1549

HTLW-8