


FARRIS, HANSEN & ASSOCIATES, INC.

ENGINEERING — ARCHITECTURE — SURVEYING
7 RIDGWAY COURT — P.O. BOX 437 — ELKHORN, WISCONSIN 53121
PHONE: (262) 723-2098 FAX: (262) 723-5886

LOT 1 OF CERTIFIED SURVEY MAP NO. 2231

LOCATED IN THE NW 1/4 OF SEC. 1

T. 4 N., R. 16 E., WALWORTH COUNTY, WISCONSIN

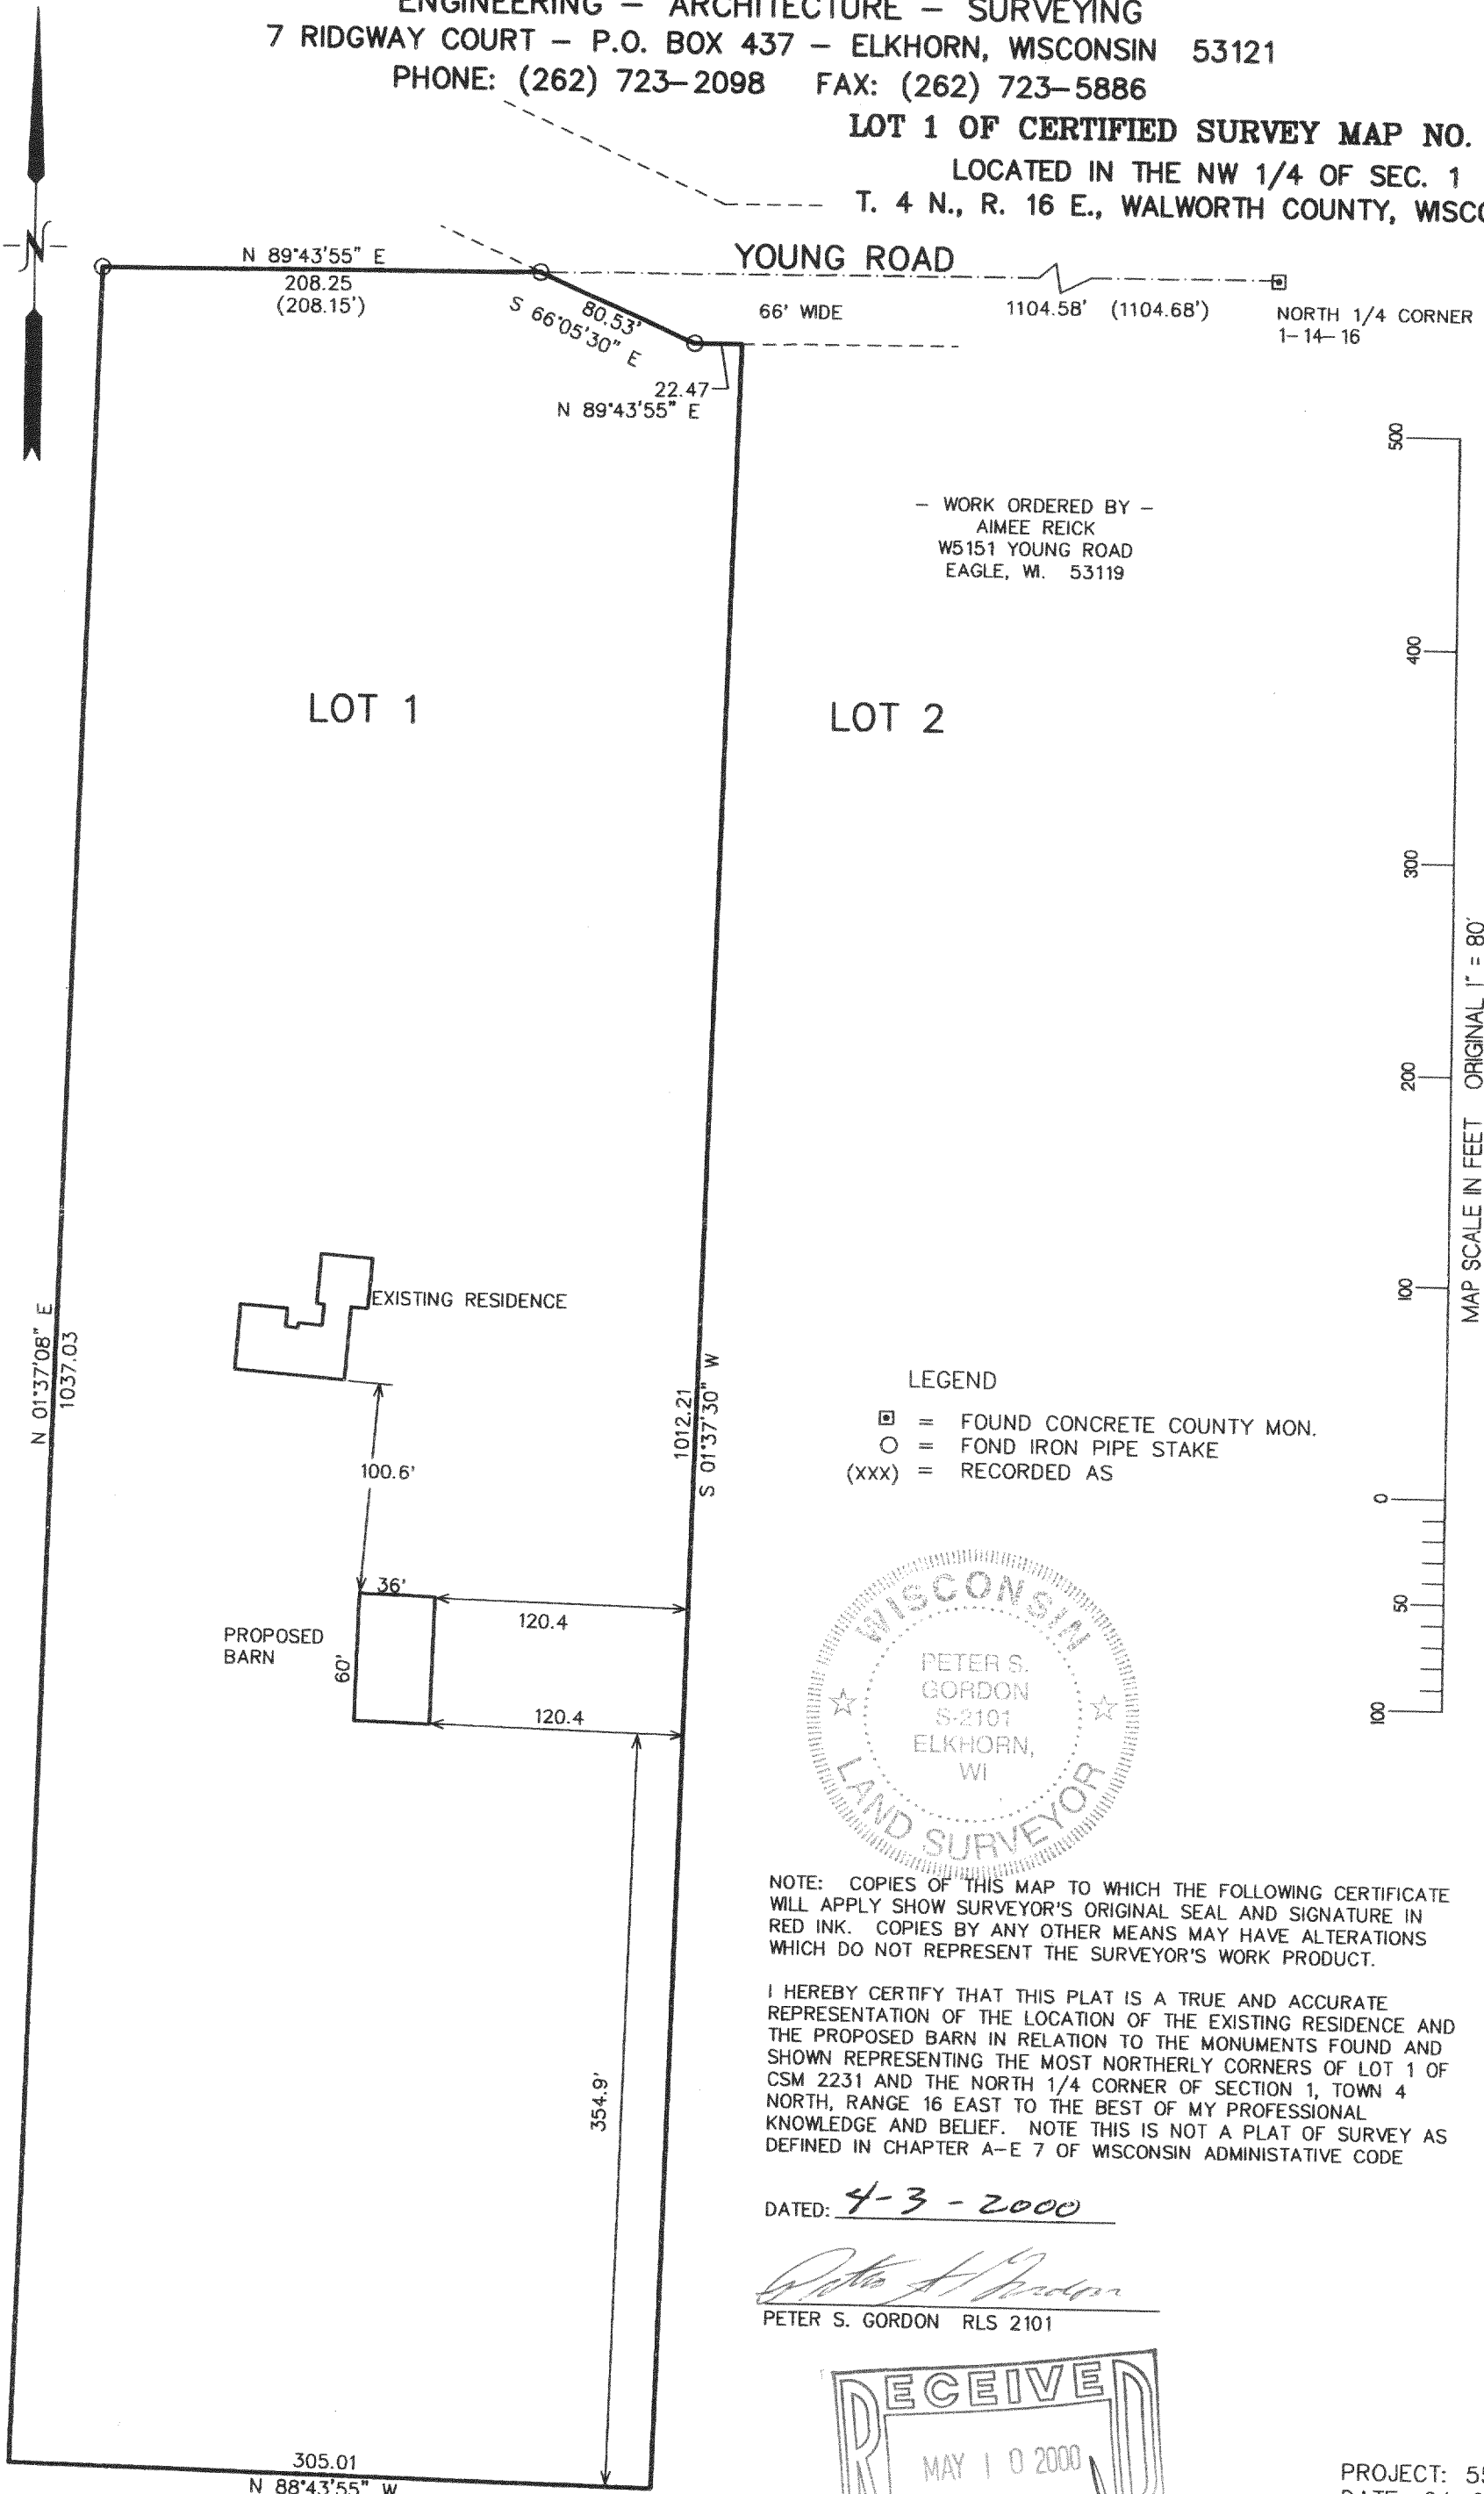

HA-2231-1
APR 03 2000 416-1573