


LEGEND:

- - IRON PIPE FOUND
- - IRON PIPE SET

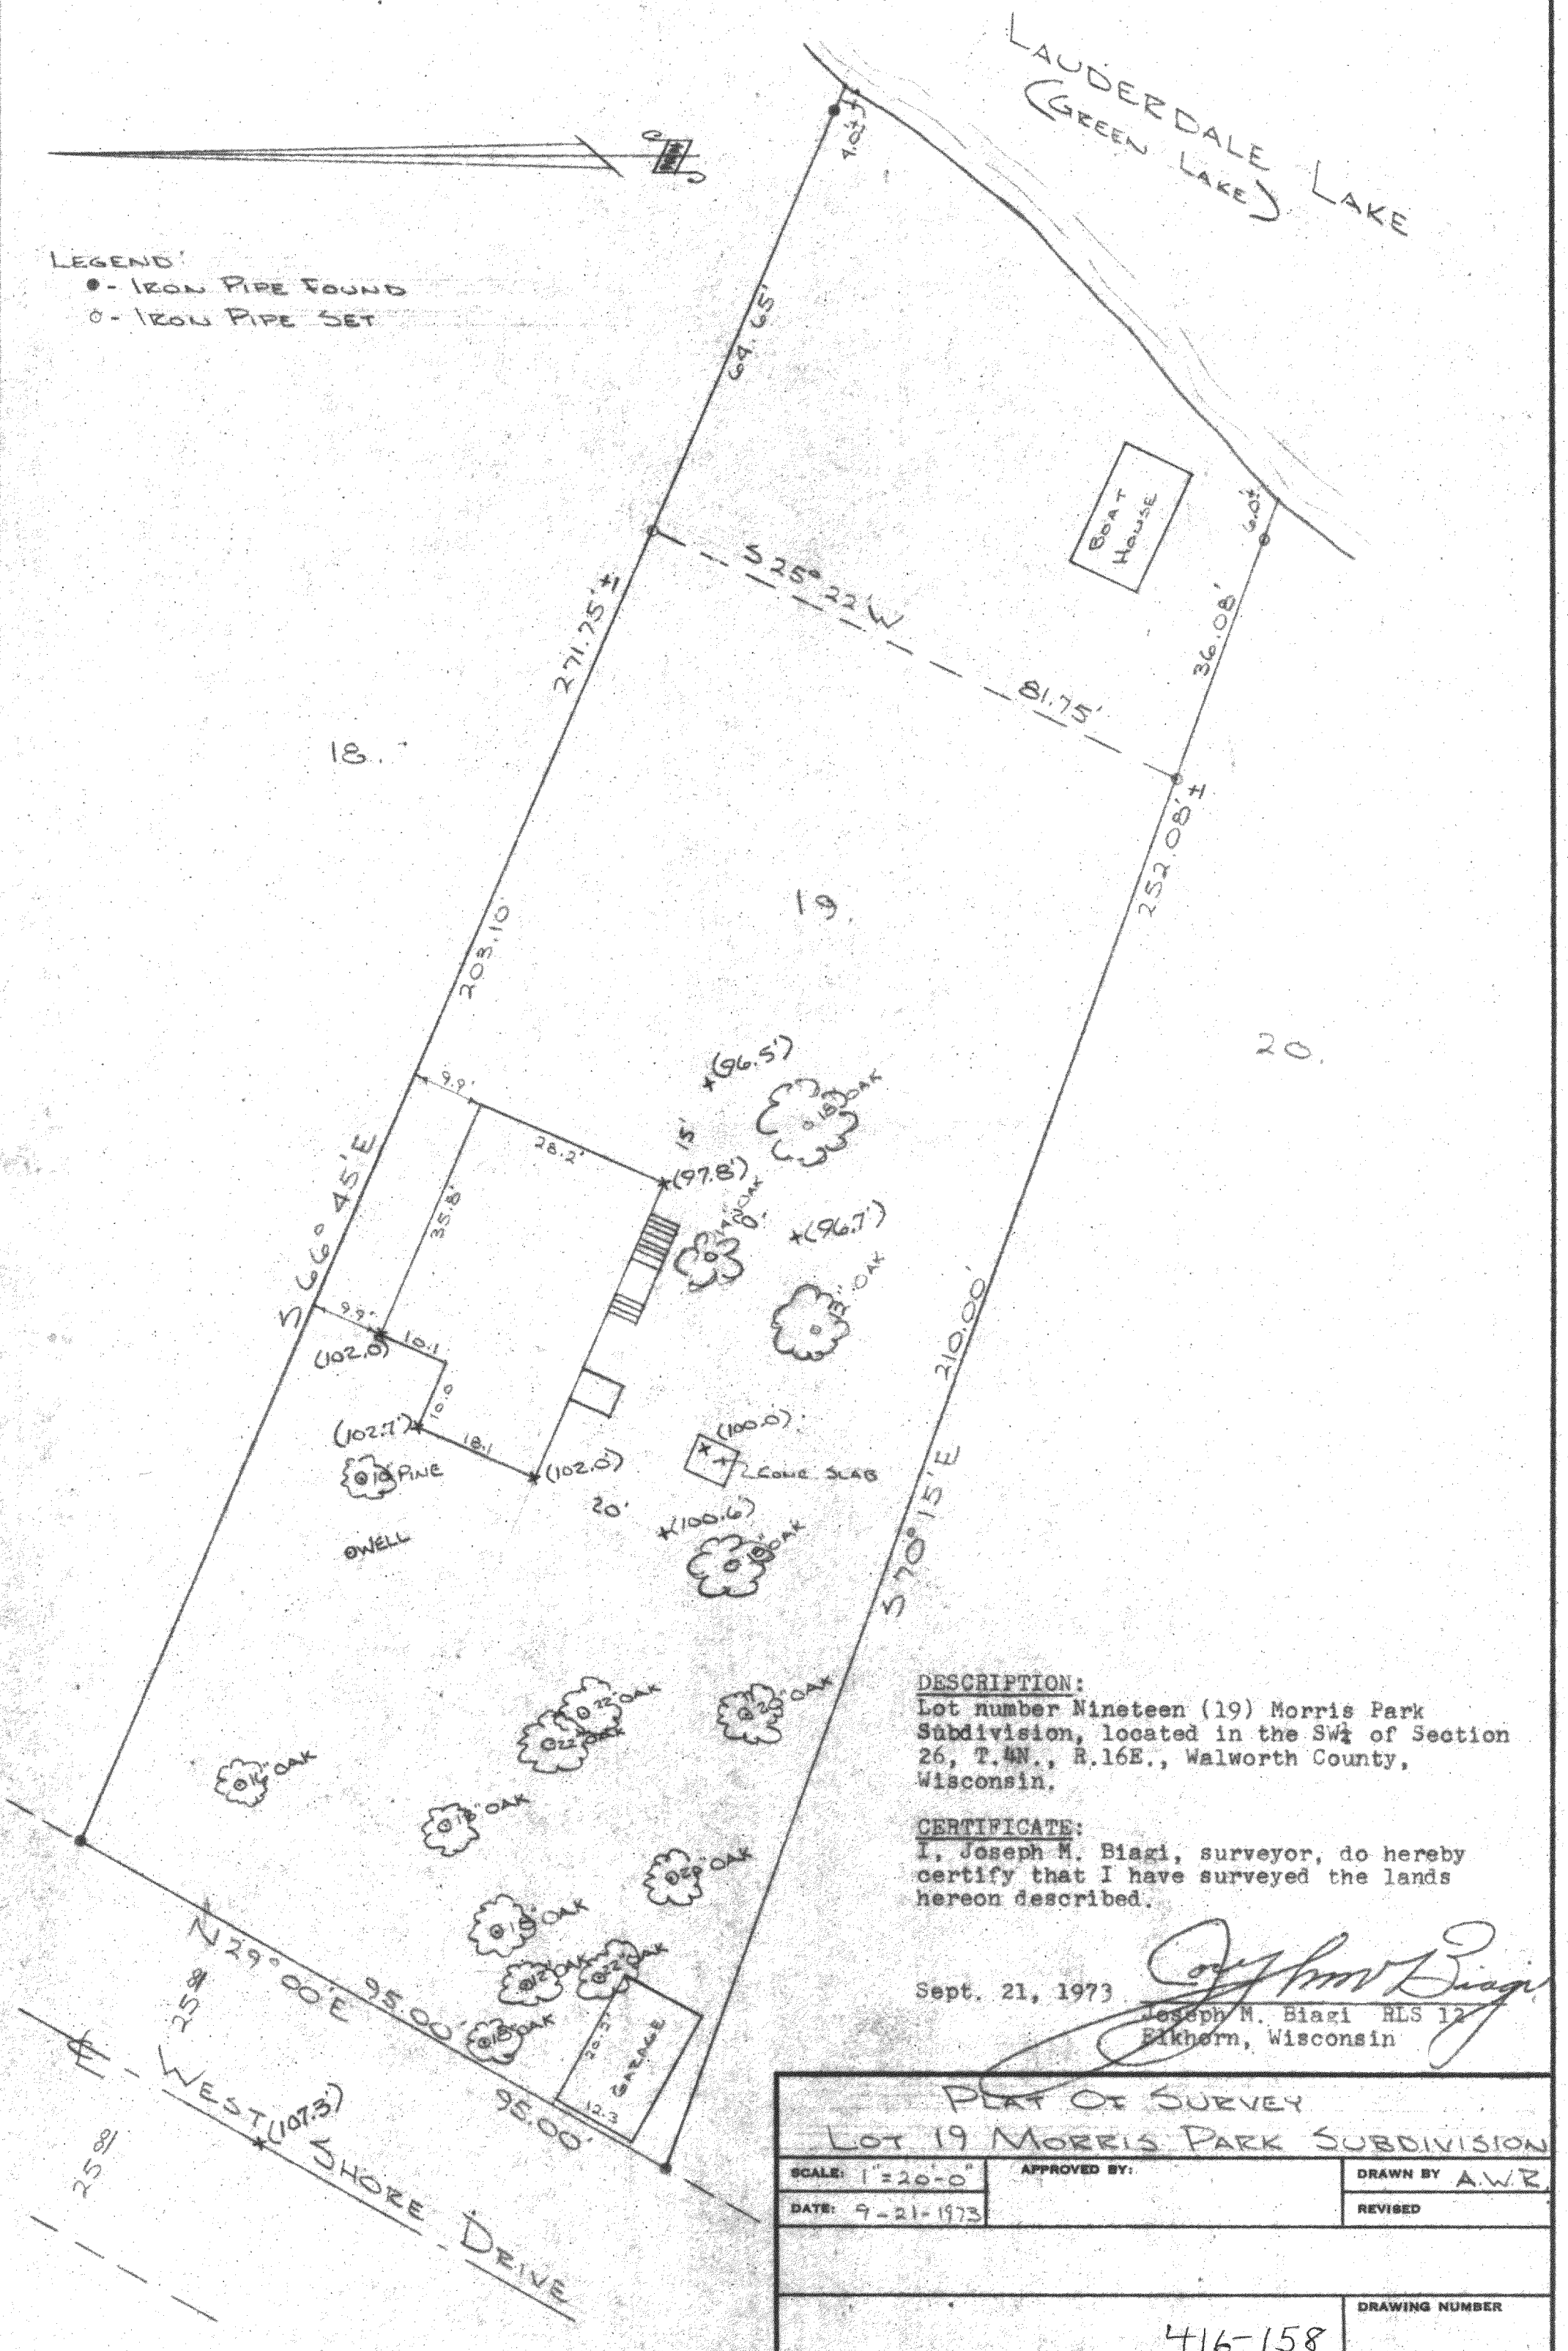

DESCRIPTION:

Lot number Nineteen (19) Morris Park Subdivision, located in the SW $\frac{1}{4}$ of Section 26, T.4N., R.16E., Walworth County, Wisconsin.

CERTIFICATE:

I, Joseph M. Biagi, surveyor, do hereby certify that I have surveyed the lands hereon described.

Sept. 21, 1973

Joseph M. Biagi RLS 12
Elkhorn, Wisconsin

PLAT OF SURVEY
LOT 19 MORRIS PARK SUBDIVISION

SCALE: 1"=20'-0"	APPROVED BY:	DRAWN BY A.W.R.
DATE: 9-21-1973		REVISED

DRAWING NUMBER

416-158