
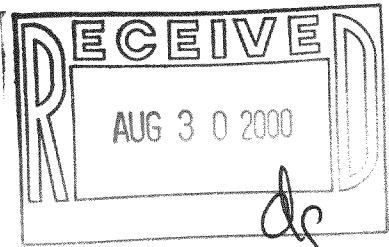
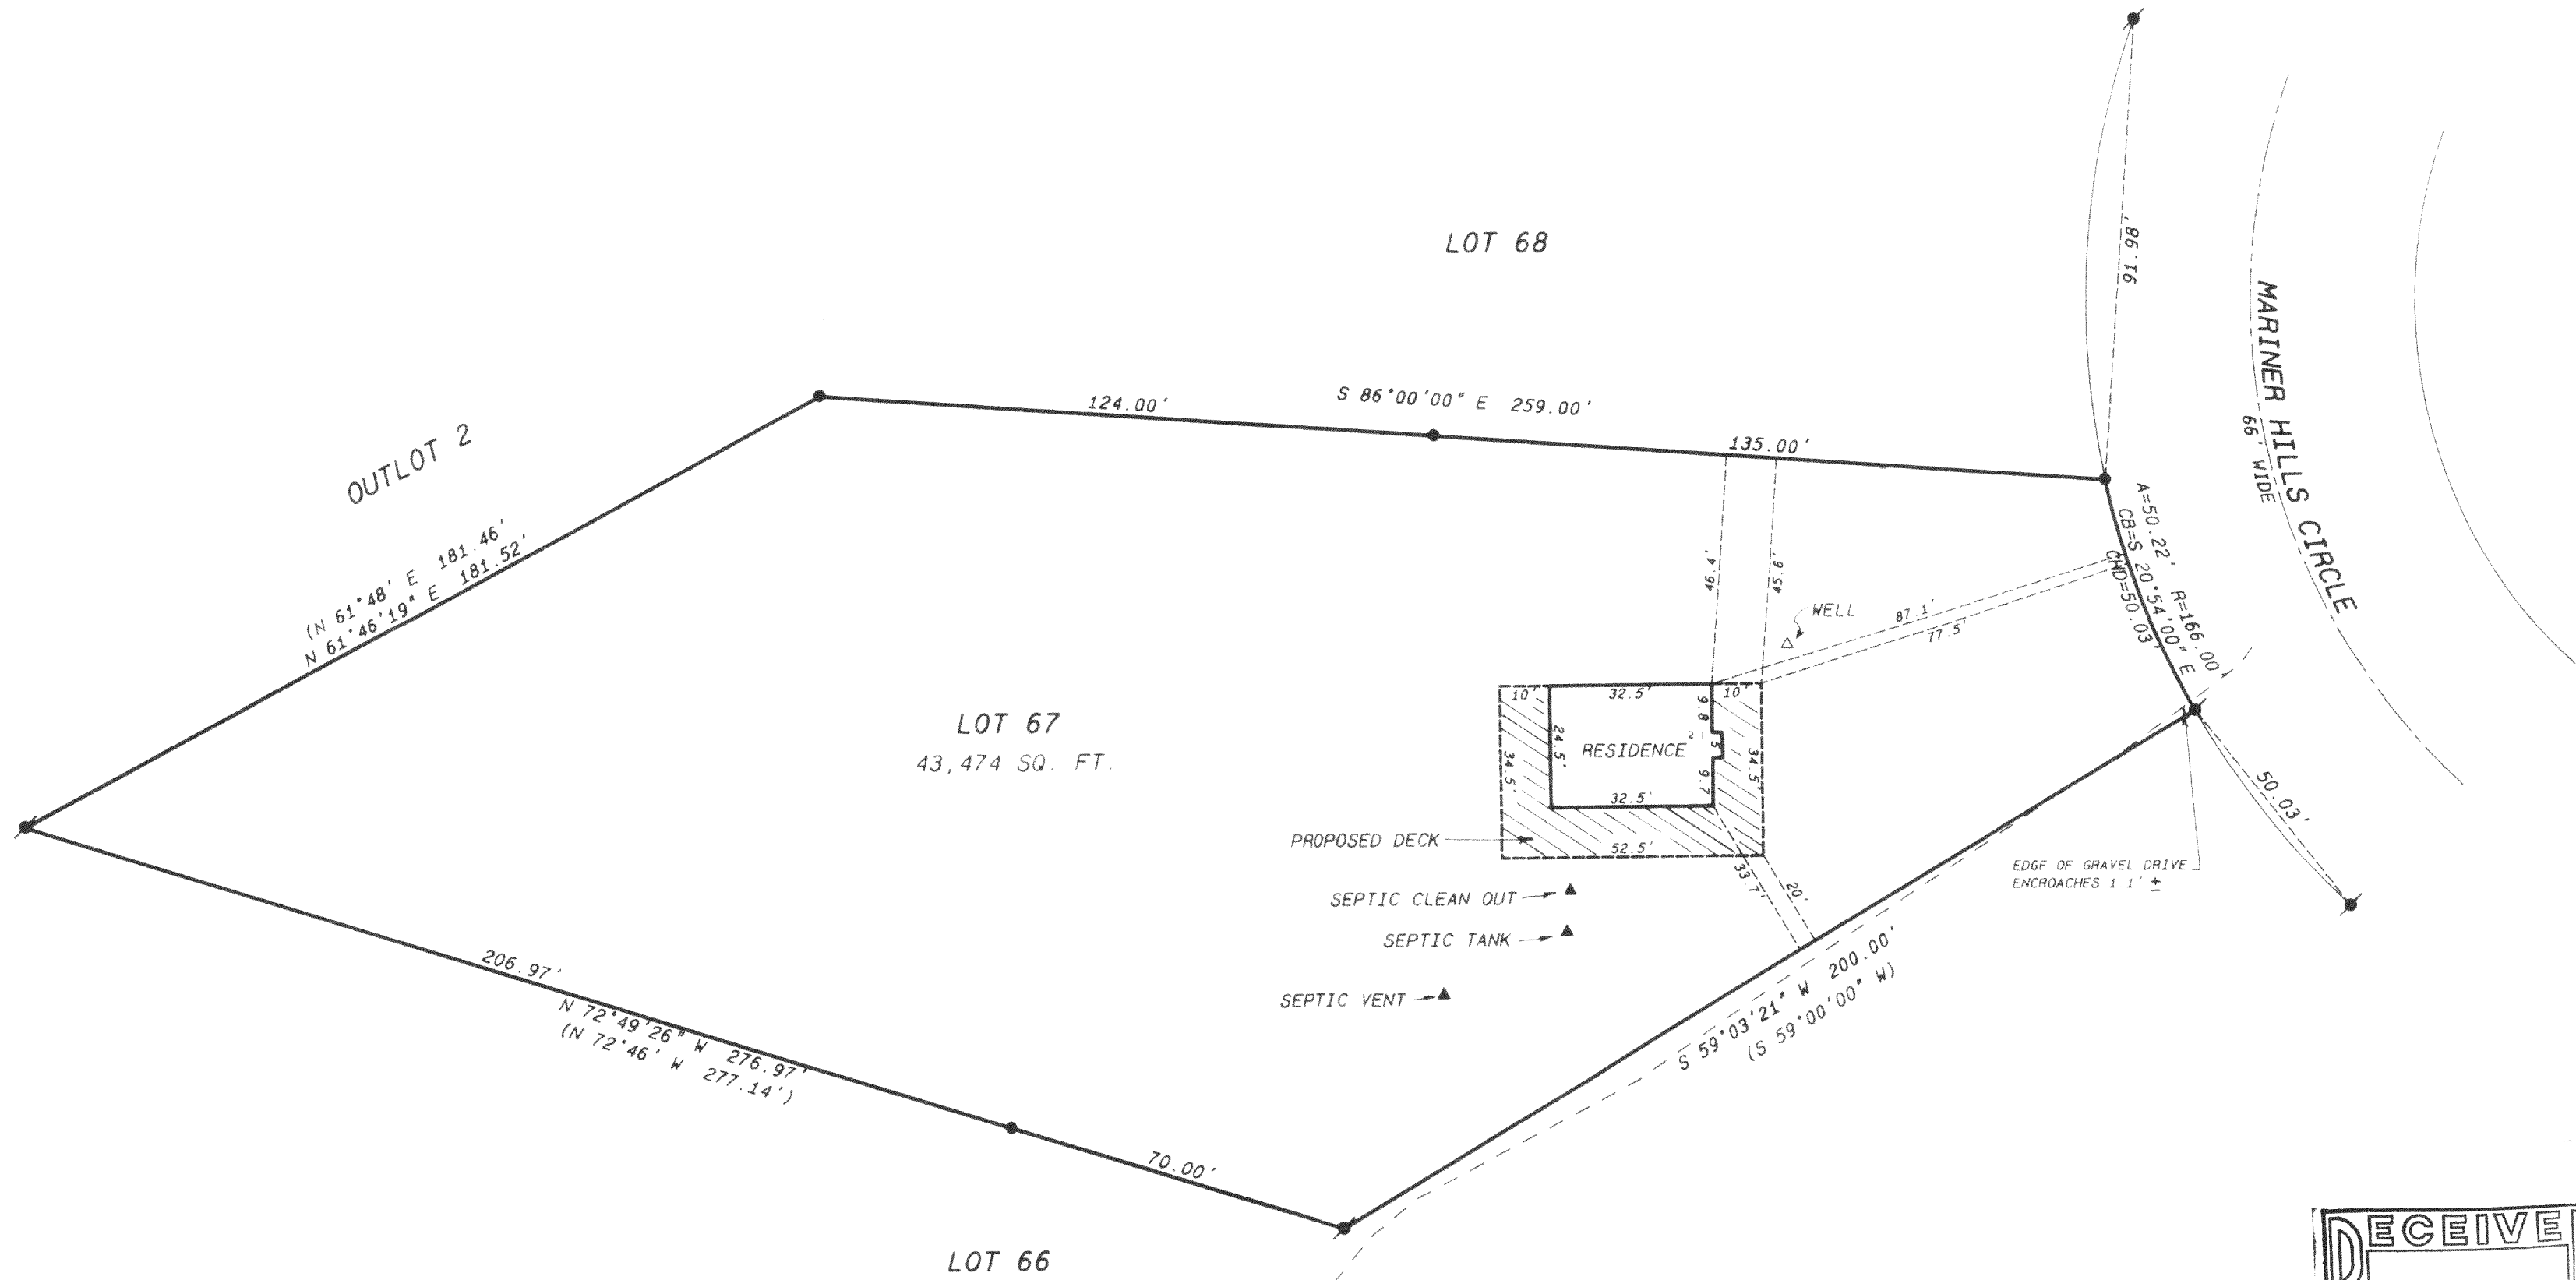


PLAT OF SURVEY

LOT 67 OF MARINER HILLS SUBDIVISION,
LOCATED IN SECTION 34, TOWN 4 NORTH,
RANGE 16 EAST, LAGRANGE TOWNSHIP,
WALWORTH COUNTY, WISCONSIN.

OWNERS: RONALD & VICTORIA CALIENDO
7645 WEST RASCHER AVE.
CHICAGO, IL. 60656

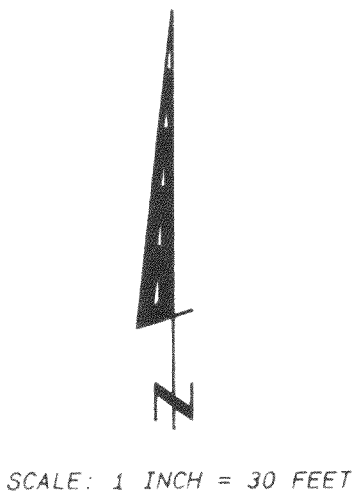

SCALE: 1"= 30 FEET



I hereby certify that the above described property has been surveyed by me or under my direction and that the above map is a true representation thereof and shows the size and location of the property, its exterior boundaries, the location of all visible structures and dimensions of all principal buildings thereon, boundary fences, apparent easements, roadways and visible encroachments, if any.

This survey is made for the use of the present owners of the property and also those who purchase, mortgage, or guarantee the title thereto within one year from date hereof.

Kenneth B. Abernathy, Jr.
WISCONSIN REGISTERED LAND SURVEYOR,
S-1594

Date: JUNE 13, 2000 Job No. 00.601