

Plat of Survey

of


Lands described in a Personal Representative's Deed recorded in Vol. 668 on Page 6173 as Document No. 433958 as shown below:

1. A part of Block Four (4) of CARSWELLS PARK SUBDIVISION, being a part of Sections Thirty-five (35) and Thirty-six (36), in Township Four (4) North, Range Sixteen (16) East, in the Town of LaGrange, County of Walworth, State of Wisconsin, Commencing at an iron stake, said being located 37 feet South from the Southeast corner of Lot 1 Block 2 of Carswells Park as plotted and recorded at Elkhorn, Wisconsin. Thence Southerly 130 feet to an iron stake thence Westerly 100 feet to an iron stake thence Northerly 130 feet to an iron stake, thence Easterly 100 feet to the place of beginning. Together with access to the lake between the Northeast corner of Lot 1 Block 2 of said Carswells Park and the North stone post of the bridge that lies East of said lot. All being a portion of Section 35 North, 4 Range, 16 East. Including dwelling lying on above parcel of land, complete with furnishings.



2. A part of Block Four (4) of CARSWELLS PARK SUBDIVISION, which subdivision is located in Sections Thirty-five (35) and Thirty-six (36) of Township Four (4) North, Range Sixteen (16) East, in the Town of LaGrange, County of Walworth, State of Wisconsin, described as follows: to wit: Commencing at the Southwest corner of Lot 6 of said Subdivision, thence South 73°25' East 106.60 feet to the place of beginning, thence North 75°44' East 109.2 feet along a drive; thence South 20°12' East 130.30 feet; thence South 78°50' West 63.30 feet to the edge of a drive; thence North 39°33' West 139.40 feet along said drive to the place of beginning.

Also a right-of-way to the lake between the Northeast corner of Lot 1, Block 2, Carswell's Park, and the North stone post of the bridge, which right-of-way is more particularly described as follows: Beginning at the Southeast corner of said Lot 1; thence North 23°23' East 110.1 feet; thence North 56°10' East 19.1 feet to the Northerly line of said bridge and the shore of Middle Lake; thence Northwesterly along the shore 117 feet, more or less, to the Northeast corner of said Lot 1; thence South 15°56' East along the Easterly line of said Lot 1, 184 feet, more or less, to the place of beginning.

Surveyed for: **Whyte Hirschboeck Dudek S.C.**
111 East Wisconsin Avenue
Suite 2100
Milwaukee, Wisconsin 53202-4894

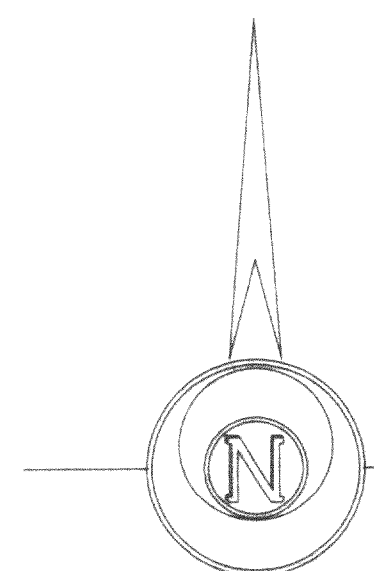

Bearings are referenced to previous surveys of record.

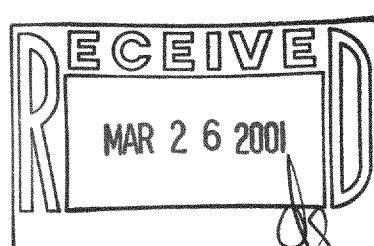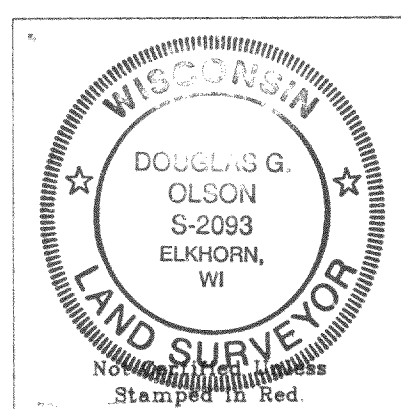

Notes: 1) This survey plat is not certified unless signed and sealed in red ink.
2) This survey is subject to Wisconsin lien laws. This Plat of Survey is the notice of intent to file lien. Lien waiver required.


Copyright © 2000 by Jensen & Olson Land Surveying, LLC.

All rights reserved. No part of this survey plat may be reproduced or transmitted in any form by any means - graphic, electronic, or mechanical, including photocopying, tracing, or information storage and retrieval systems - without permission in writing from Douglas G. Olson, Jensen & Olson Land Surveying, LLC.

I, Douglas G. Olson, Wisconsin Registered Land Surveyor, do hereby certify that this survey was performed by me or under my direction in full compliance with the owner's/agent's instructions and Chapter A-E 7 of the Wisconsin Administrative Code "Minimum Standards for Property Surveys", and that this map is an accurate representation thereof to the best of my knowledge and belief.


Douglas G. Olson
Wisconsin Registered Land Surveyor - 2093

HCA-51 416-163

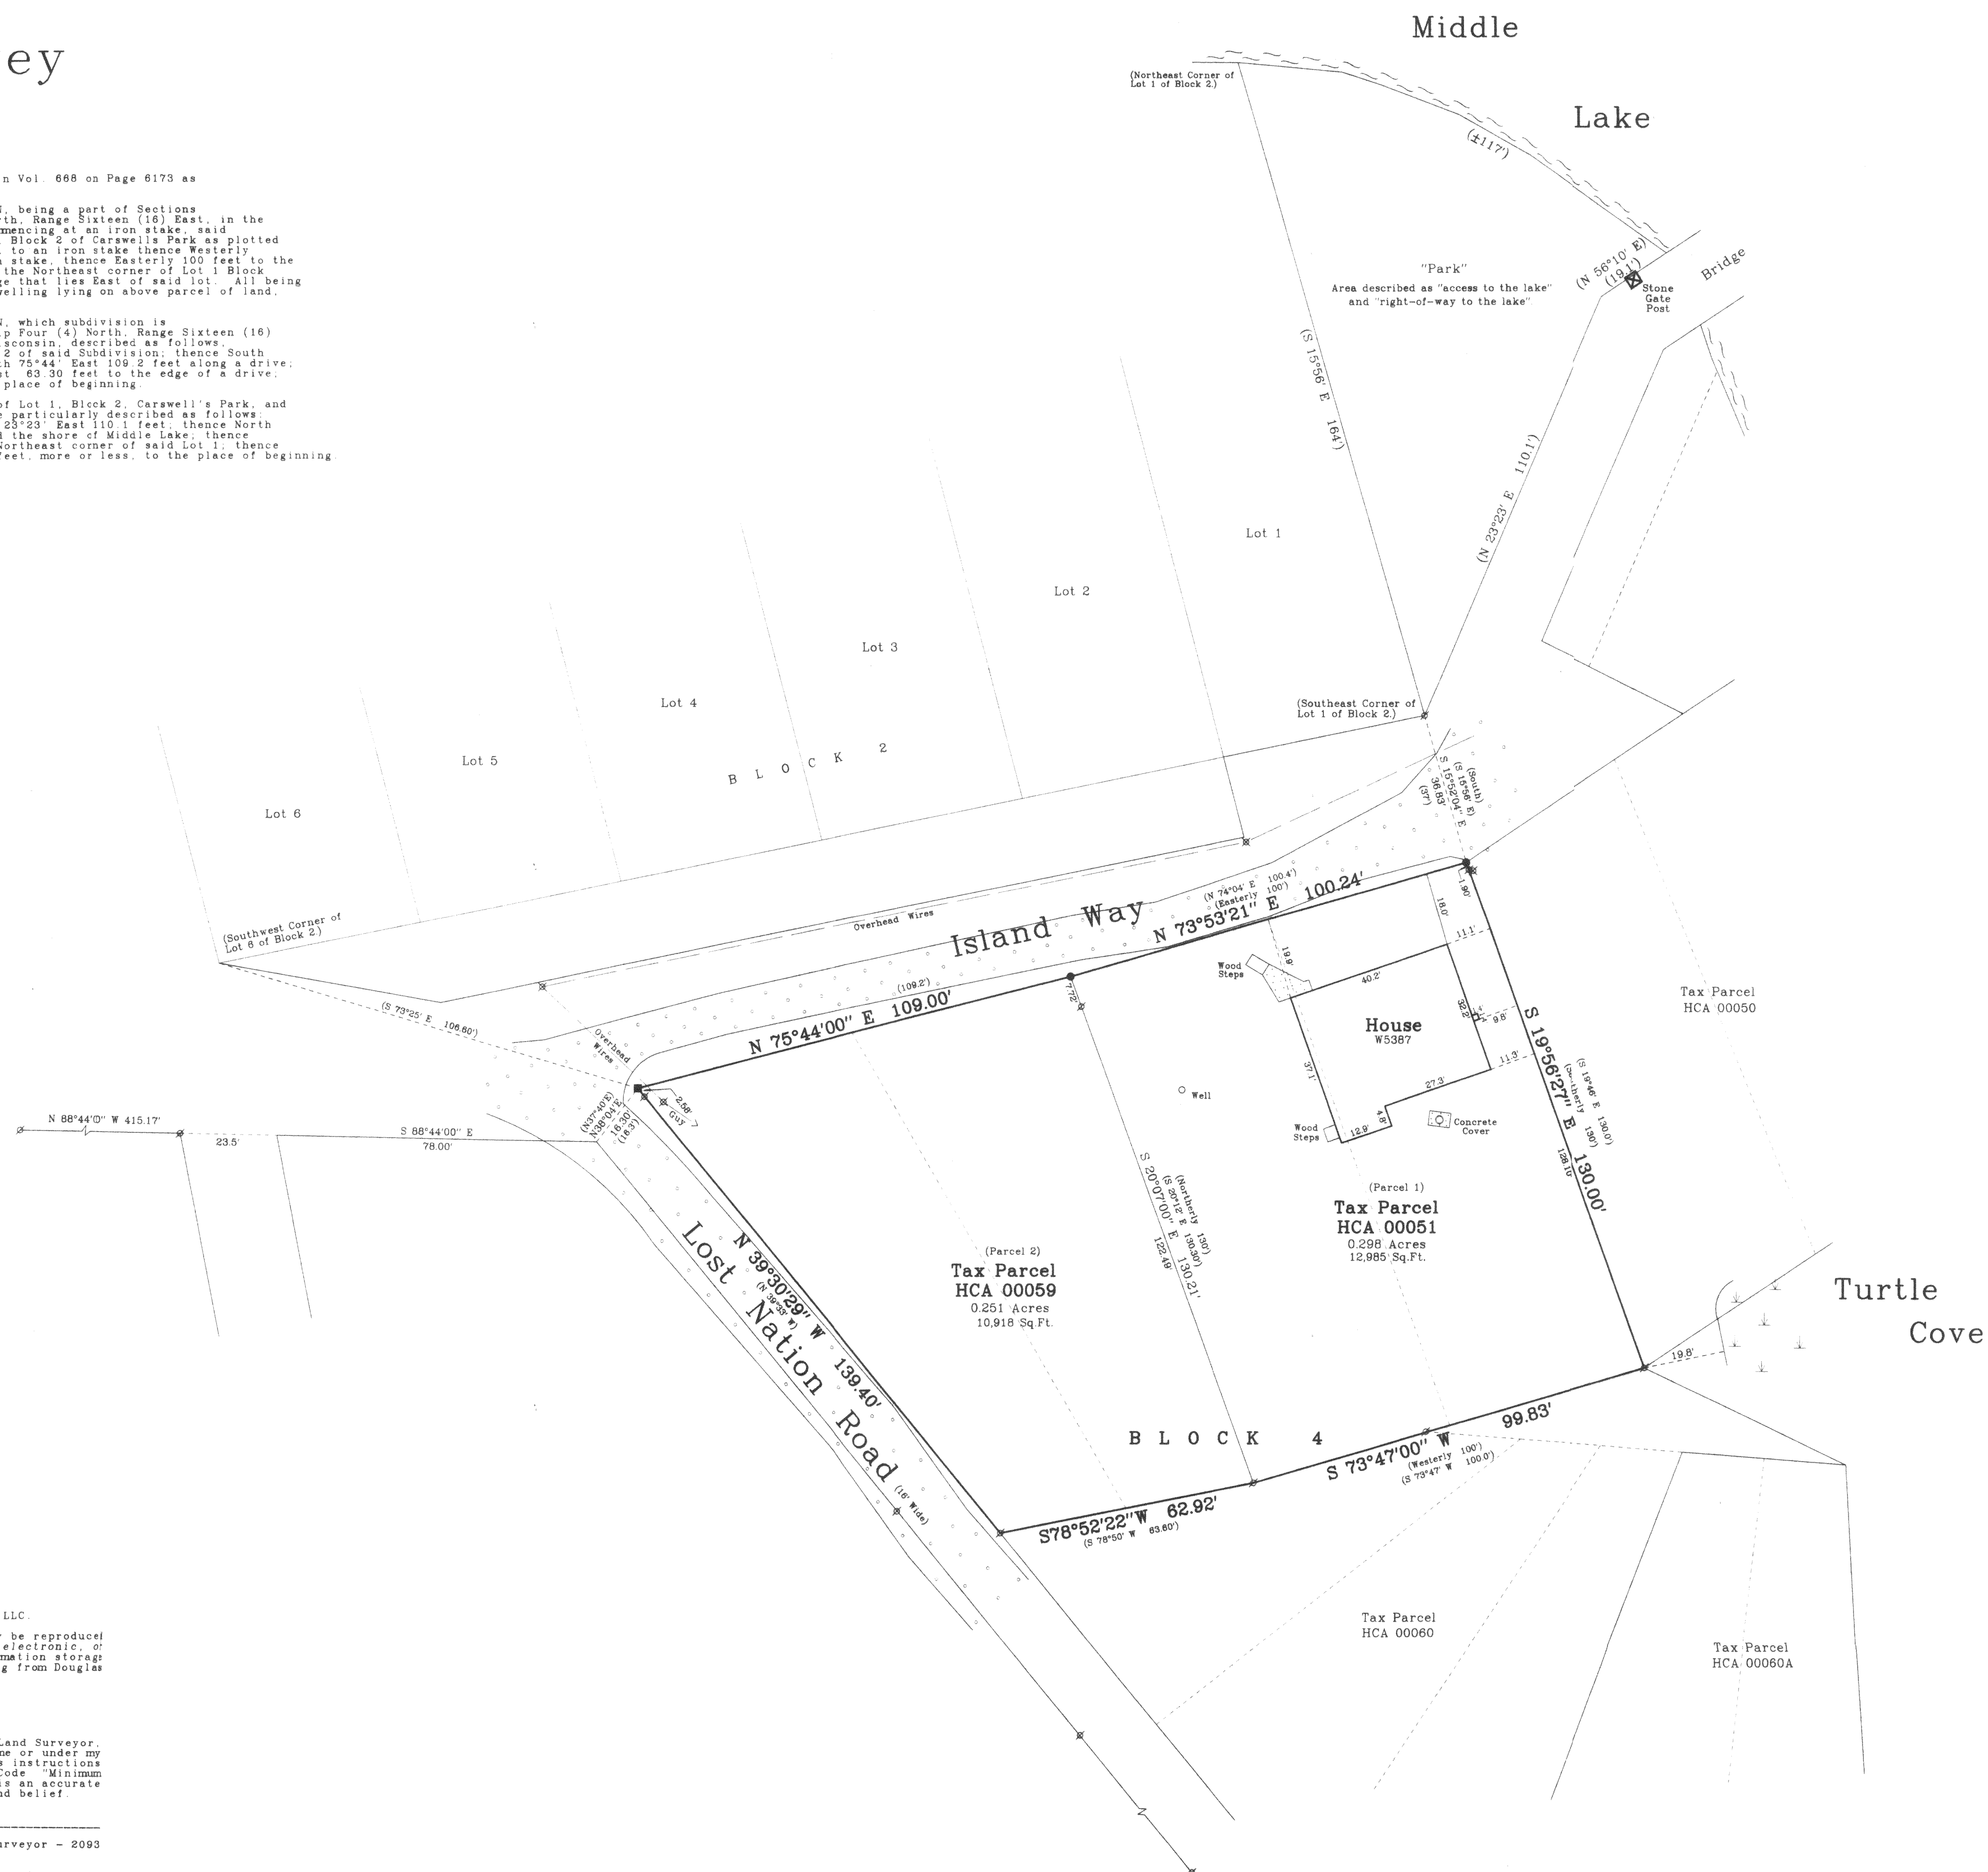

Survey date: September 8, 2000.
Revisions:

Scale in Feet
1" = 20'

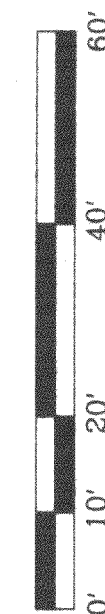

Jensen & Olson Land Surveying, LLC
45 South Wisconsin Street
P.O. Box 322
Elkhorn, Wisconsin 53121
Telephone: (262) 723-3434
Facsimile: (262) 723-8044

Legend

Round Iron Pipe 1/2" dia.
Set Iron Rod 3/4" dia.
Reinforced Information
Concrete Surface
Asphalt Surface

Sheet 1 of 1 Sheets.

Job Reference Number

2000.107

2000.107