

PLAT OF SURVEY


LOT 14, THE WOODLANDS OF KETTLE MORaine, BEING A PART OF THE SOUTHEAST 1/4 OF THE SOUTHWEST 1/4 OF SECTION 2, THE NORTHEAST 1/4 OF THE NORTHWEST 1/4 OF SECTION 11, THE NORTHWEST 1/4 OF THE NORTHEAST 1/4 OF SECTION 11, THE SOUTHWEST 1/4 OF THE NORTHEAST 1/4 OF SECTION 11, AND THE SOUTHWEST 1/4 OF THE NORTHWEST 1/4 OF SECTION 11, ALL IN TOWN 4 NORTH, RANGE 16 EAST, TOWN OF LAGRANGE, WALWORTH COUNTY, WISCONSIN.

SURVEYED FOR: SCHUBRING BUILDERS

SCALE 1"=60'


NOTE: MONUMENTATION WAS WAIVED BY CLIENT IN ACCORDANCE WITH A-E 7.01(2) OF THE WISCONSIN ADMINISTRATIVE CODE

WOODLANDS LANE

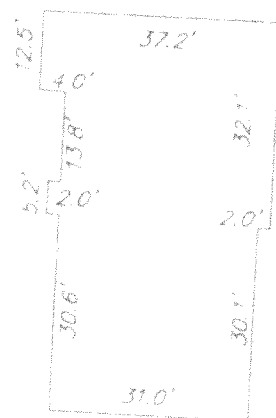


EXISTING DWELLING (UNDER CONSTRUCTION)

HOUSE DETAIL 1"=30'

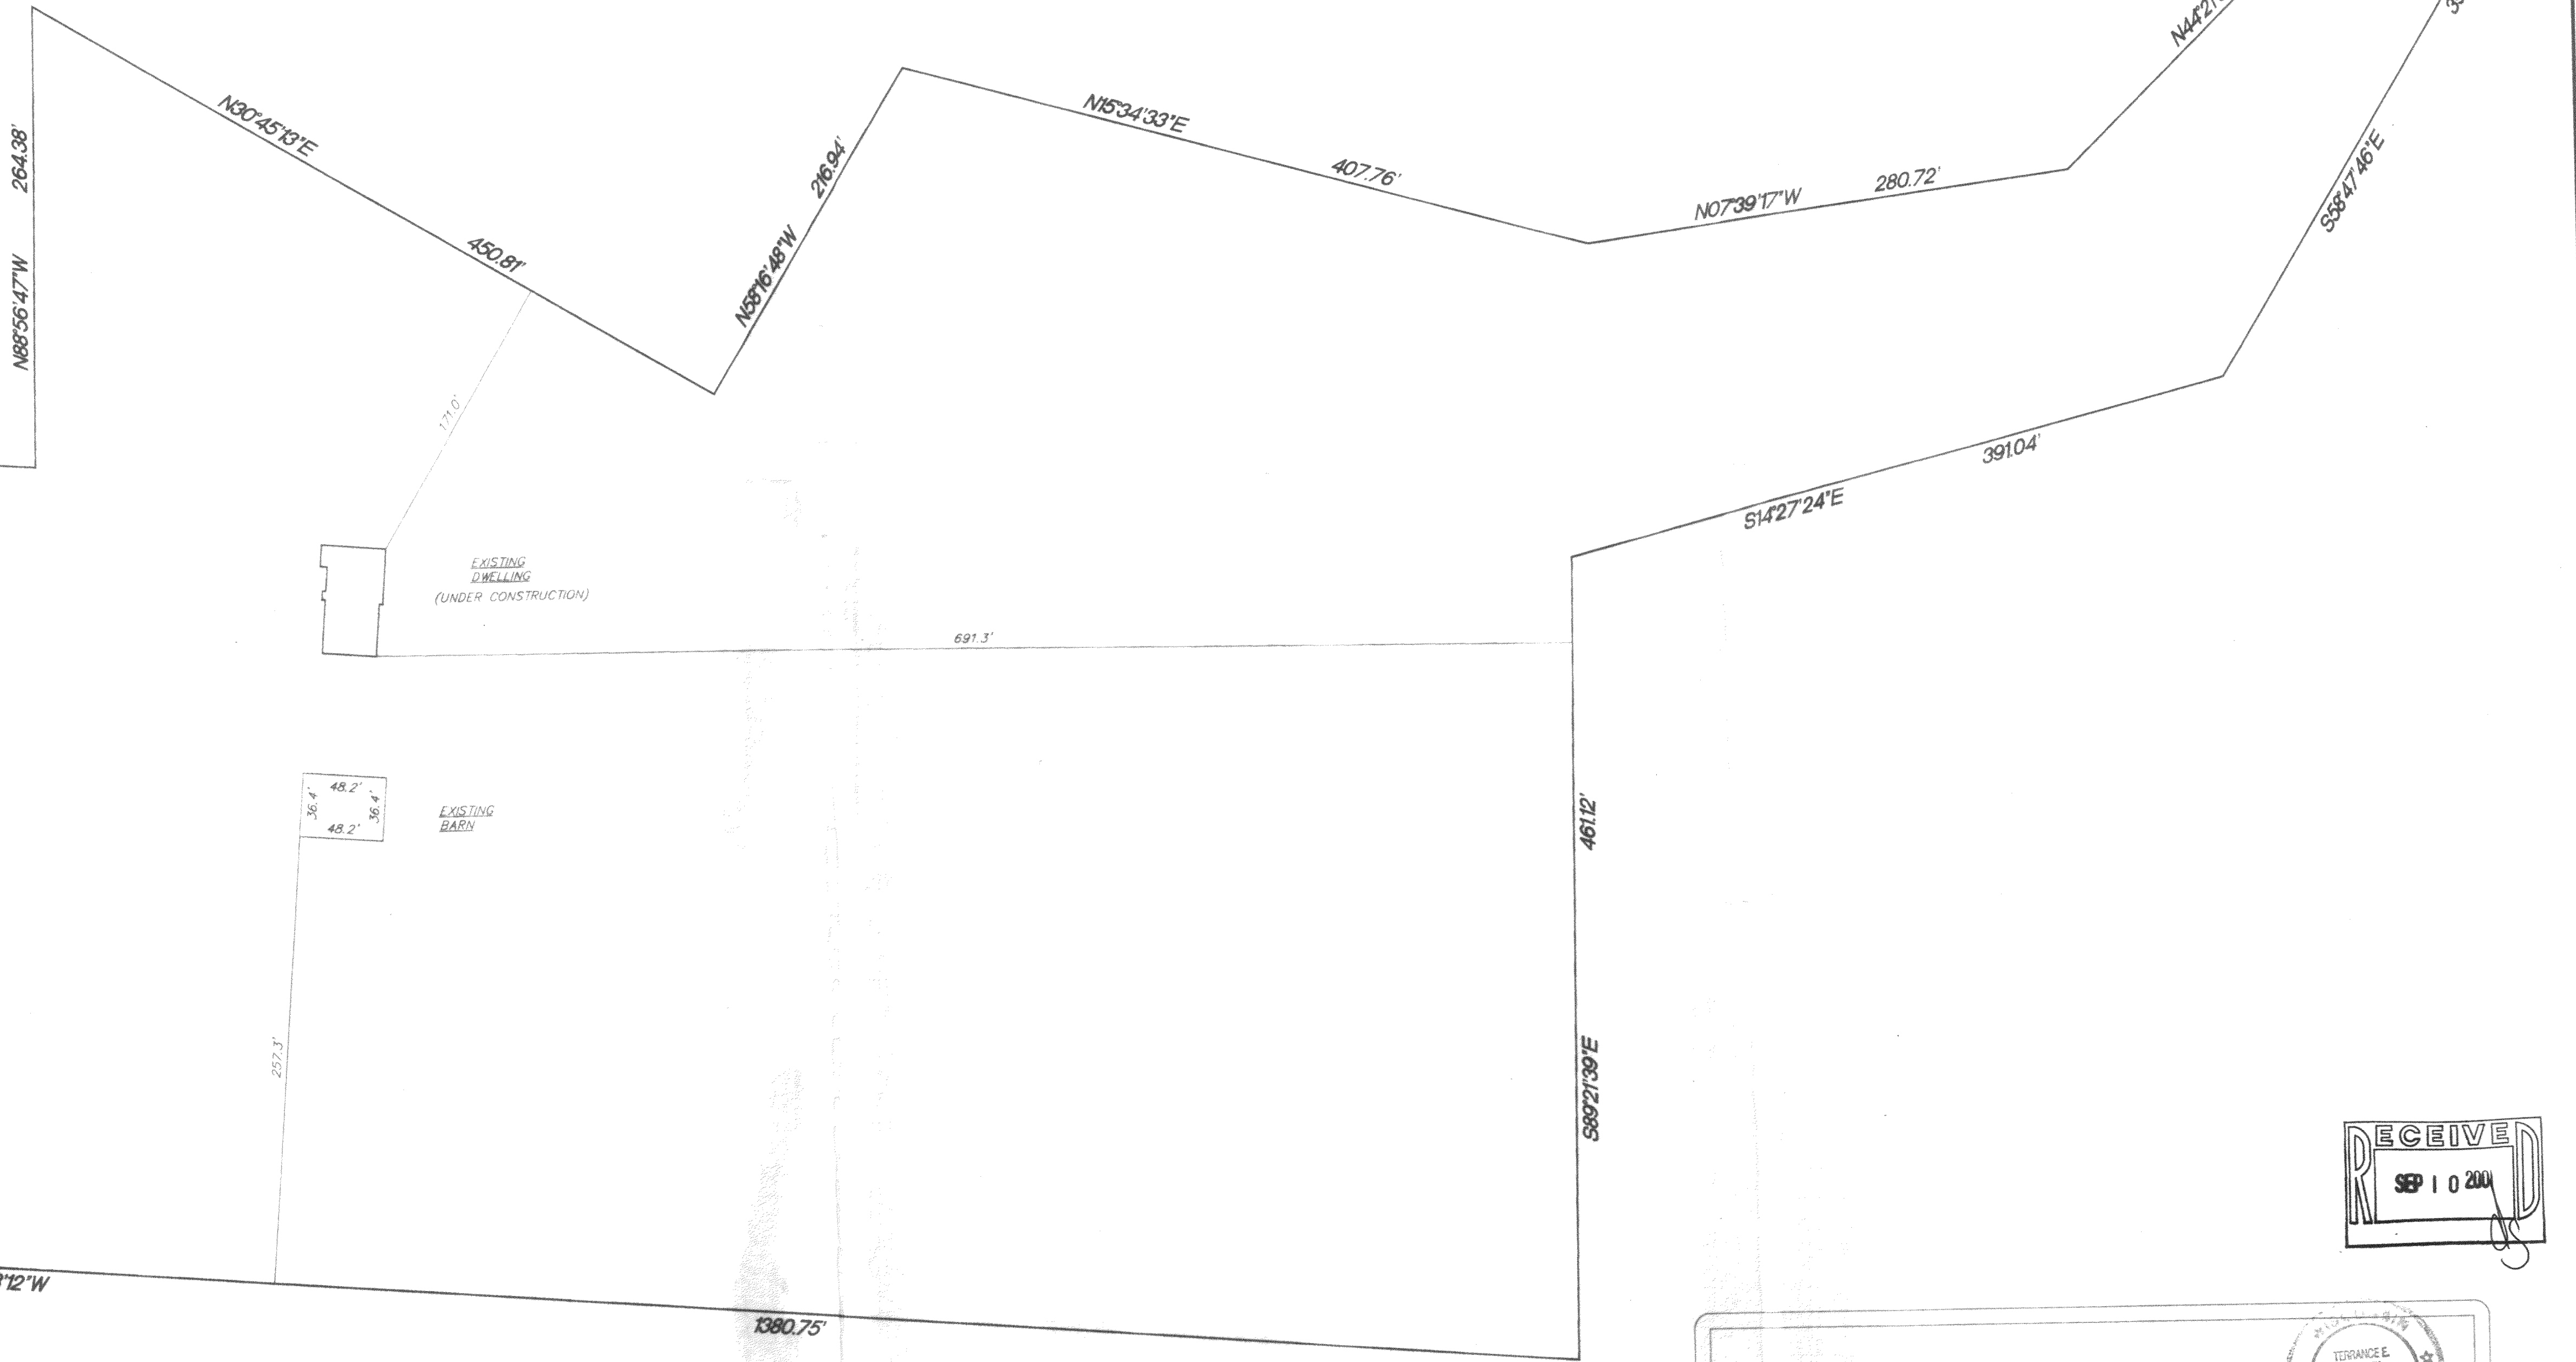

RADIUS	LENGTH	CHORD	BEARING	DELTA
100.00'	50.54'	50.00'	N60°54'24"E	28°57'12"

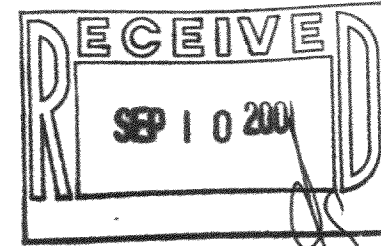

I hereby certify that I have surveyed the above property and that the above map is a true representation thereof and shows the size and location of the property, exterior boundaries, the location of all visible structures and dimensions of all principal buildings thereon, boundary lines, apparent easements, roadways and encroachments if any.

This survey is made for the use of the present owners of the property, and also those who purchase mortgage or guarantee the title thereto within one year from date hereof.

THIS IS NOT AN ORIGINAL SURVEY UNLESS THE SEAL IS RED.

REV. 4/15/01
3/22/01
DATE

TEP/RT
FIELD WORK BY

TEP
DRAWN BY

01034
JOB NUMBER

Kettle Moraine Surveying
14358 S9050 Godfrey Lane
P.O. Box 357
Eagle WI 53119
(414)264-9484

VERANCE E. FISAREK
S-1000
EAGLE
WISCONSIN
LAND SURVEYOR

416-1718 Hwa-14