


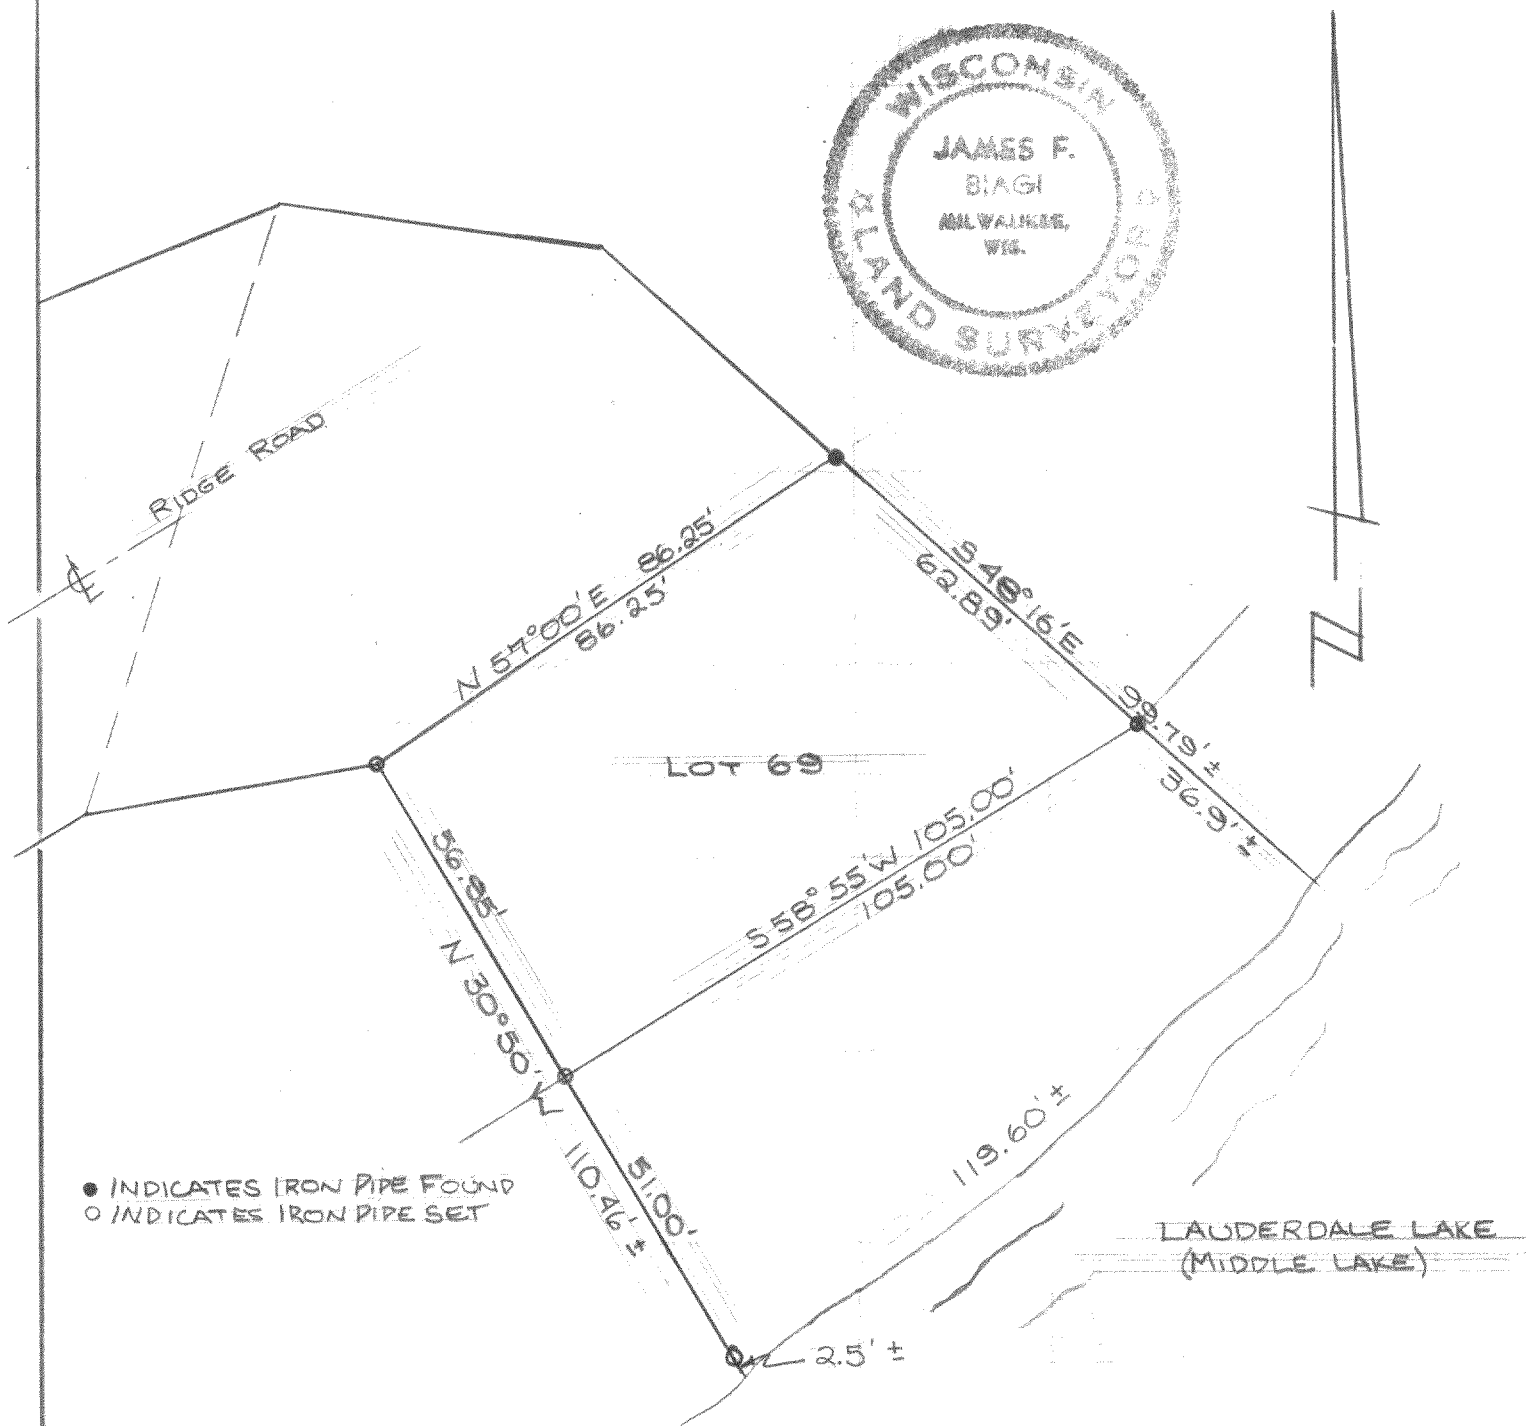

DESCRIPTION:

Lot 69 Bubbling Springs Subdivision of a portion of the NW $\frac{1}{4}$ of the SW $\frac{1}{4}$ and a portion of the SW $\frac{1}{4}$ of the NW $\frac{1}{4}$ of Section 35, T4N, R16E, LaGrange Township, Walworth County, Wisconsin.



CERTIFICATE:

I, James F. Biagi, surveyor, do hereby certify that I have surveyed the property hereon described.

DATE:

June 16, 1971

James F. Biagi
James F. Biagi RLS 272
Elkhorn, Wisconsin

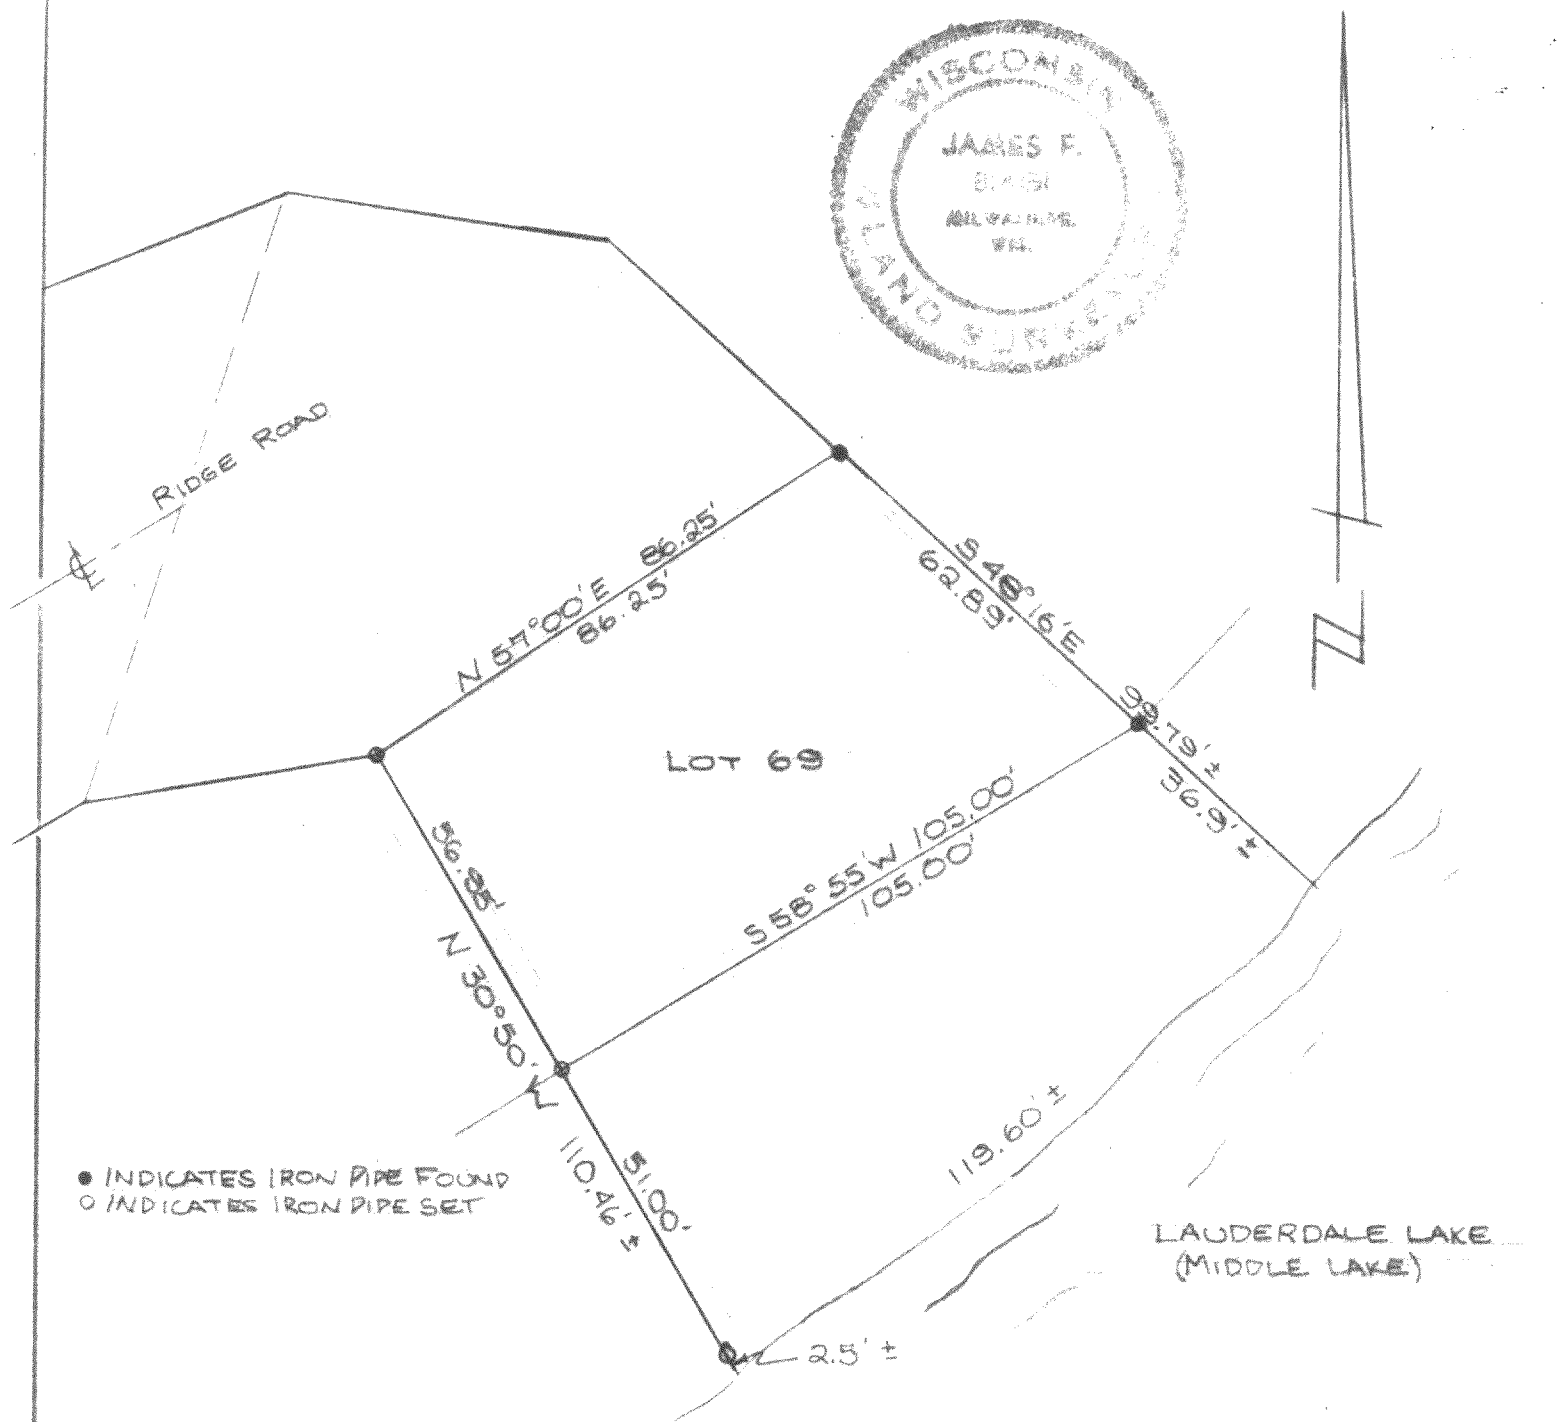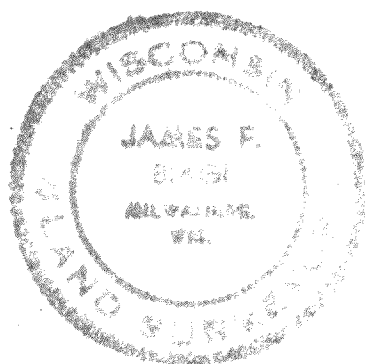

DESCRIPTION:

Lot 69 Bubbling Springs Subdivision of a portion of the NW $\frac{1}{4}$ of the SW $\frac{1}{4}$ and a portion of the SW $\frac{1}{4}$ of the NW $\frac{1}{4}$ of Section 35, T4N, R16E, LaGrange Township, Walworth County, Wisconsin.

CERTIFICATE:

I, James F. Biagi, surveyor, do hereby certify that I have surveyed the property hereon described.

DATE:

June 16, 1971

James F. Biagi RLS 272
Elkhorn, Wisconsin

2/7/104