

PLAT OF SURVEY

RSV
ENGINEERING, INC.

Engineers • Land Surveyors • Environmental Scientists
801 MAIN STREET MUKWONAGO, WISCONSIN 53149 (262)363-2004


FOR: STEVE FORRESTAL

DATE: 10/2/01

DESCRIPTION: LOT 31 AND AN UNDIVIDED ONE-HALF INTEREST IN THE SOUTH PART OF LOT 30 OF FROEDERT'S GREEN LAKE PARK SUBDIVISION, LOCATED IN SECTION 26, TOWN 4 NORTH, RANGE 16 EAST, WALWORTH COUNTY, WISCONSIN BEING MORE COMPLETELY DESCRIBED AS FOLLOWS: BEGINNING AT THE SW CORNER OF SAID LOT 31; THENCE WITH THE SOUTH LINE OF SAID LOT 31 S43°05'34"E, A DISTANCE OF 133.04' TO A POINT ON THE MEANDER LINE OF GREEN LAKE; THENCE WITH SAID MEANDER LINE N24°39'29"E, A DISTANCE OF 80.35' TO A POINT; THENCE N53°58'33"W, A DISTANCE OF 131.47' TO A POINT ON THE SOUTHERLY LINE OF ORIOLE DRIVE; THENCE WITH SAID SOUTHERLY LINE S18°22'06"W, A DISTANCE OF 56.18' TO THE POINT OF BEGINNING. SAID LOT 31 INCLUDES LANDS BETWEEN MEANDER LINE AND THE SHORE OF GREEN LAKE.

LEGEND

	1"x18" IRON PIPE SET
	FOUND 1" IRON PIPE
	STo SEPTIC TANK
	Wo WELL
	CONCRETE

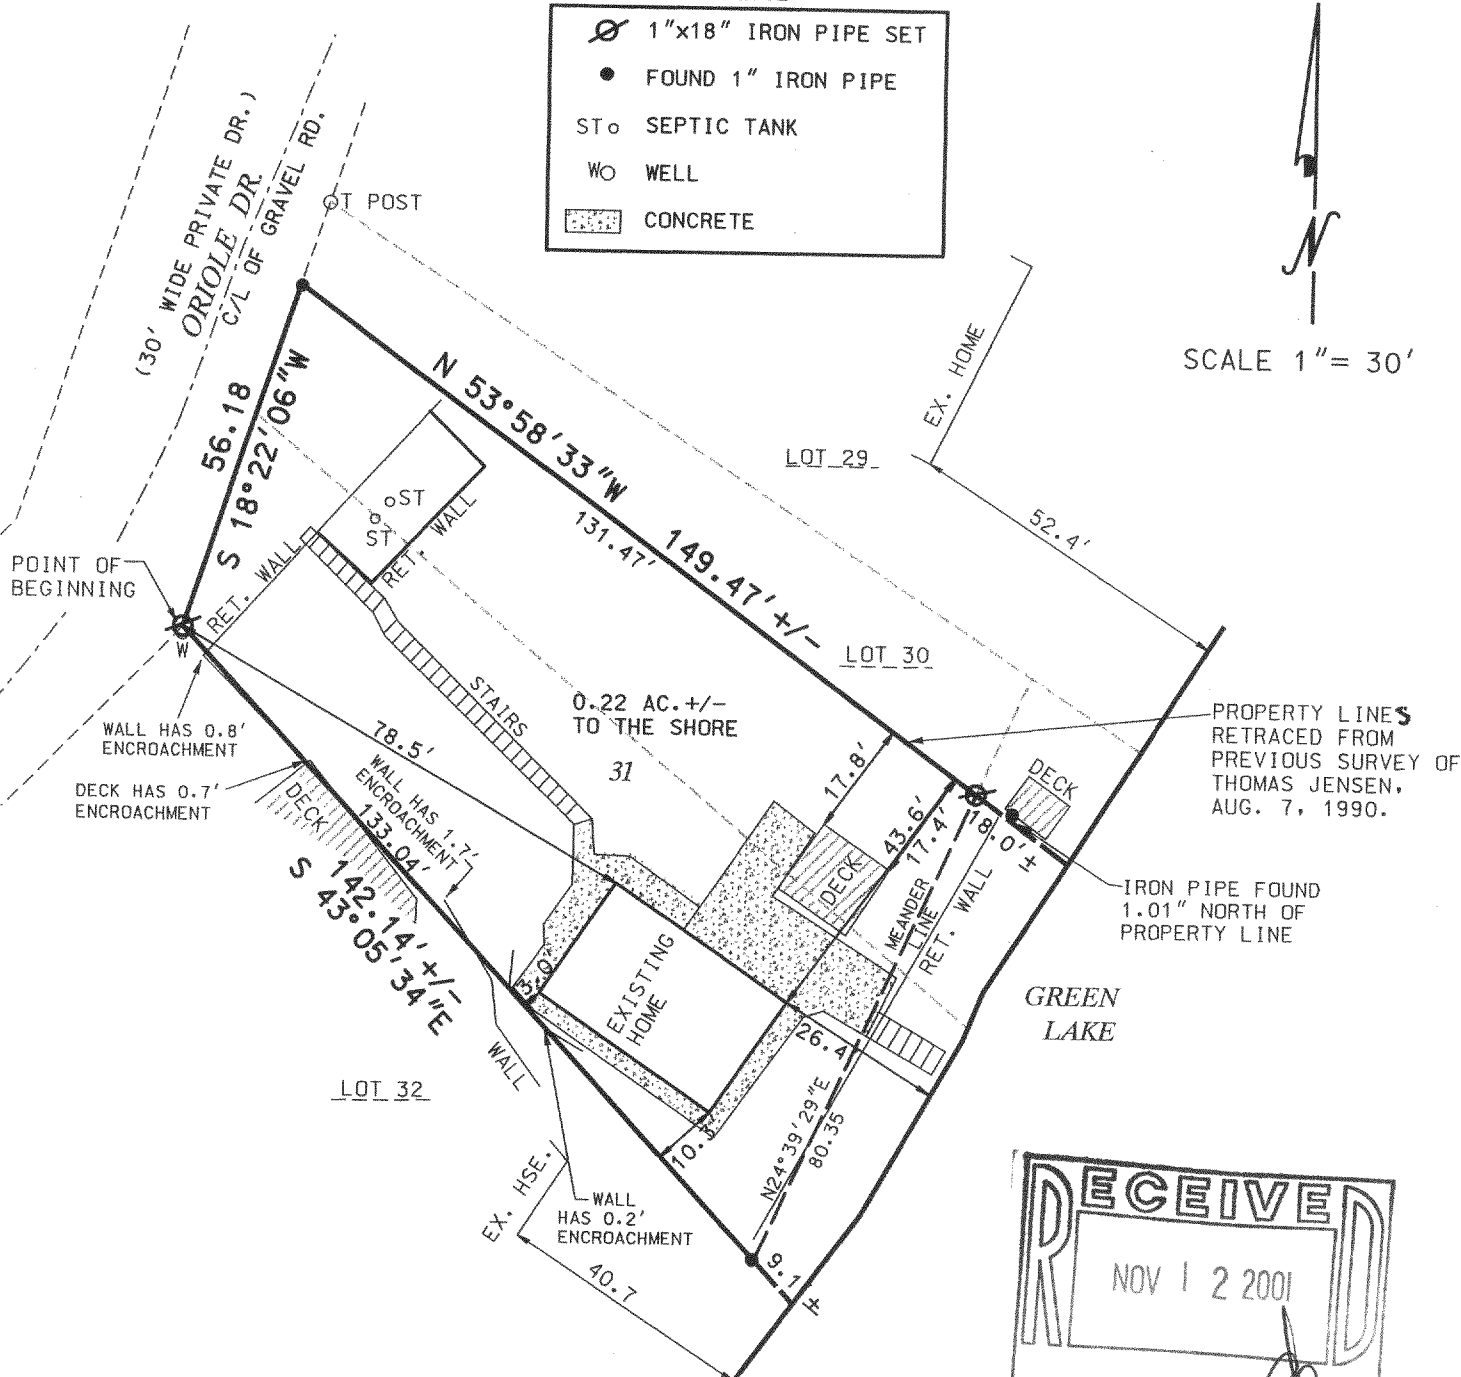


THE ABOVE MAP IS A TRUE REPRESENTATION THEREOF AND SHOWS THE SIZE AND LOCATION OF ALL THE PROPERTY, EXTERIOR BOUNDARIES, THE LOCATION OF ALL VISIBLE BOUNDARY FENCES, APPARENT EASEMENTS, ROADWAYS AND VISIBLE ENCROACHMENTS, IF ANY.

THIS SURVEY IS MADE FOR THE USE OF THE PRESENT OWNERS OF THE PROPERTY, AND ALSO THOSE WHO PURCHASE, MORTGAGE OR GUARANTEE TITLE THERETO WITHIN ONE (1) YEAR FROM DATE HERETO.

BRADFORD L. SPENCER, R.L.S. 2069
RSV#01256.DGN

THIS IS ORIGINAL
PRINT ONLY IF
SEAL IS IMPRINTED
IN RED

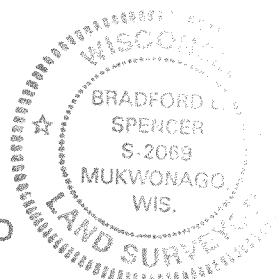

HFP-22

416-1736