
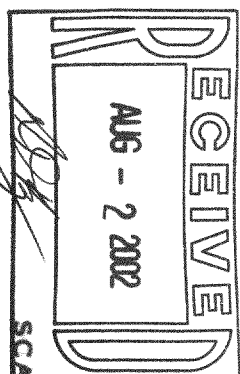


PLAT OF SURVEY

LOT 6 OF OAK PARK SUBDIVISION, LOCATED IN SECTION 26, TOWN 4 NORTH, RANGE 16 EAST, TOWN OF LaGRANGE, WALWORTH COUNTY, WISCONSIN.

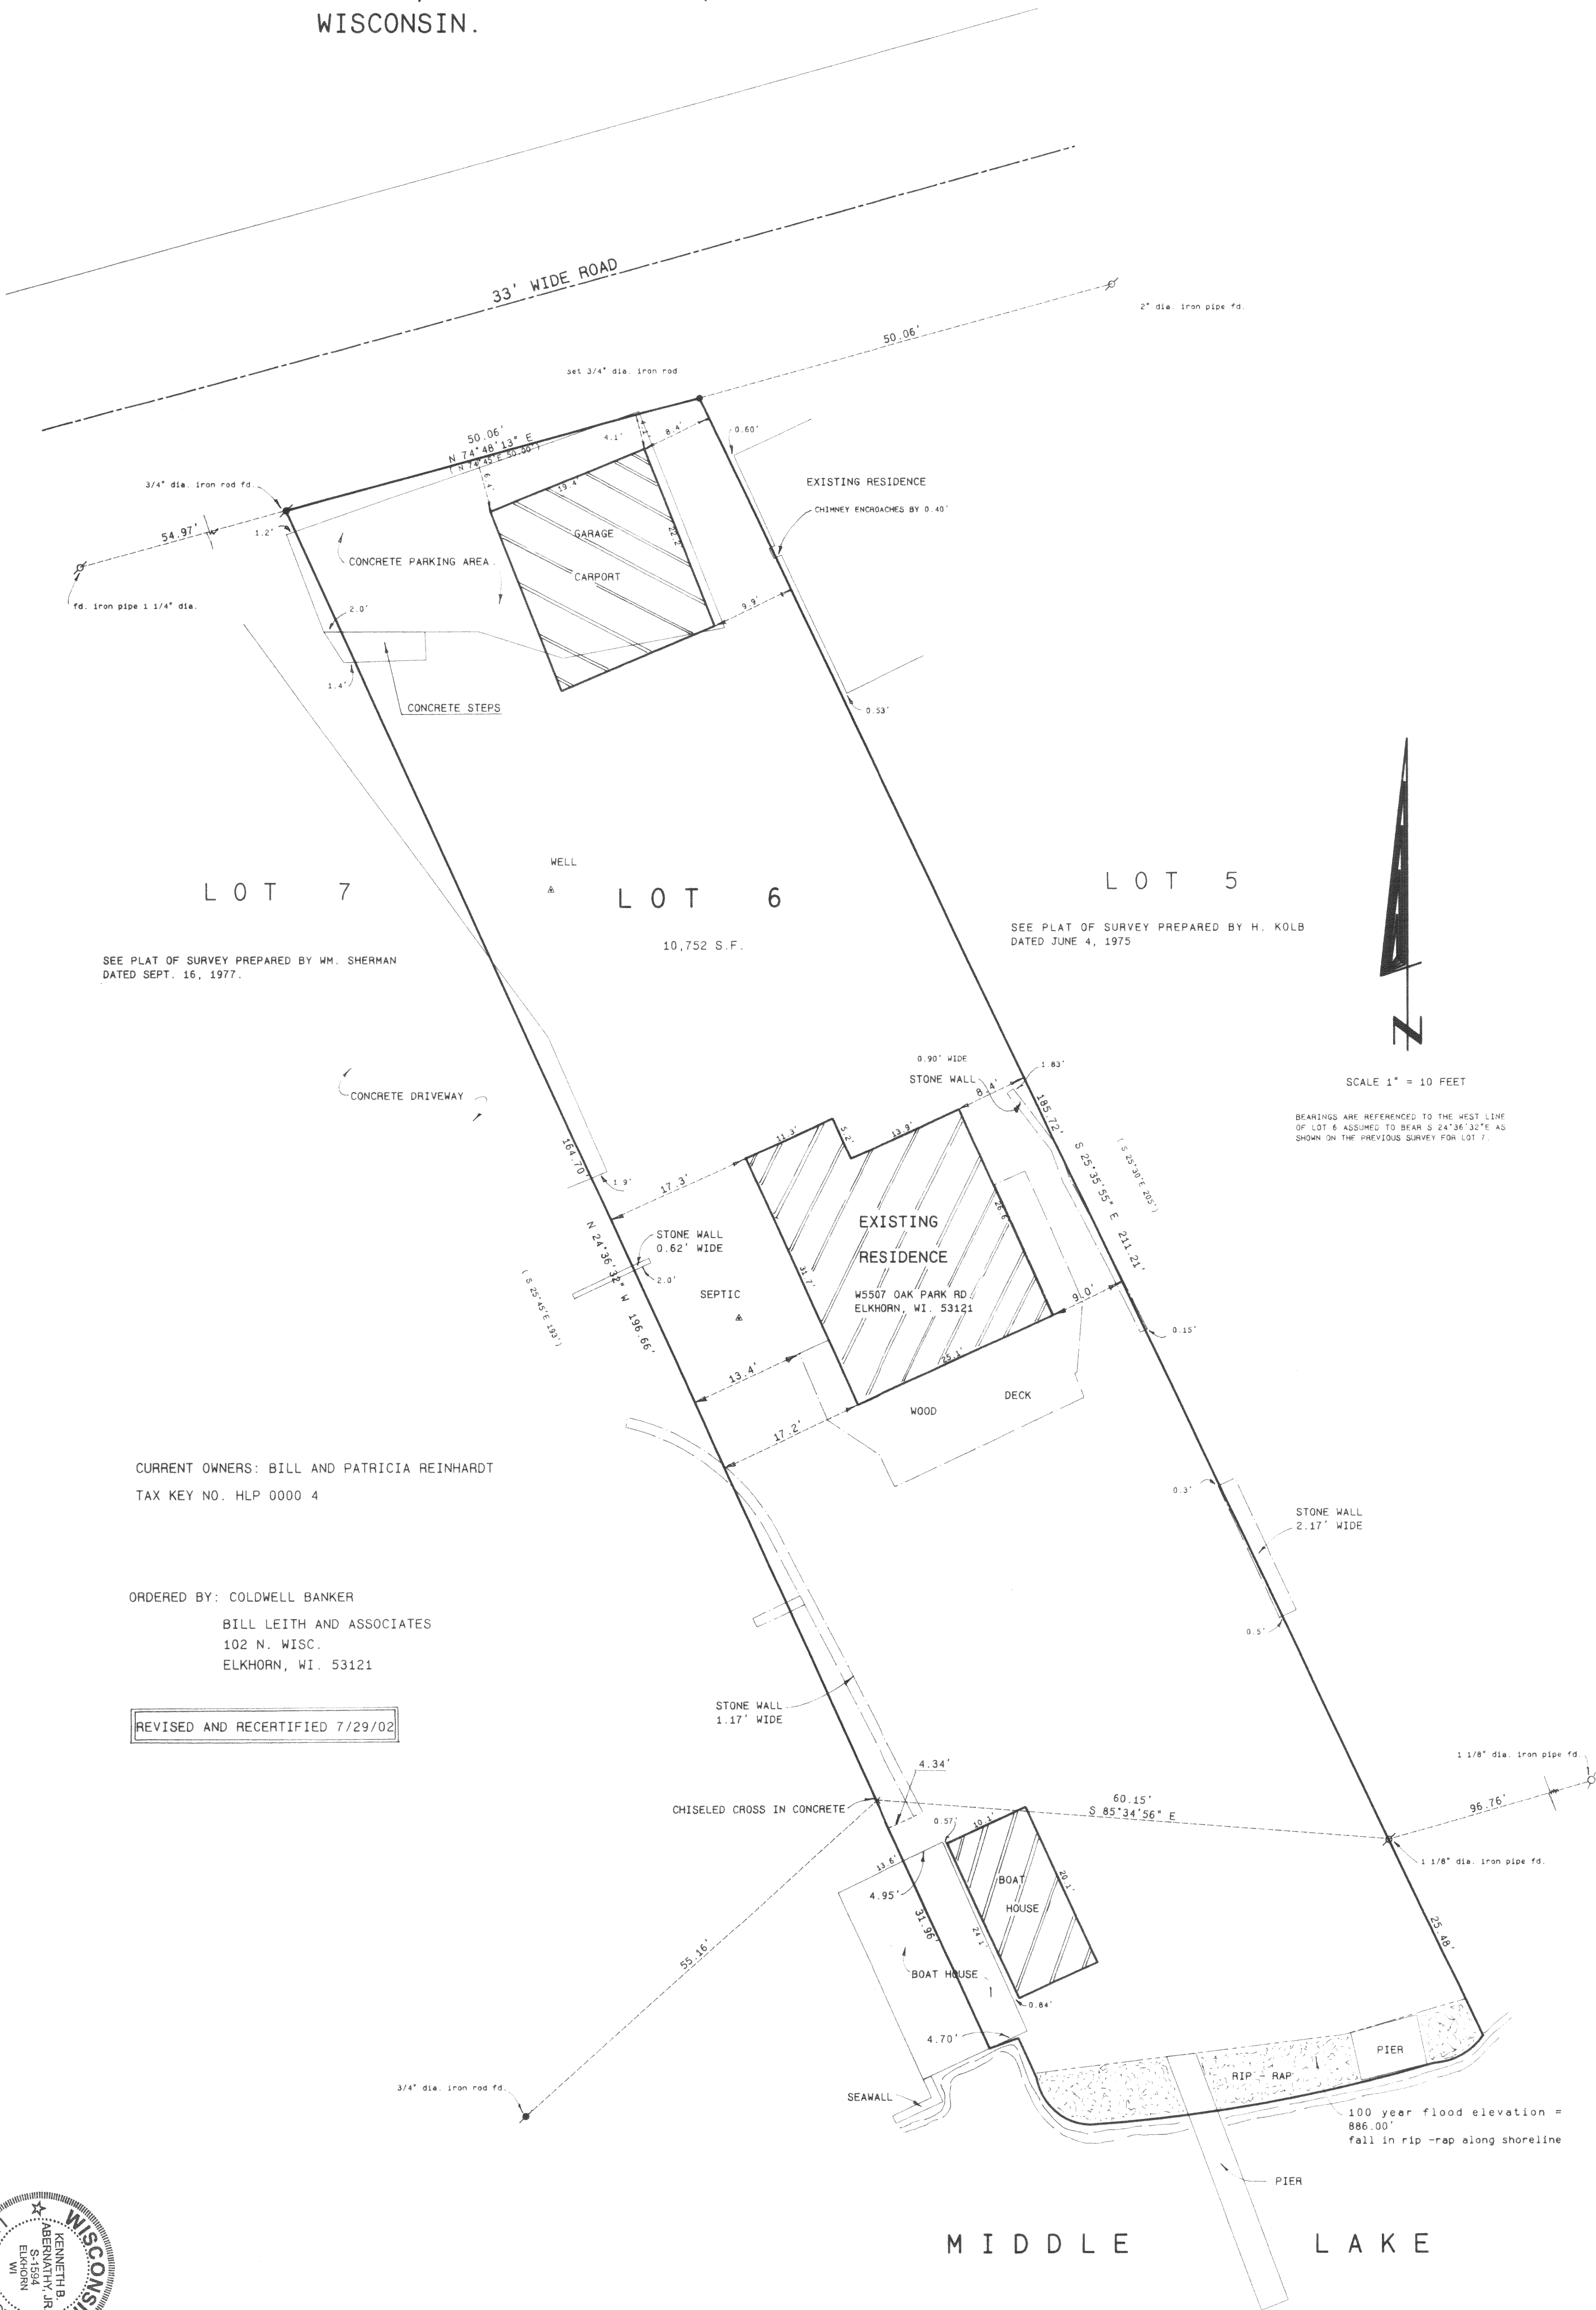

- Legend
- FOUND IRON PIPE
 - FOUND BRASS CAPED MONUMENT
 - FOUND CONCRETE MONUMENT
 - CHISEL CUT IN CONCRETE
 - SET IRON ROD, 24" LONG, MATCHING
 - SET IRON ROD, 30" LONG, WEIGHING 4.5 LBS. (LINEAL FT. - 11.11 LB. DIA. 1/2")
 - RECORDED AS DIMENSION
 - EXISTING FENCE

Kenneth B. Abernathy, Jr.
WISCONSIN REGISTERED LAND SURVEYOR, S-1594
Date: 8-25-97 Job No. 97.814

46-1785