


VHA3292-1

Property Exhibit

of
Lot 2 of Cetified Survey Map No. 3292,
recorded in Vol. 18 of Ctified Survey Maps of Walworth County on Page 235
and located in the Souteast 1/4 of the Southwest 1/4 of Section 5, Town 4 North,
Range 16 East, Town of sGrange, Walworth County, Wisconsin.

Prepared for: **Lindi Meisner**
N7543 tate Park Road, #A
Whitewater, Wisconsin. 53190

Site Address: **W8758 Bluff Road**
Whitewater, Wisconsin. 53190

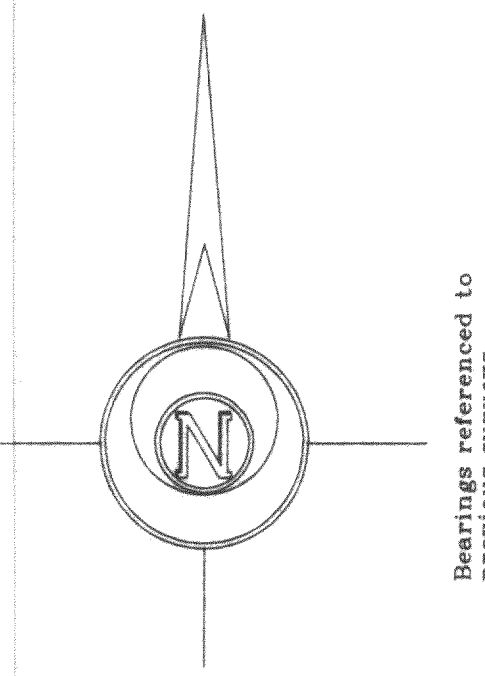


Jensen & Olson Land Surveying, LLC
45 South Wisconsin Street P.O. Box 322
Elkhorn, Wisconsin 53121
Telephone: (262) 723-3434
Facsimile: (262) 723-8044

- Legend**
- Found County Section Corner
 - Found Iron Pipe
 - Recorded Information
 - Soil Boring
 - Wood Lath or rod set by others

Sheet 1 of 1 Sheets.
Job Reference Number
2001.090

2001.090
2001090rev.S90

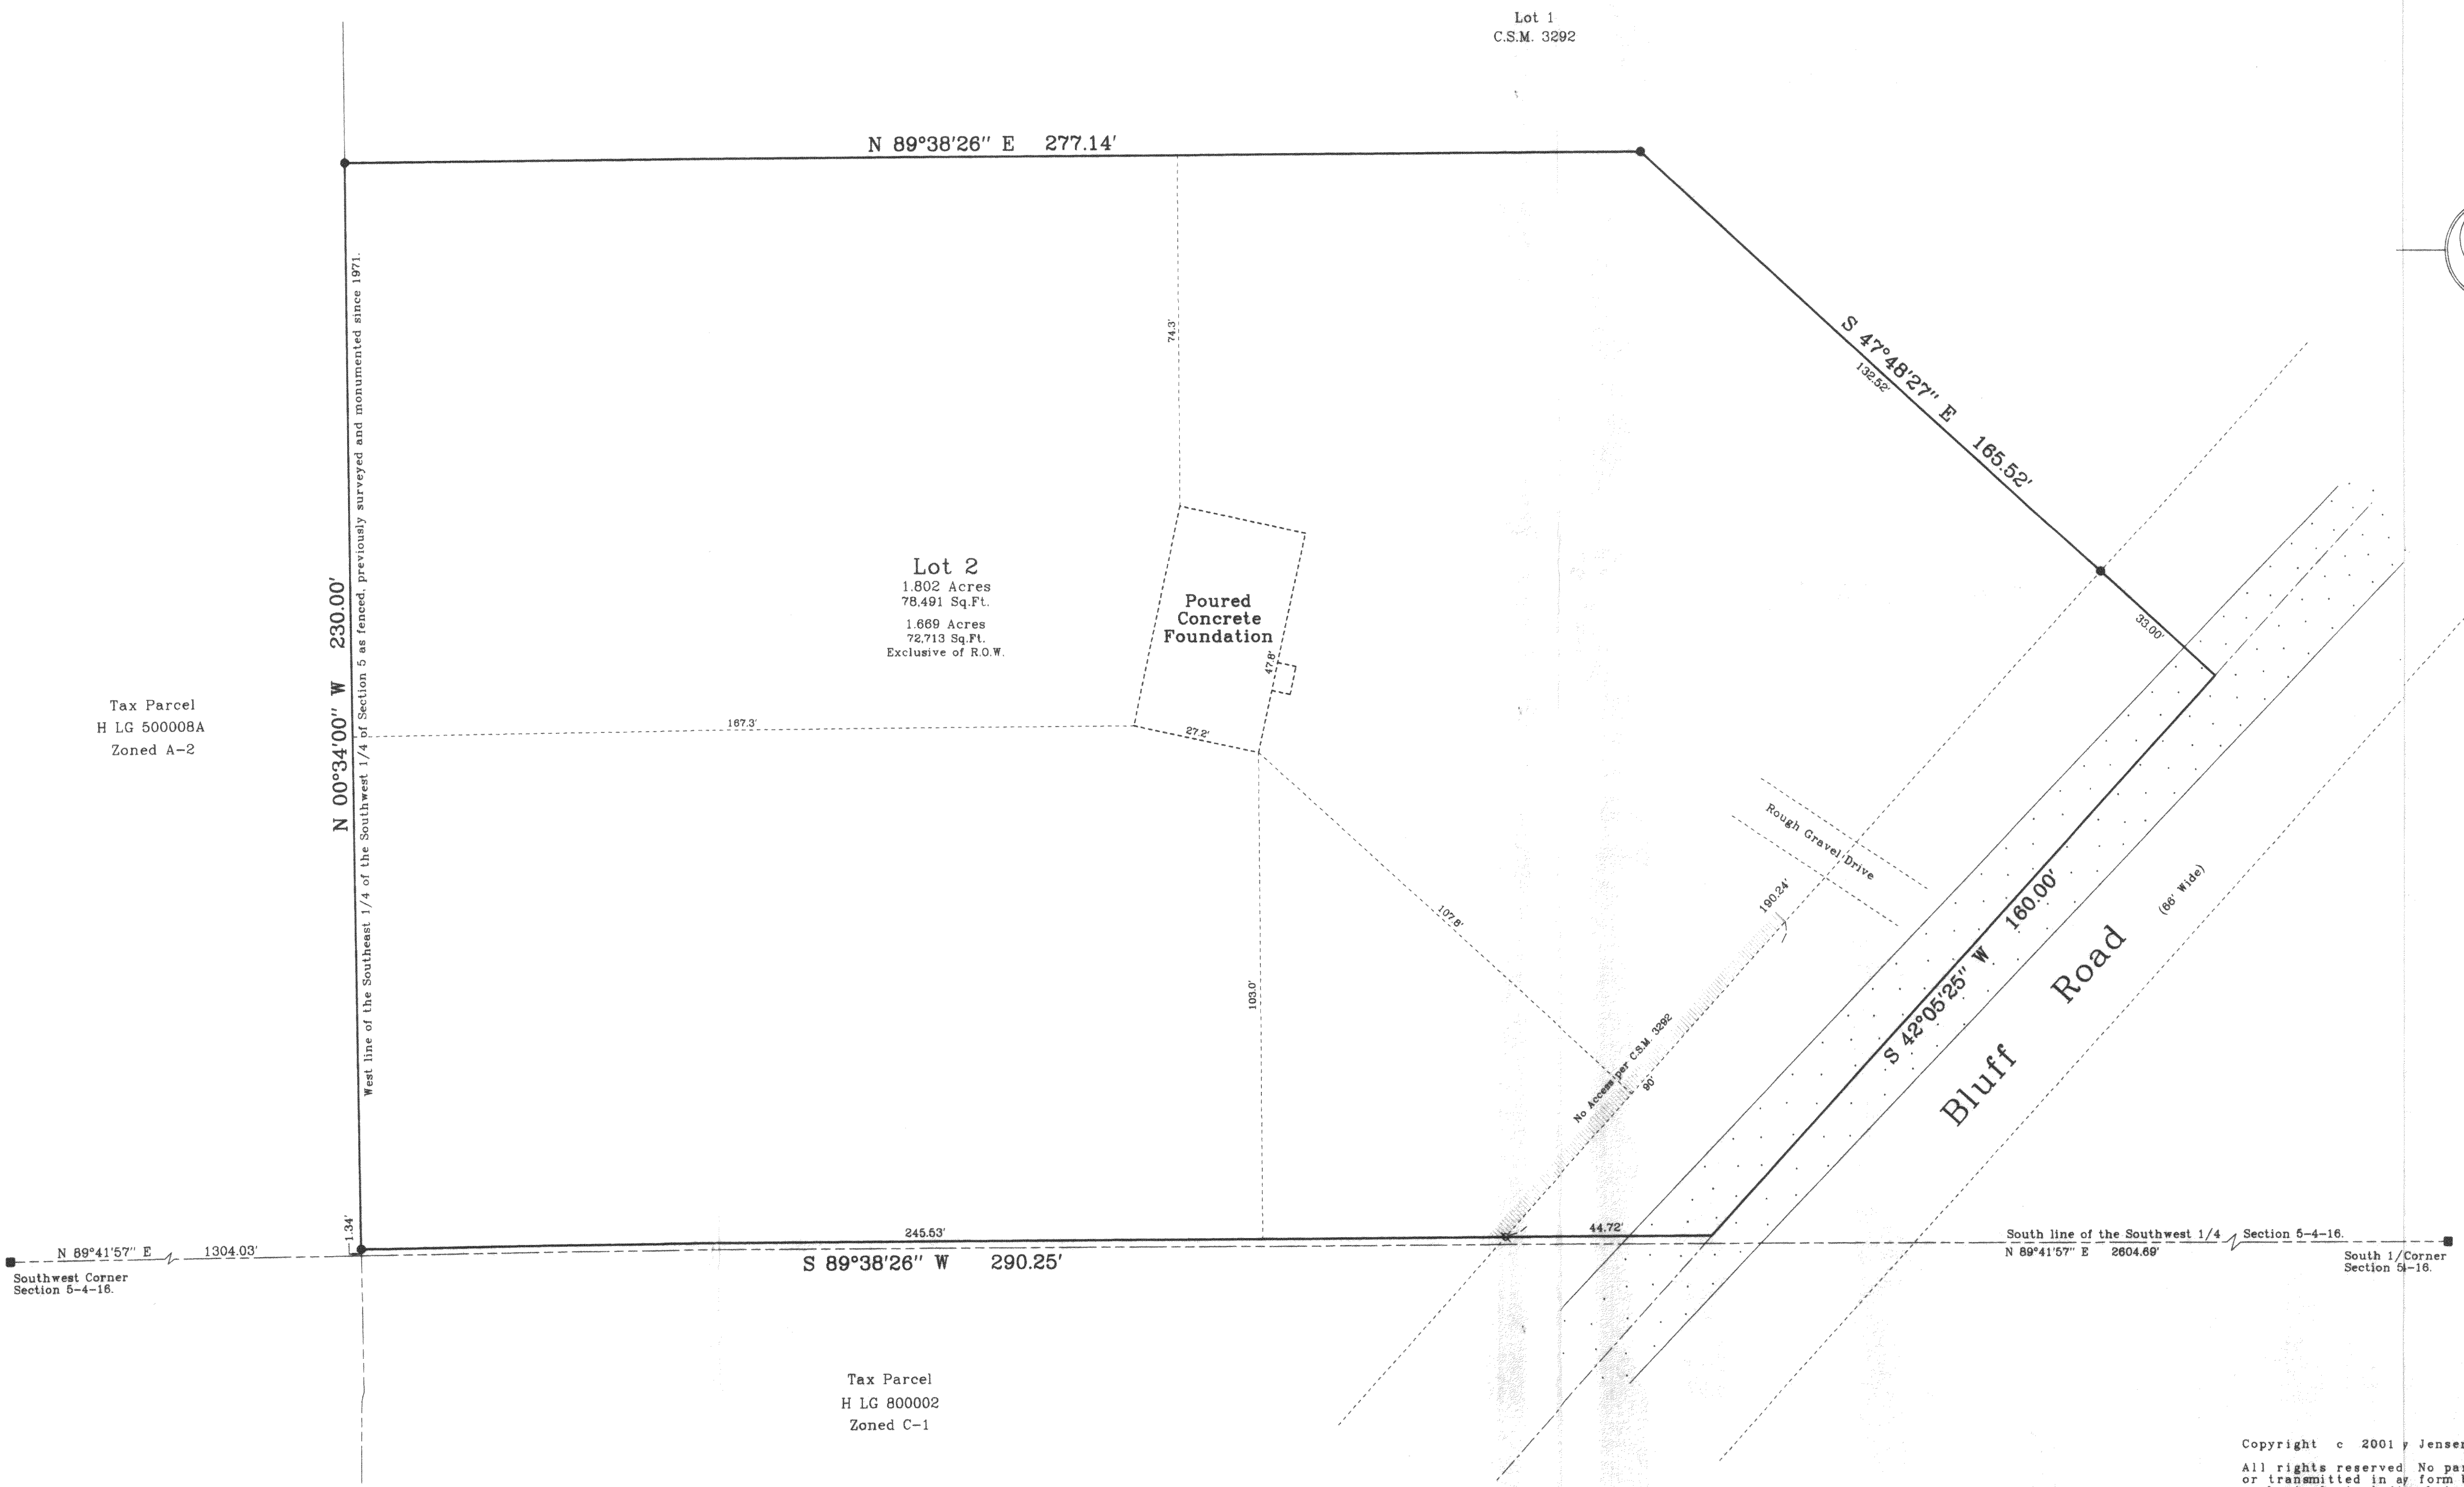

Copyright c 2001 y Jensen & Olson Land Surveying, LLC.
All rights reserved. No part of this survey plat may be reproduced
or transmitted in any form by any means - graphic, electronic, or
mechanical, including photocopying, tracing, or information storage
and retrieval systems - without permission in writing from Douglas
G. Olson, Jensen & Olson Land Surveying, LLC.

