


SITE, GRADING, DRAINAGE, & EROSION CONTROL PLAN

PART OF LOT 1 OF CERTIFIED SURVEY MAP NO. 813

LOCATED IN PART OF THE NW 1/4 OF SECTION 36 AND IN PART OF THE NE 1/4 OF SECTION 35,
ALL IN TOWN 4 NORTH, RANGE 16 EAST, WALWORTH COUNTY, WISCONSIN

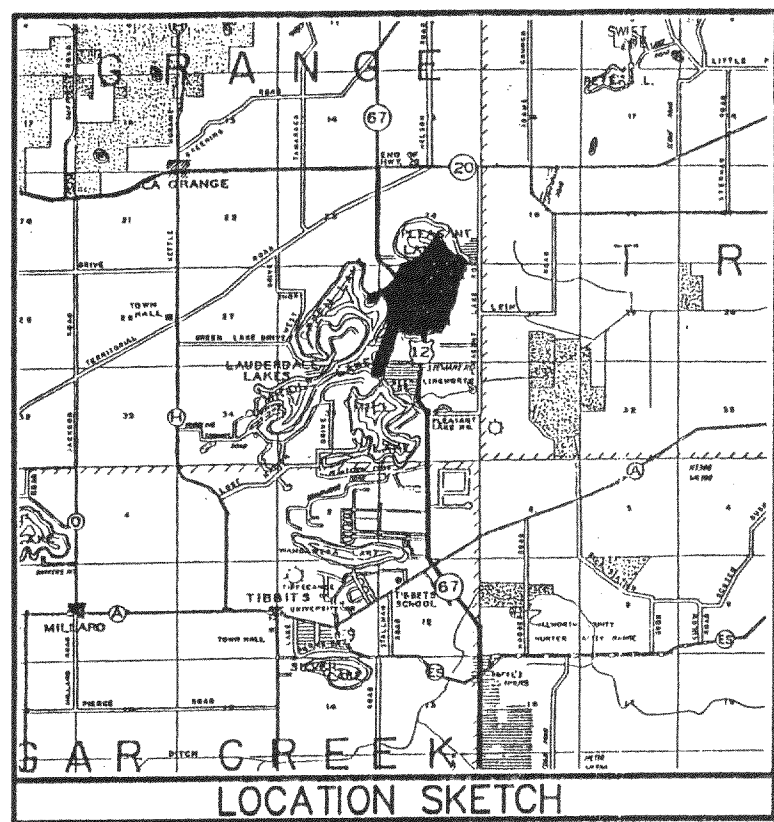

NOTE: ALL TOPSOIL EXCAVATION TO BE REMOVED FROM SITE ALONG WITH SURPLUS EXCAVATED MATERIAL. LANDSCAPING TO BE DONE WITH IMPORTED SCREENED TOPSOIL. ALL SLOPES OVER 8 TO 1 SHALL HAVE EROSION MATTING PLACED.

NEW ROADWAY CONSTRUCTION TO BE 8" GRAVEL BASE WITH 3" BITUMINOUS PAVEMENT. ALL PARKING AND DRIVE TO GARAGE SHALL BE PAVED.

EXISTING RESIDENCE IS PLANNED TO BE FULLY REMOVED AND REPLACED WITH NEW HOME SHOWN.

- LEGEND
- = FOUND IRON PIPE STAKE
 - = FOUND IRON REBAR STAKE
 - ⊞ = LAMP POLE LOCATED
 - = UTILITY POLE LOCATED
 - xxx--- = EXISTING CONTOURS
 - xxx— = PROPOSED CONTOURS
 - S— = PROPOSED SILT FENCE
 - {xxx} = RECORDED AS

SITE, GRADING, DRAINAGE,
& EROSION CONTROL PLAN

TOWN OF LA GRANGE, WALWORTH COUNTY, WISCONSIN

WORK ORDERED BY —
ELLEN FRYMIRE
1605 AUTUMN DRIVE
RACINE, WI 53402

FARRIS, HANSEN & ASSOCIATES, INC.
ENGINEERING — ARCHITECTURE — SURVEYING
7 RIDGWAY COURT P.O. BOX 437
ELKHORN, WISCONSIN 53121
OFFICE: (262) 723-2098 FAX: (262) 723-5886

REVISIONS
7/5/2001 — REVISED
ACCESS ROUTE AND
GRADES

PROJECT NO.
5659

DATE
05/25/2001

SHEET NO.
1 OF 1

NOTE: COPIES OF THIS MAP TO WHICH THE FOLLOWING
CERTIFICATE WILL APPLY SHOW SURVEYOR'S ORIGINAL SEAL AND
SIGNATURE IN RED INK. COPIES BY ANY OTHER MEANS MAY HAVE
ALTERATIONS WHICH DO NOT REPRESENT THE SURVEYOR'S WORK
PRODUCT.


I HEREBY CERTIFY THAT THE ABOVE DESCRIBED PROPERTY HAS
BEEN SURVEYED UNDER MY DIRECTION AND THAT THE ABOVE MAP
IS A TRUE REPRESENTATION THEREOF AND SHOWS THE SIZE AND
LOCATION OF THE PROPERTY AND ITS EXTERIOR BOUNDARIES.
THIS SURVEY IS MADE FOR THE USE OF THE PRESENT OWNERS OF
THE PROPERTY, AND ALSO THOSE WHO PURCHASE, MORTGAGE, OR
GUARANTEE THE TITLE THERETO WITHIN ONE YEAR FROM THE DATE
HEREOF.

DATED: 09-14-2000

PETER S. GORDON R.L.S. 2101

REVISED 07-05-2001 TO REMOVE BUILDABLE AREA RESTRICTION

REVISED 10-30-2002 TO SHOW SIZE & LOCATION OF
FOUNDATION AS BUILT

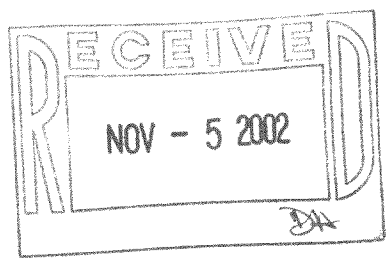

44813-1 416-137